


SEWER SERVICE TABLE

Upstream MH	Downstream MH	NUMBER	TYPE	LOCATION			FOR INFORMATION ONLY		
				LOT NO.	BLOCK NO.	LINE NO.	STATION \ DIRECTION	APPROXIMATE LENGTH 4" PIPE	
300'	75'	22	8" X 4" Tee	41	3	4	3+00/Rt. 2+99	12.0'	13.0'
224'	151'	23	8" X 4" Tee	40	3	4	3+75/Rt.	12.0'	13.0'
141'	234'	24	8" X 4" Tee	39	3	4	4+58/Rt. 4+58	12.0'	13.0'
61'	314'	25	8" X 4" Tee	38	3	4	5+38/Rt. 5+38	12.0'	13.0'
113'	16'	26	8" X 4" Tee	37	3	4	6+16/Rt. 6+16	12.0'	13.0'
45'	84'	27	8" X 4" Tee	36	3	4	6+84/Rt. 6+84	12.0'	13.0'
0'	0'	28	MH CONNECTION	50	3	4	9+61/Rt. 9+61	12.0'	11.0'
160'	143'	29	8" X 4" Tee	19	5	Exist	N/A	12.0'	26.0' Lt.
72'	231'	30	8" X 4" Tee	18	5	Exist	N/A	12.0'	26.0' Lt.
124'	41'	31	8" X 4" Tee	17	5	Exist	N/A	12.0'	26.0' Lt.

NOTE: Vertical Riser Pipe shall be extended to 2' minimum above ground water elevation and 4' maximum below proposed ground elevation.

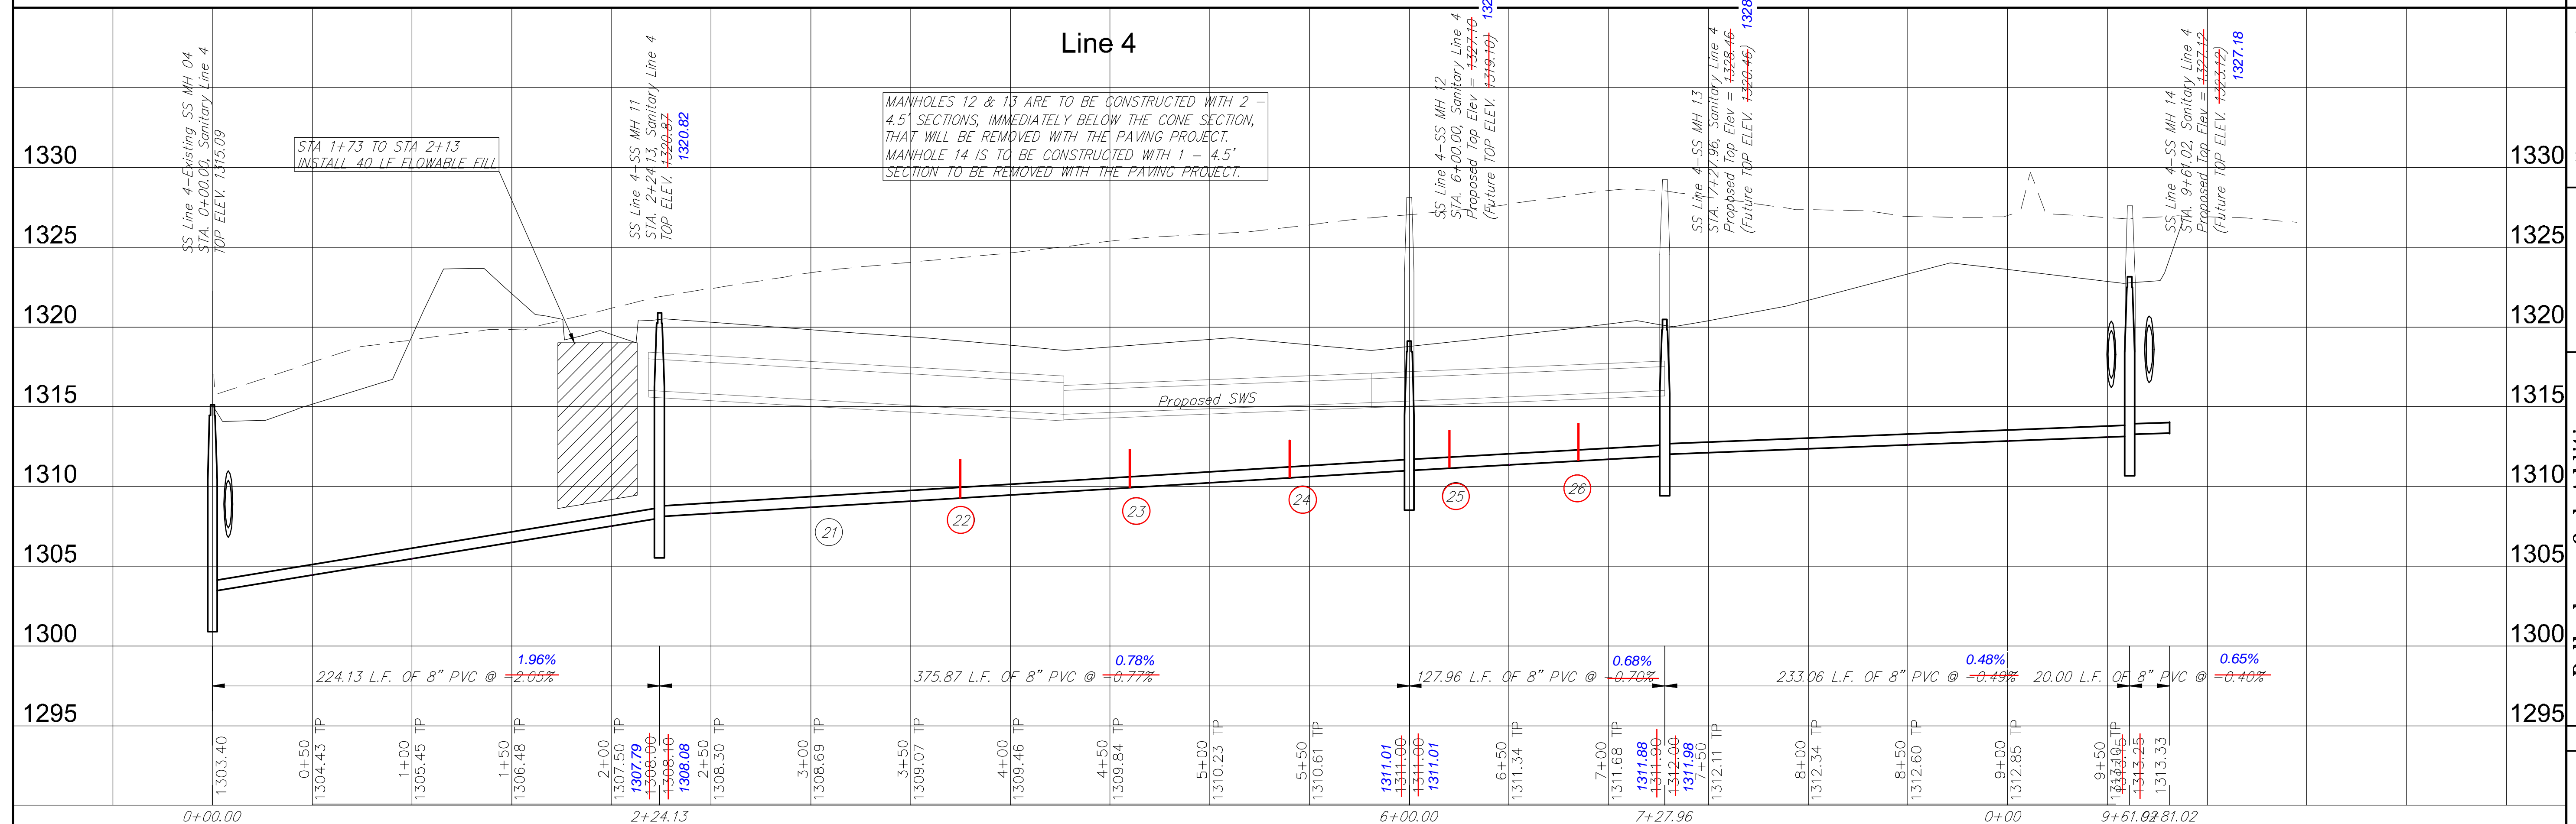

**RUGGLES BOHM**  
ENGINEERS ARCHITECTS LANDSCAPE ARCHITECTS

PROJECT NUMBER: 468-64858  
DRAWING FILE: Eng Base SS Line 1 & 1A

DESIGN EUG  
UTILITY

DATE: Feb. 5, 2013

REVIEW EUG  
REVIEW

Bellechase 3rd Addition  
SS LINE 4  
WICHITA, KANSAS

REVISION: APRIL 16, 2013

SHEET 15