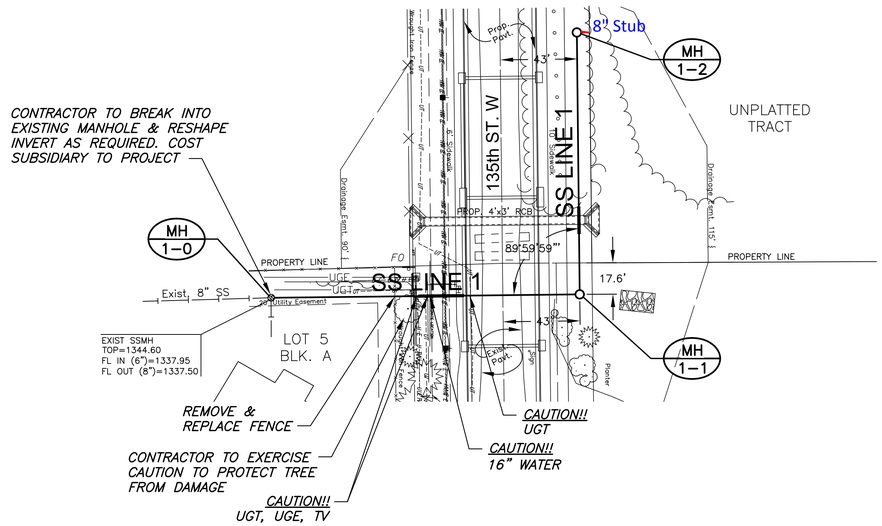

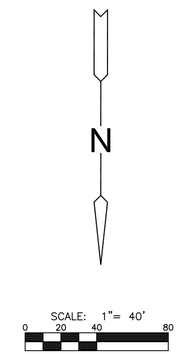

NOTE:
CONTRACTOR TO VERIFY THE DEPTH AND LOCATION OF EXISTING UTILITIES PRIOR TO CONSTRUCTION.

PLAN LINE 1

PROFILE LINE 1

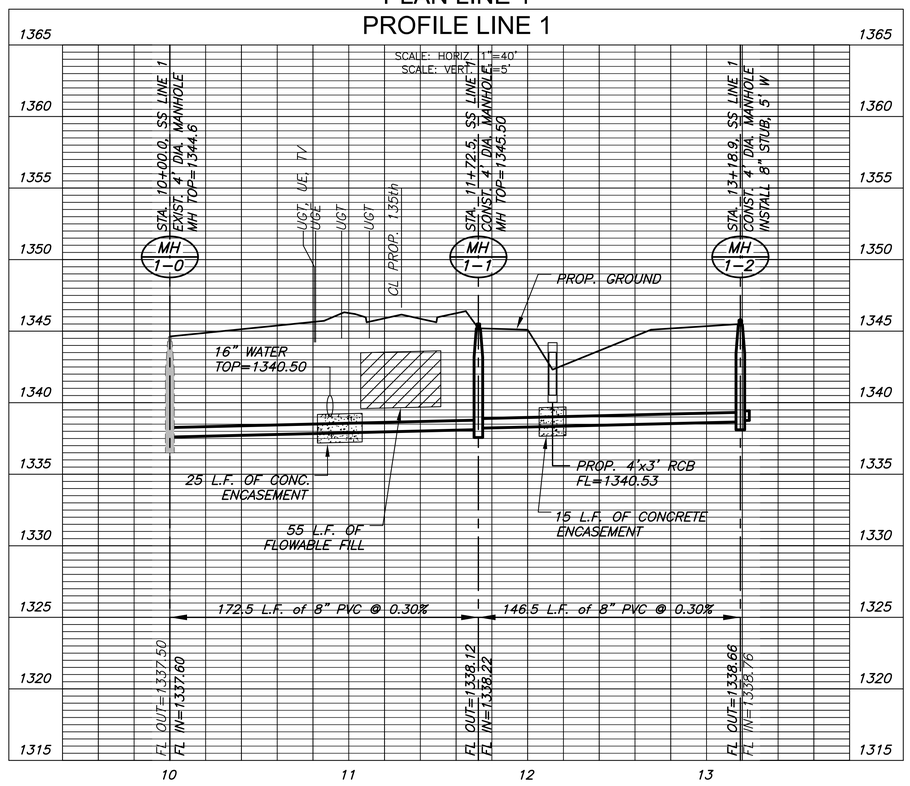

MKEC
Wichita, KS • 316-684-9600

SANITARY SEWER PLANS FOR

UNPLATTED TRACT - 135TH ST. W

LATERAL 61, CIS

©2013
MKEC Engineering
All Rights Reserved
www.mkec.com
These drawings and their contents, including, but not limited to, all concepts, designs, & ideas are the exclusive property of MKEC Engineering (MKEC), and may not be used or reproduced in any way without the express consent of MKEC.

LINE 1

PROJECT NO.	468-84886
DATE	AUGUST 2013
SCALE	AS SHOWN

DESIGNED	DRAWN	CHECKED
DFL	KKL	JAG

NO.	REVISION	DATE
#	-----	##/##/####

SHEET NO.

3 OF 8

PLOTTED: Thursday, August 08, 2013 @ 03:58PM

J:\PROJECTS\2013\130101\0292_PERFECTION_135TH\5-CIVIL\CAD\SAN\13292_B1.DWG