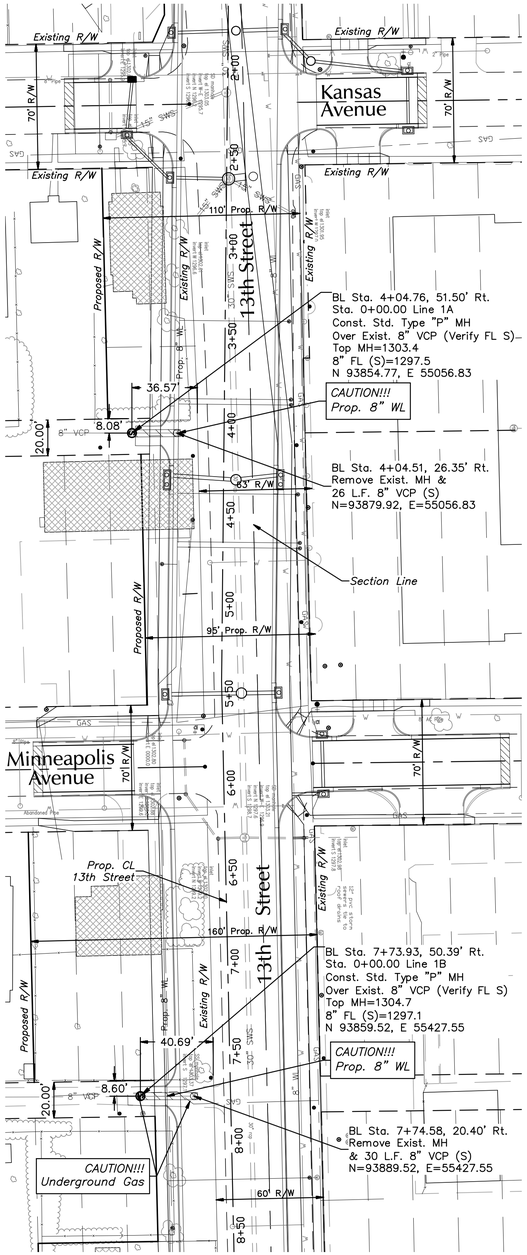

LINE #1A and #1B

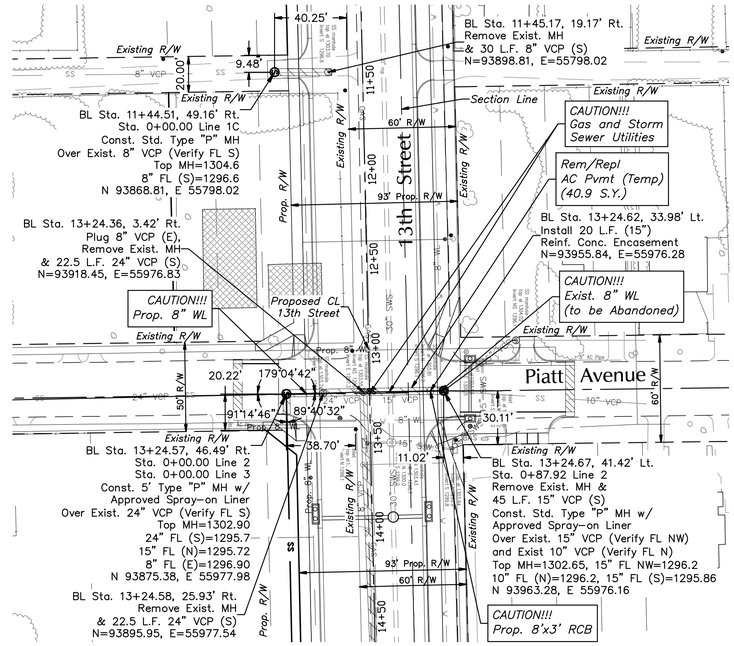

LINE #1C and #2

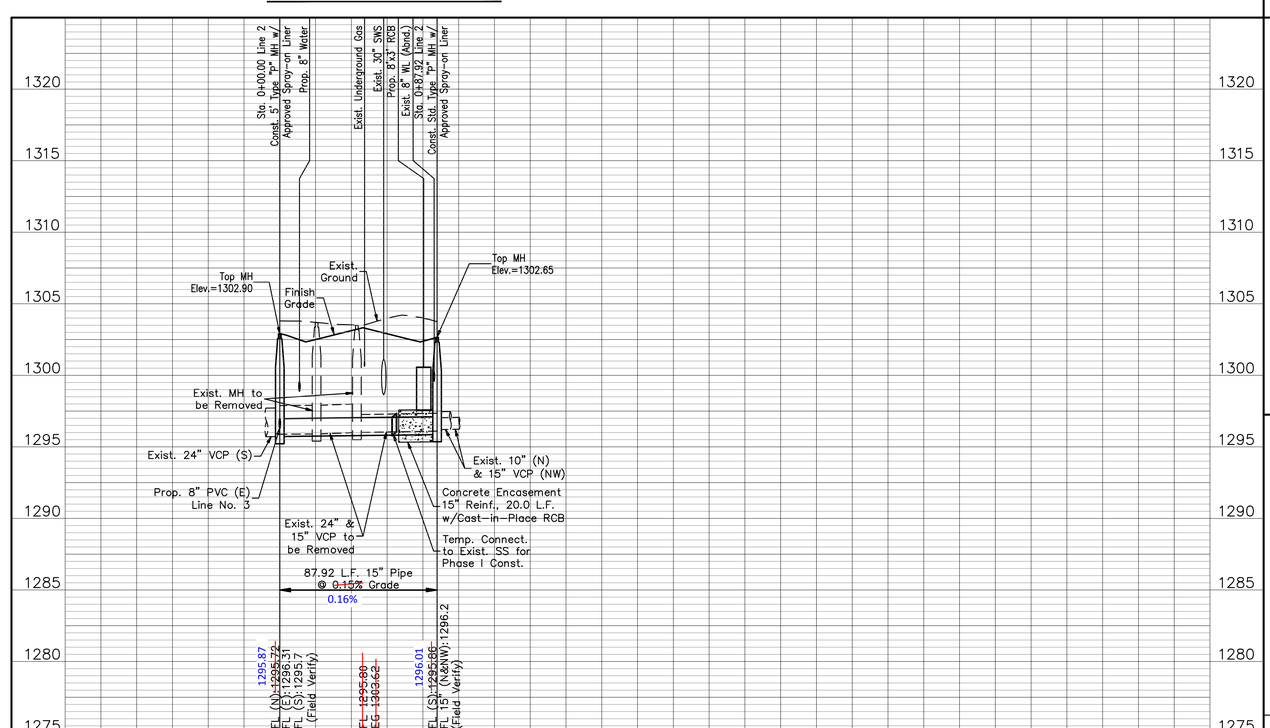

Remove Trees Only as Needed for Construction. Cost Shall be Subsidiary to Site Clearing.

LEGEND:

- Sanitary Sewer to be Abandoned in Place or Removed as Noted in Plan
- Existing Building to be Removed by Others

GRAPHIC SCALE

HORIZ. (IN FEET) 1 INCH = 40 FT. — 40 0 20 40 80

VERT. (IN FEET) 1 INCH = 5 FT. — 5 0

GENERAL NOTES

1. Contractor will be required to provide a minimum advance notice of twenty-four (24) hours to utility companies prior to starting any excavation as shown on paving general notes.

2. Existing utility lines and their location, as shown on the plans, represent the best information obtainable for design. The contractor will be required to work around existing utilities within the right-of-way which do not conflict with proposed construction.

3. The Contractor shall be responsible for maintaining continuous flow of sewage through construction. Contractor's proposed method for maintaining sewage flow shall be approved by the Engineer. Cost of maintaining flow of sewage through construction will not be paid for directly and this cost shall be considered as subsidiary to the other pay items of the work.

4. The Contractor shall be responsible for preserving property irons. The Contractor will be required to re-establish any property irons which are damaged or destroyed by his construction operations. Such irons shall be re-established by a licensed land surveyor in accordance with state laws.

5. Contractor shall vacuum test all manholes according to the City of Wichita standard specifications.

6. The tops of all Manholes to be set 0.4 feet above existing ground unless otherwise noted; set flush and match slope in street/sidewalk.

7. All areas disturbed by sewer construction, i.e. R/W, easements, and adjacent properties shall be restored with the same grass/sod as per AR 78.

8. Contractor shall maintain all existing BMP(s) on project site during construction. Contractor shall repair or replace any existing BMP(s) that are damaged (Cost subsidiary to site restoration). If BMP(s) were damaged prior to contractor beginning work on project, notify construction inspector or engineer.

No.	Date	By	Approved	Revision

13TH STREET NORTH FROM HYDRAULIC TO OLIVER
SANITARY SEWER EXTENSIONS
LINE NO. 1A, 1B, 1C, & 2
CITY OF WICHITA, KANSAS
JAMES L. ARMOUR, P.E. - CITY ENGINEER
C.O.W. Proj. No. 468-84816 OCA No. 7624100

POE & ASSOCIATES, INC.
CONSULTING ENGINEERS
5940 E. Central, Suite 200 ■ Wichita, KS 67208-4242
Phone 316/685-4111 ■ FAX 316/685-4444

FINAL

Designed By: J. DICKMAN
Drawn By: M. TUCKER
Poe Job No.: 1871A
Date: March 2012