

FHWA REGION NO.	STATE	PROJECT NO.	YEAR	SHEET NO.	TOTAL SHEETS
7	KANSAS	54-87 K-4445-01	1996	5	73

(mark one) ☐ Government Corner ☐ Traverse Point ☒ Baseline Point ☐ Other Control Pt. #1


City WICHITA County SEDGWICK State KANSAS
Section 23 Township 27S Range 1E 6th P.M.
Monument Title SG 163 KDOT designation _____
Project KELLOGG/OLIVER INTERCHANGE Date 2/4/92
Party Chief SLW

Record monument description: NONE

Monument Description: ☐ Found ☒ Set (describe method if set)
24" LONG #4 REBAR WITH 2" ALUM. DISC STAMPED "SG163"

Reference Ties: RANDOM LOCATION SELECTION (INTERVARIABLE WITH CONTROL PTS. #2 (SG164) & #3 (SG165))

- | Description | (Dist.) | (Chk'd) | Distance | Bearing |
|---|---------|---------|----------|---------|
| 1. 59' N. To CHIS. "4" ON T.O.C. ON N. SIDE KELLOGG | | | | |
| 2. 71' S. To CHIS. "4" ON T.O.C. ON S. SIDE KELLOGG @ APPROX. P.C. OF HILLSIDE EXIT RAMP | | | | |
| 3. 135' E. To CHIS. "4" ON STR. TOP N. WALL OF 2ND STORM DRAIN AREA WEST E. OF HILLSIDE BR. | | | | |
| 4. 43' W. To CHIS. "4" ON STR. TOP N. WALL OF 1ST STORM DRAIN AREA WEST E. OF HILLSIDE BR. | | | | |

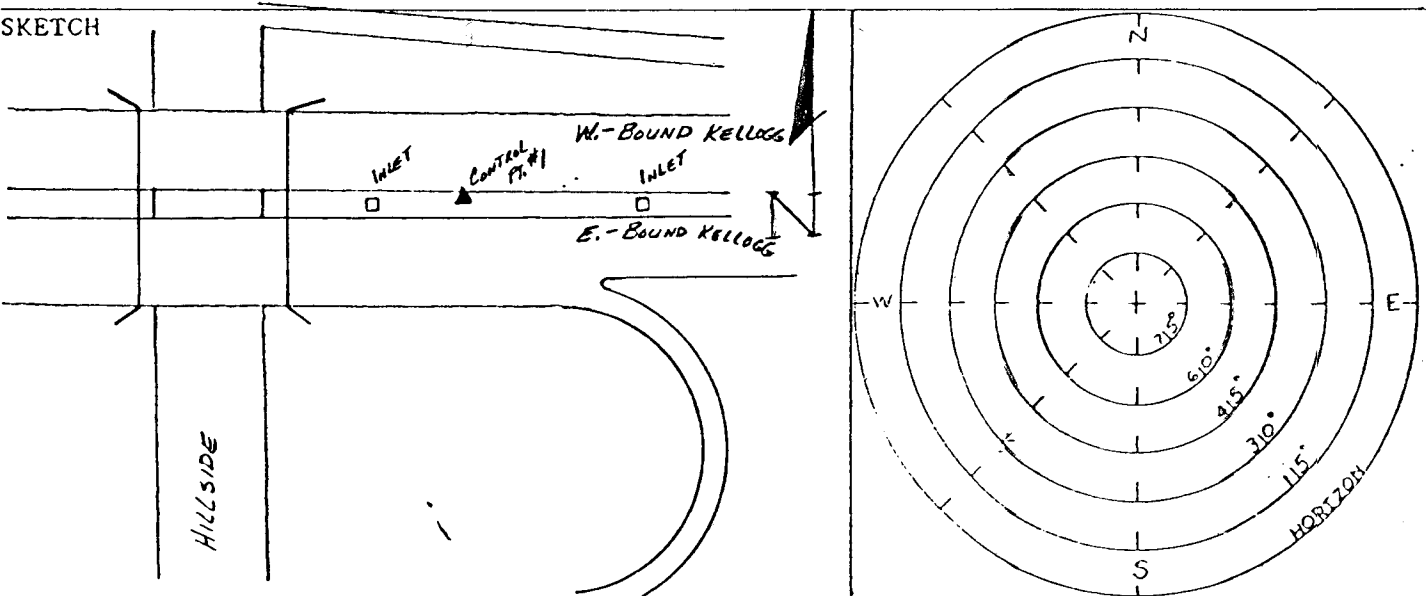

(mark one) ☐ Government Corner ☐ Traverse Point ☒ Baseline Point ☐ Other Control Pt. #4


City WICHITA County SEDGWICK State KANSAS
Section 25 Township 27S Range 1E 6th P.M.
Monument Title SG 166 KDOT designation _____
Project KELLOGG/OLIVER INTERCHANGE Date 2/4/92
Party Chief SLW

Record monument description: NONE

Monument Description: ☐ Found ☒ Set (describe method if set)
24" LONG #4 REBAR WITH 2" ALUM. DISC STAMPED "SG166"

Reference Ties: RANDOM LOCATION SELECTION (INTERVARIABLE WITH CONTROL PTS. #3 (SG165) & #5 (SG167))

- | Description | (Dist.) | (Chk'd) | Distance | Bearing |
|---|---------|---------|----------|---------|
| 1. 72' N. To CHIS. "4" ON T.O.C. ON S. SIDE E-BOUND KELLOGG | | | | |
| 2. 135' SW. To CHIS. "4" ON TOP W. EDGE CONC. L.P. BASE 2' TALL | | | | |
| 3. 44' WNW. To PK. N. 43' (116') IN N. FACE R.P. | | | | |

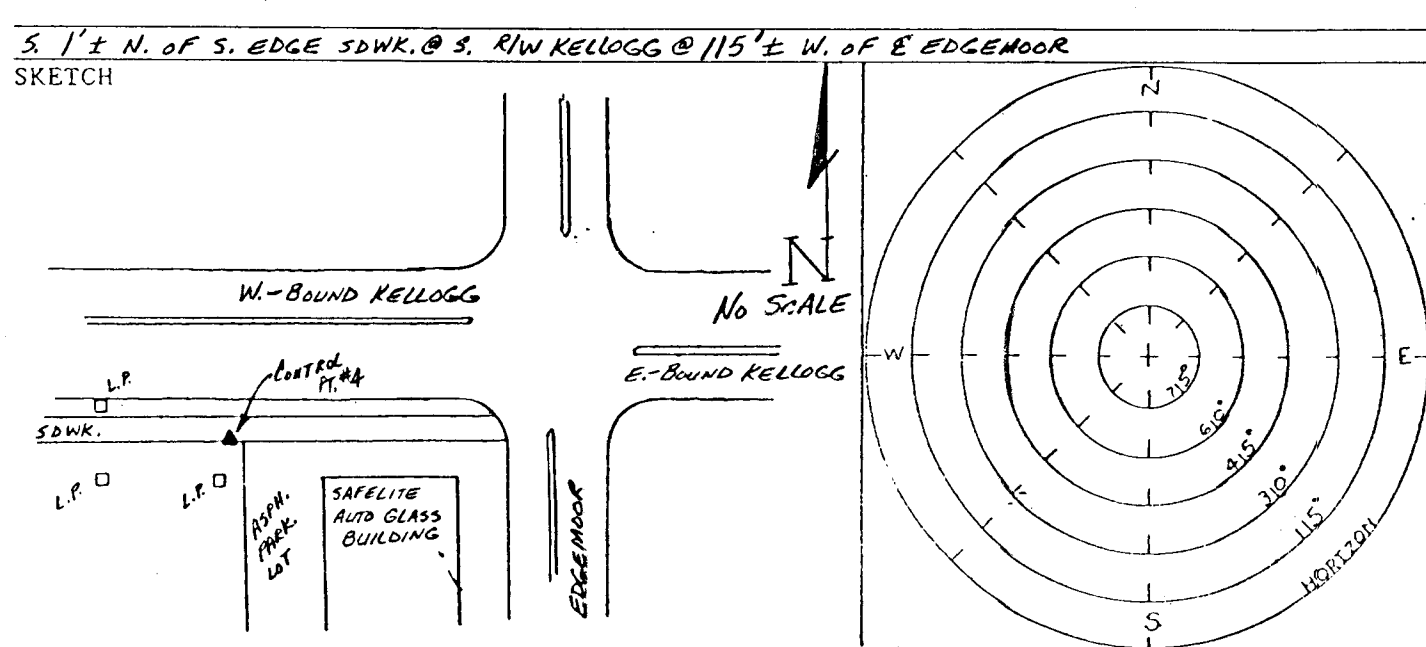

(mark one) ☐ Government Corner ☐ Traverse Point ☒ Baseline Point ☐ Other Control Pt. #2


City WICHITA County SEDGWICK State KANSAS
Section 26 Township 27S Range 1E 6th P.M.
Monument Title SG 164 KDOT designation _____
Project KELLOGG/OLIVER INTERCHANGE Date 2/4/92
Party Chief SLW

Record monument description: NONE

Monument Description: ☐ Found ☒ Set (describe method if set)
2" ALUM. DISC STAMPED "SG164"

Reference Ties: RANDOM LOCATION SELECTION (INTERVARIABLE WITH CONTROL PTS. #1 (SG163) & #3 (SG165))

- | Description | (Dist.) | (Chk'd) | Distance | Bearing |
|--|---------|---------|----------|---------|
| 1. 60' S. To CHIS. "4" ON N. NOSE MEDIAN TRAFFIC ISLAND IN ROOSEVELT ST. | | | | |
| 2. 24' ESE. To CHIS. "4" ON T.O.C. IN SE. COR. RD. INTX. OF ROOSEVELT & KELLOGG STREETS | | | | |
| 3. 283' WSW. To CHIS. "4" ON T.O.C. IN SW. COR. RD. INTX. OF ROOSEVELT & KELLOGG STREETS | | | | |
| 4. 213' N. To PK. N. 43' ON N. EDGE DRIVING SURFACE OF E-BOUND KELLOGG | | | | |

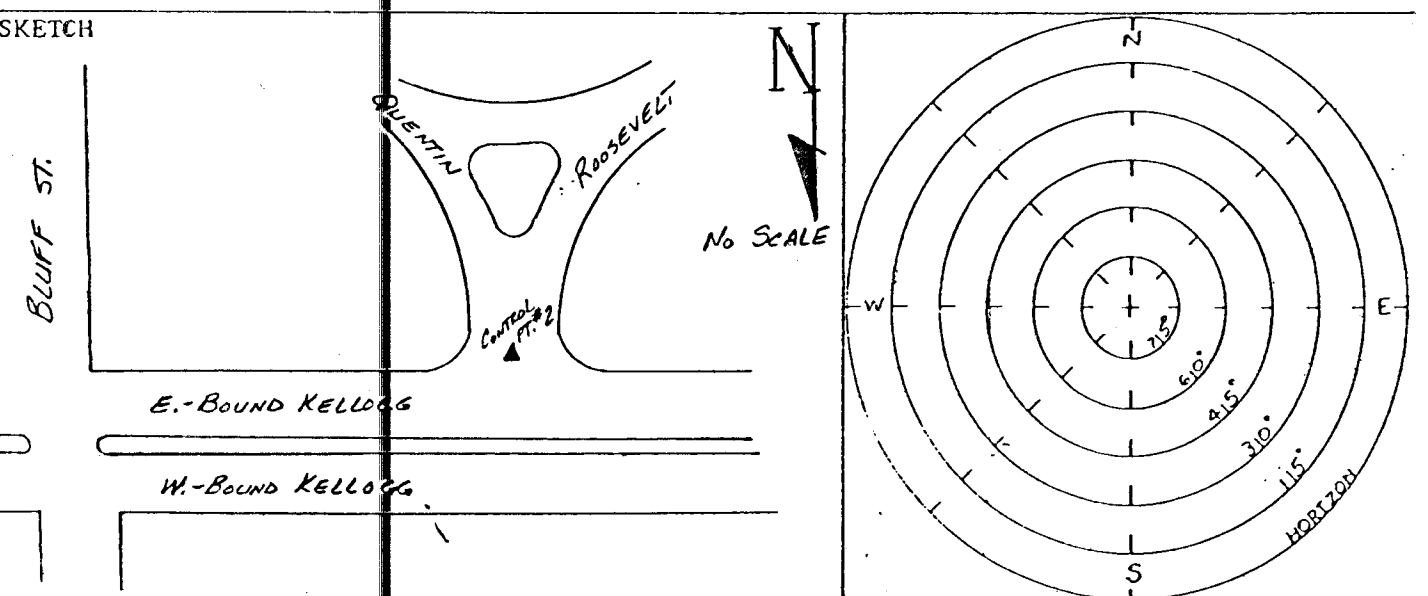

(mark one) ☐ Government Corner ☐ Traverse Point ☒ Baseline Point ☐ Other Control Pt. #5


City WICHITA County SEDGWICK State KANSAS
Section 24 Township 27S Range 1E 6th P.M.
Monument Title SG 167 KDOT designation _____
Project KELLOGG/OLIVER INTERCHANGE Date 2/4/92
Party Chief SLW

Record monument description: NONE

Monument Description: ☐ Found ☒ Set (describe method if set)
24" LONG #4 REBAR WITH ALUM. DISC STAMPED "SG167"

Reference Ties: RANDOM LOCATION SELECTION (INTERVARIABLE WITH CONTROL PTS. #4 (SG166) & #3 (SG165))

- | Description | (Dist.) | (Chk'd) | Distance | Bearing |
|--|---------|---------|----------|---------|
| 1. 28' N. To CHIS. "4" ON T.O.C. OF S. FRONTAGE RD. ON S. SIDE KELLOGG | | | | |
| 2. 53' W. To CHIS. "4" ON T.O.C. OF S. FRONTAGE RD. ON S. SIDE KELLOGG BETWEEN ENTRANCES TO RED CARPET CAR WASH | | | | |
| 3. 84' E. To CHIS. "4" ON S. T.O.C. OF S. FRONTAGE RD. ON S. SIDE KELLOGG BETWEEN ENTRANCES TO RED CARPET CAR WASH | | | | |
| 4. S. To CHIS. "4" ON NW. COR. CONC. EXIT APRON FROM RED CARPET CAR WASH | | | | |

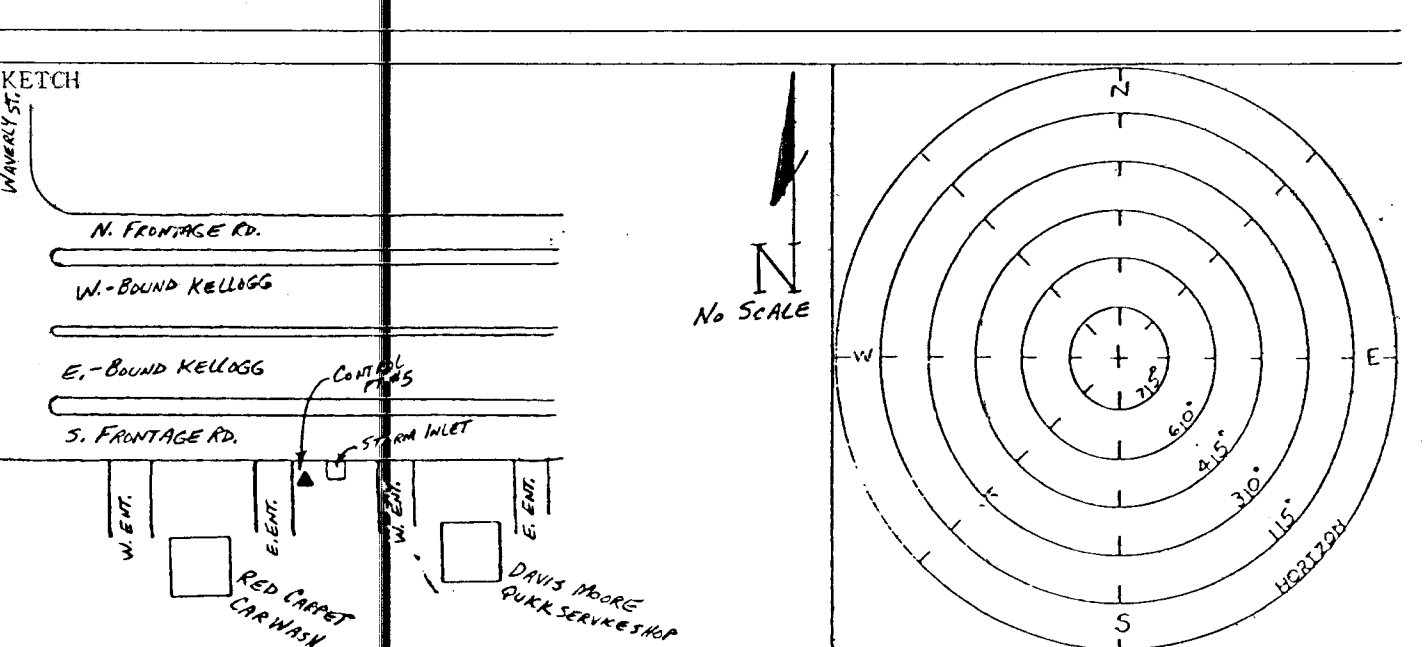

(mark one) ☐ Government Corner ☐ Traverse Point ☒ Baseline Point ☐ Other Control Pt. #3


City WICHITA County SEDGWICK State KANSAS
Section 26 Township 27S Range 1E 6th P.M.
Monument Title SG 165 KDOT designation _____
Project KELLOGG/OLIVER INTERCHANGE Date 2/4/92
Party Chief SLW

Record monument description: NONE

Monument Description: ☐ Found ☒ Set (describe method if set)
24" LONG #4 REBAR WITH 2" ALUM. DISC STAMPED "SG165"

Reference Ties: RANDOM LOCATION SELECTION (INTERVARIABLE WITH CONTROL PTS. #2 (SG164) & #4 (SG166))

- | Description | (Dist.) | (Chk'd) | Distance | Bearing |
|--|---------|---------|----------|---------|
| 1. 43' W. To CHIS. "4" ON T.O.C. @ SE. COR. RD. INTX. OF DELLORE & KELLOGG STREETS | | | | |
| 2. 63' N. To CHIS. "4" ON T.O.C. ON S. SIDE E-BOUND KELLOGG | | | | |
| 3. 56' S. To CHIS. "4" ON T.O.C. ON N. SIDE ASPH. PARK LOT | | | | |
| 4. 23' ESE. To CHIS. "4" ON TOP NW. COR. 2' SQ. CONC. L.P. BASE 2' TALL | | | | |
| 5. 1' ± S. OF N. EDGE SDWK. @ S. RW KELLOGG @ 60' ± E. OF E. DELLORE | | | | |

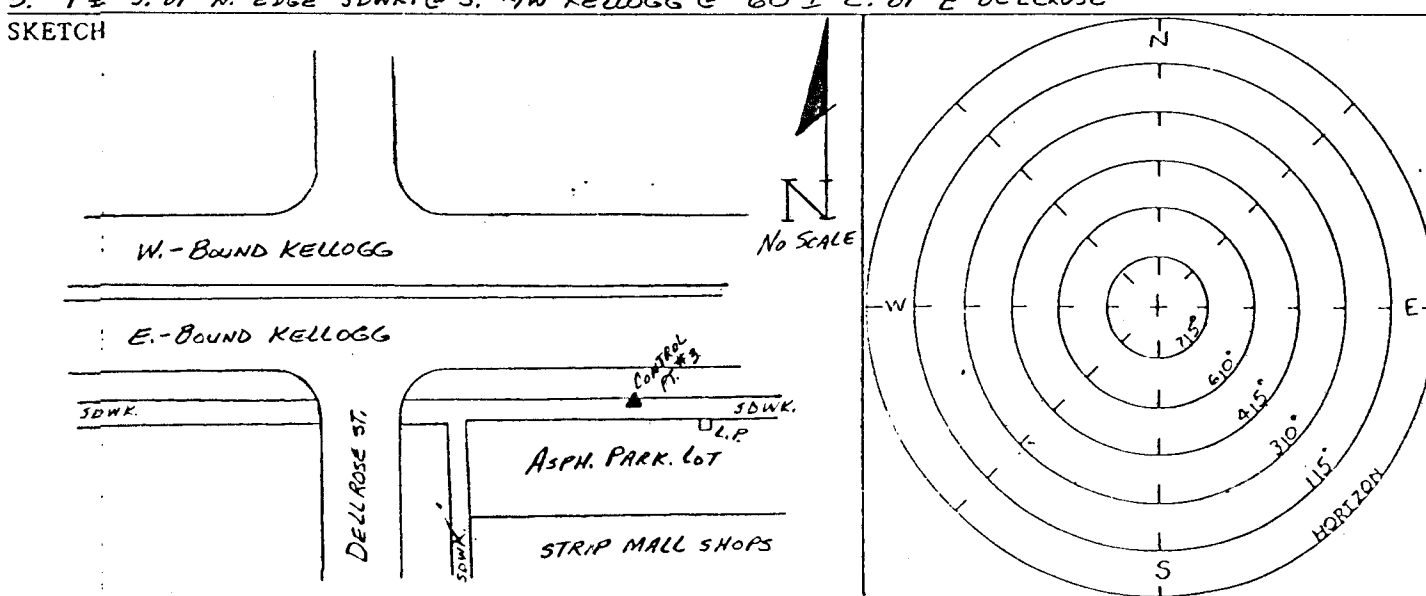

VERTICAL:

DATUM BENCHMARK: U.S.C. & G.S. BENCHMARK A-237 M.S.L. ELEVATION 1316.608

At Wichita, 10.4 feet South of the Northwest corner of the Union Station, 28 feet East of the East rail of the East track, 2.3 feet above the ground, 3 1/2 rails South of the centerline of the Douglas Avenue viaduct, set vertically in the West wall of the Railroad Station, in Section 21, Township 27 South, Range 1 East of the 6th P.M.

HORIZONTAL:

G.P.S. CONTROL POINTS: (ALONG KELLOGG MAIN LINE)

CONTROL POINT #1 24 INCH LONG #4 REBAR WITH 2 INCH ALUMINUM DISC STAMPED "SG163" NORTHING: 1683523.054 EASTING: 1660436.835 FOR TIES SEE HORIZONTAL FOLDER PAGE 51

CONTROL POINT #2 24 INCH LONG #4 REBAR WITH 2 INCH ALUMINUM DISC STAMPED "SG164" NORTHING: 1683433.460 EASTING: 1662211.797 FOR TIES SEE HORIZONTAL FOLDER PAGE 52

CONTROL POINT #3 24 INCH LONG #4 REBAR WITH 2 INCH ALUMINUM DISC STAMPED "SG165" NORTHING: 1683482.445 EASTING: 1665178.745 FOR TIES SEE HORIZONTAL FOLDER PAGE 53

CONTROL POINT #4 24 INCH LONG #4 REBAR WITH 2 INCH ALUMINUM DISC STAMPED "SG166" NORTHING: 1683523.087 EASTING: 1667959.047 FOR TIES SEE HORIZONTAL FOLDER PAGE 54

CONTROL POINT #5 24 INCH LONG #4 REBAR WITH 2 INCH ALUMINUM DISC STAMPED "SG167" NORTHING: 1683508.689 EASTING: 1669392.729 FOR TIES SEE HORIZONTAL FOLDER PAGE 55

3					
2					
1					
NO.	DATE	REVISIONS	BY	APP'D	
CITY OF WICHITA					
SURVEY CONTROL POINTS					
SHEET NO.	OF	SCALE	APP'D		
DESIGNED		DETAILED	QUANTITIES	TRACED	
DESIGN CK.		DETAIL CK.	QUAN. CK.	TRACE CK.	

Design Filename: h:\5630\detail\kabor.dgn

Plotted on: 03-OCT-1995 08:24

imr:ls 5