CORPS OF ENGINEERS

U.S. ARMY

REVISIONS			
DATE	DESCRIPTION	CHKD.	REC.	APPR.
6-9-53	△ Section A-A added, Section G-G and Detail "C" revised.			

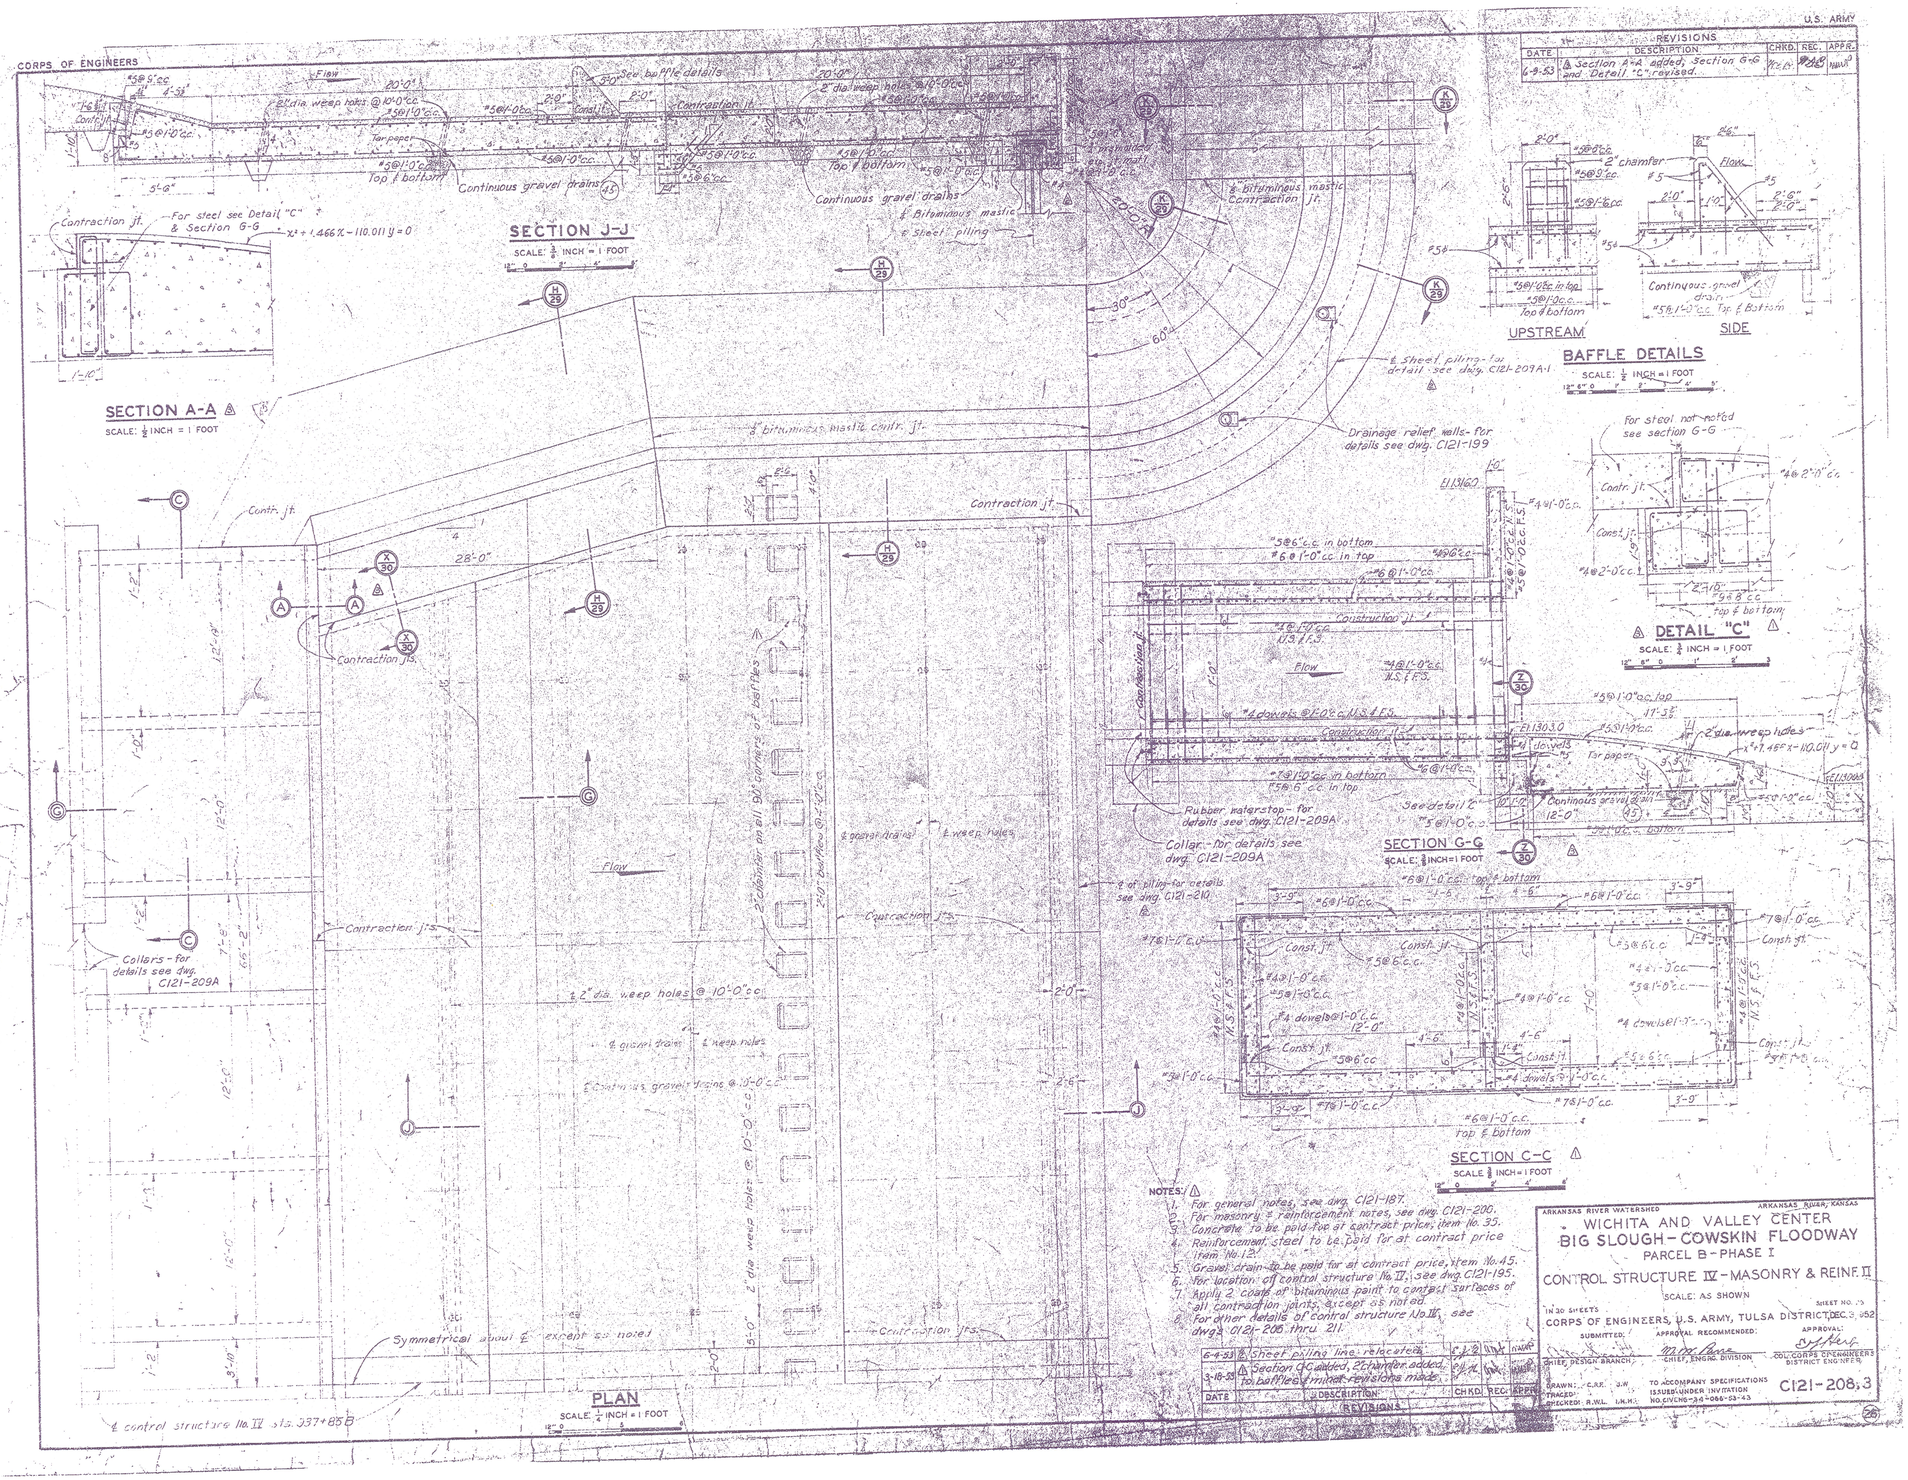

NOTES: △

1. For general notes, see dwg. C121-187.
2. For masonry & reinforcement notes, see dwg. C121-200.
3. Concrete to be paid for at contract price, item No. 35.
4. Reinforcement steel to be paid for at contract price item No. 12.
5. Gravel drain to be paid for at contract price, item No. 45.
6. For location of control structure No. IV, see dwg. C121-195.
7. Apply 2 coats of bituminous paint to contact surfaces of all contraction joints, except as noted.
8. For other details of control structure No. IV, see dwg. C121-206 thru 211.

DATE	DESCRIPTION	CHKD.	REC.	APPR.
6-4-53	△ Sheet piling line relocated.			
3-18-53	△ Section G-G added, 2 chamfer added to baffles & minor revisions made.			

REVISIONS

ARKANSAS RIVER WATERSHED — ARKANSAS RIVER, KANSAS

WICHITA AND VALLEY CENTER
BIG SLOUGH - COWSKIN FLOODWAY
PARCEL B - PHASE I

CONTROL STRUCTURE IV - MASONRY & REINF. II

SCALE: AS SHOWN

IN 30 SHEETS — SHEET NO. 13

CORPS OF ENGINEERS, U.S. ARMY, TULSA DISTRICT, DEC. 3, 1952

SUBMITTED: CHIEF, DESIGN BRANCH — APPROVAL RECOMMENDED: CHIEF, ENGINEERING DIVISION — APPROVAL: COL. CORPS OF ENGINEERS, DISTRICT ENGINEER

DRAWN: C.R.F. J.W.
TRACED:
CHECKED: R.W.L. I.N.M.

TO ACCOMPANY SPECIFICATIONS 13 SUBMITTED UNDER INVITATION NO. DACW-36-066-53-43

C121-208.3