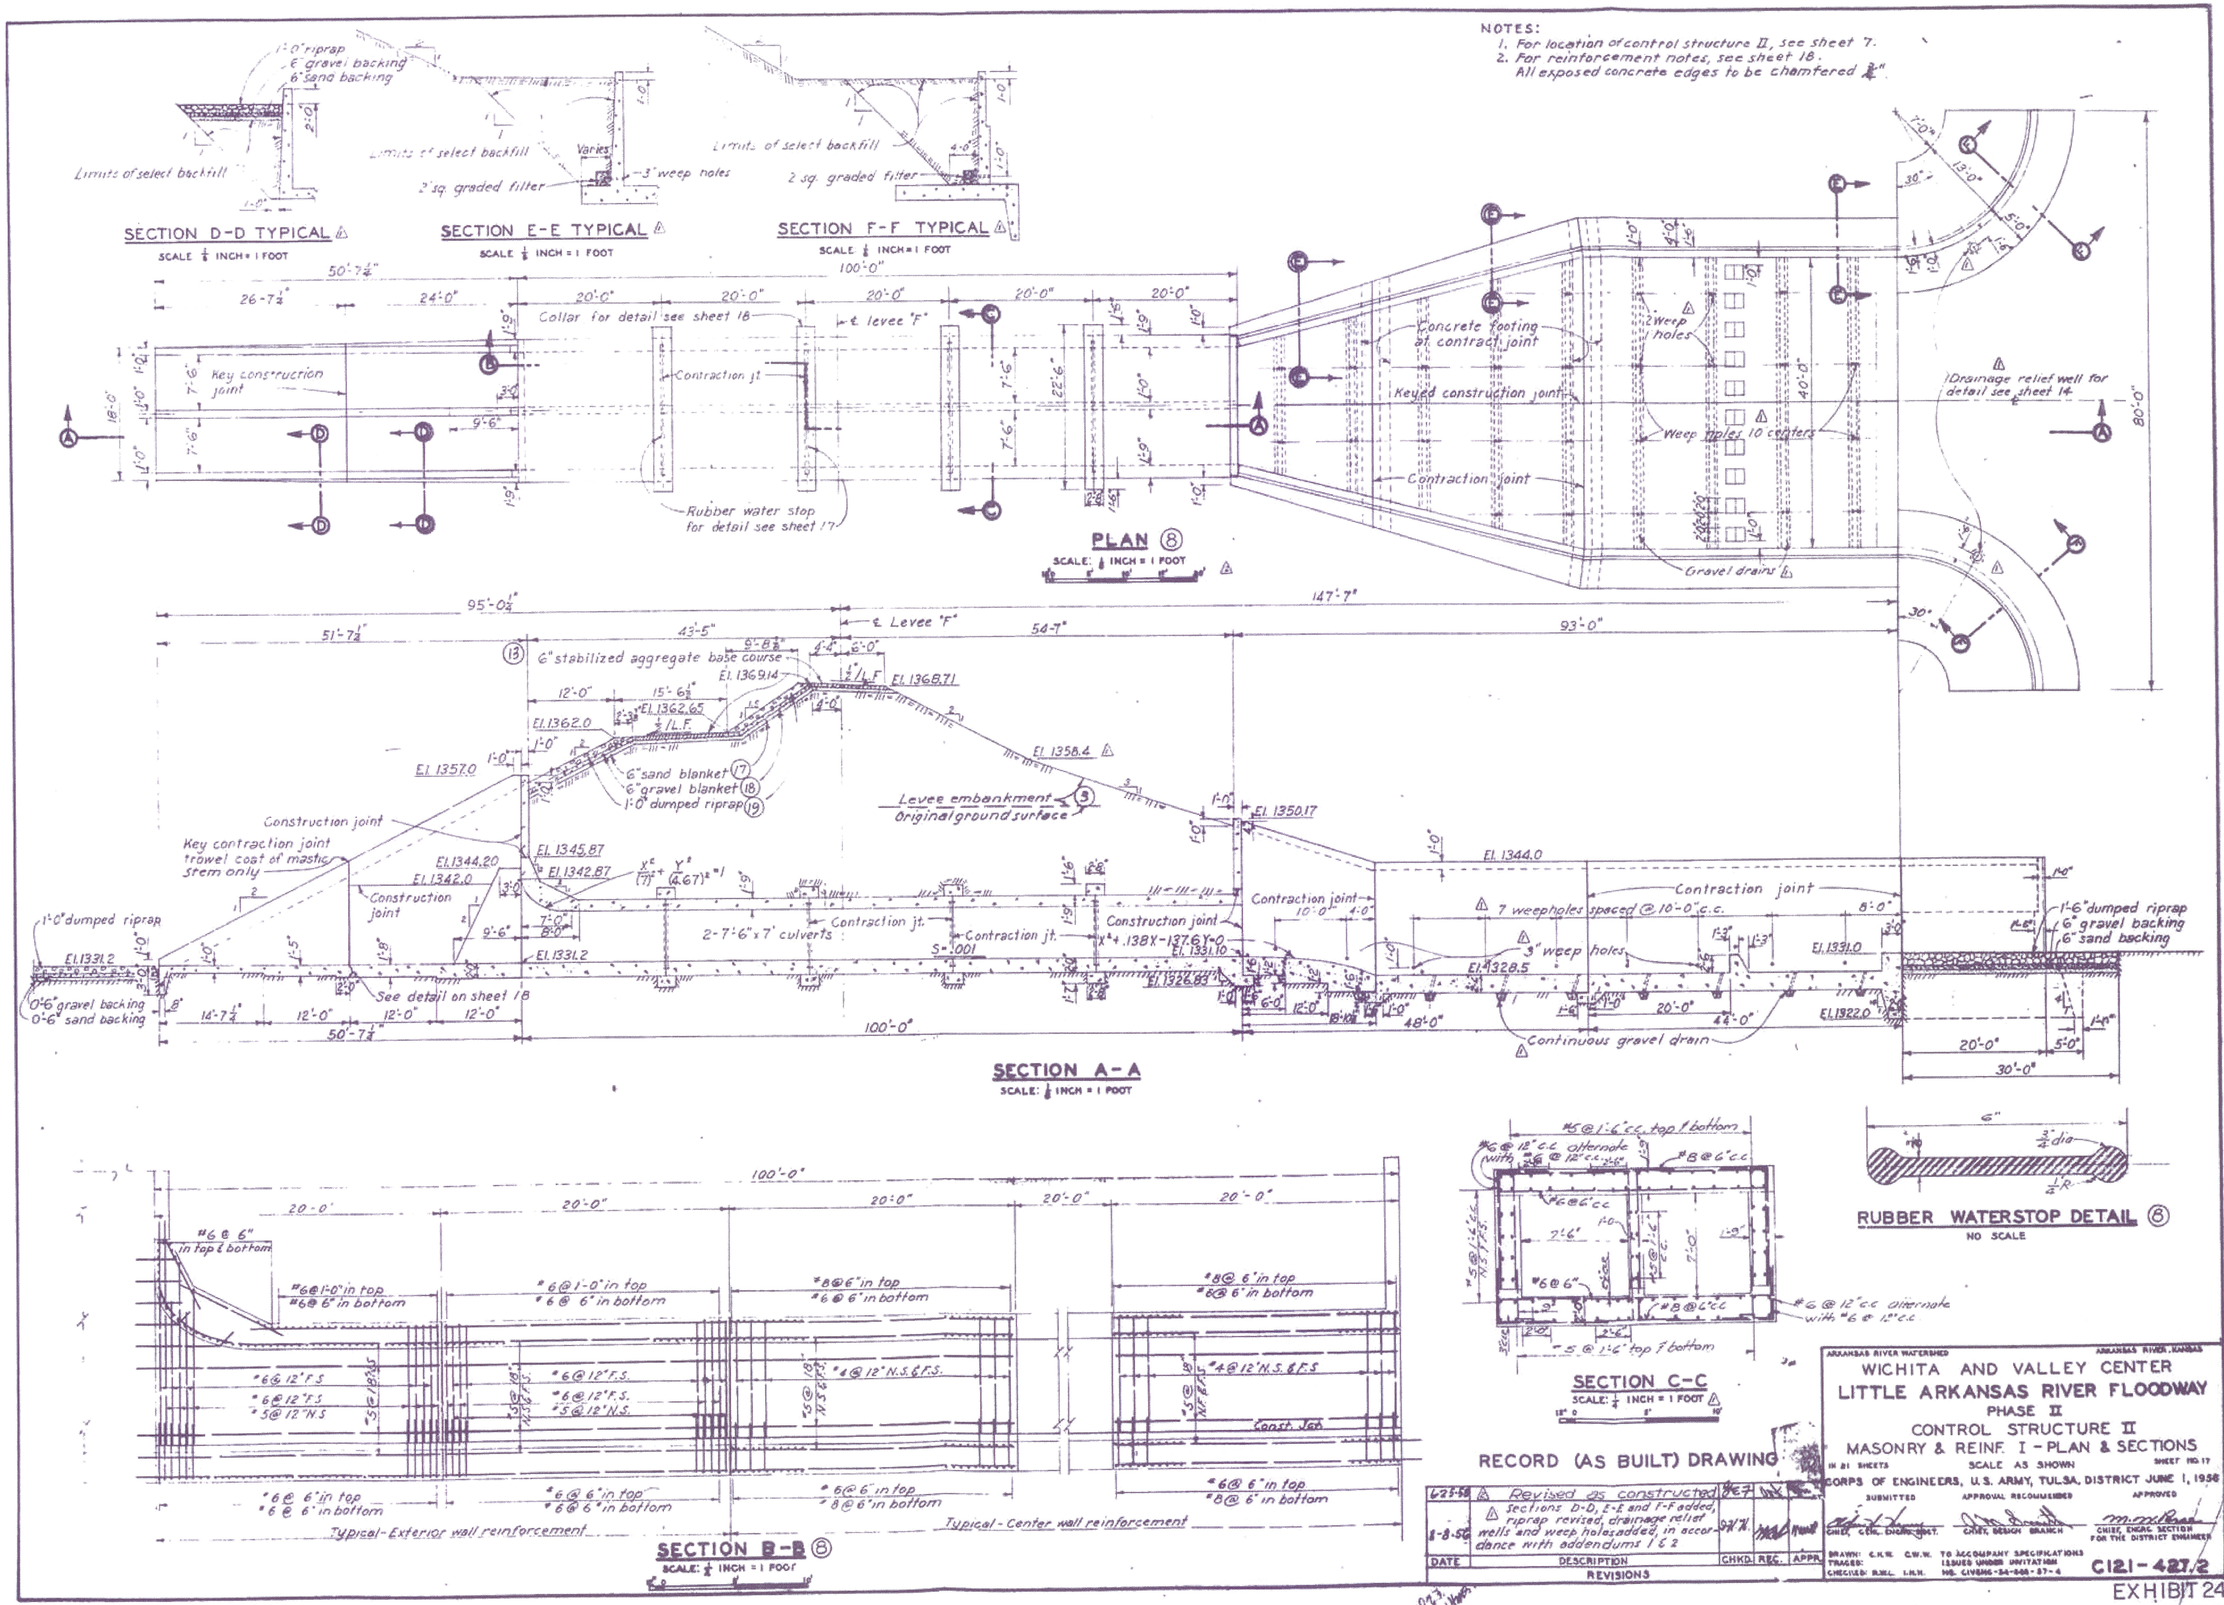NOTES:
1. For location of control structure II, see sheet 7.
2. For reinforcement notes, see sheet 18.
All exposed concrete edges to be chamfered ¾".