


FHWA REGION NO.	STATE	PROJECT NO.	FISCAL YEAR	SHEET NO.	TOTAL SHEETS
7	KANSAS	87-N-0225-01	2002	32	47

Scale: 1:500

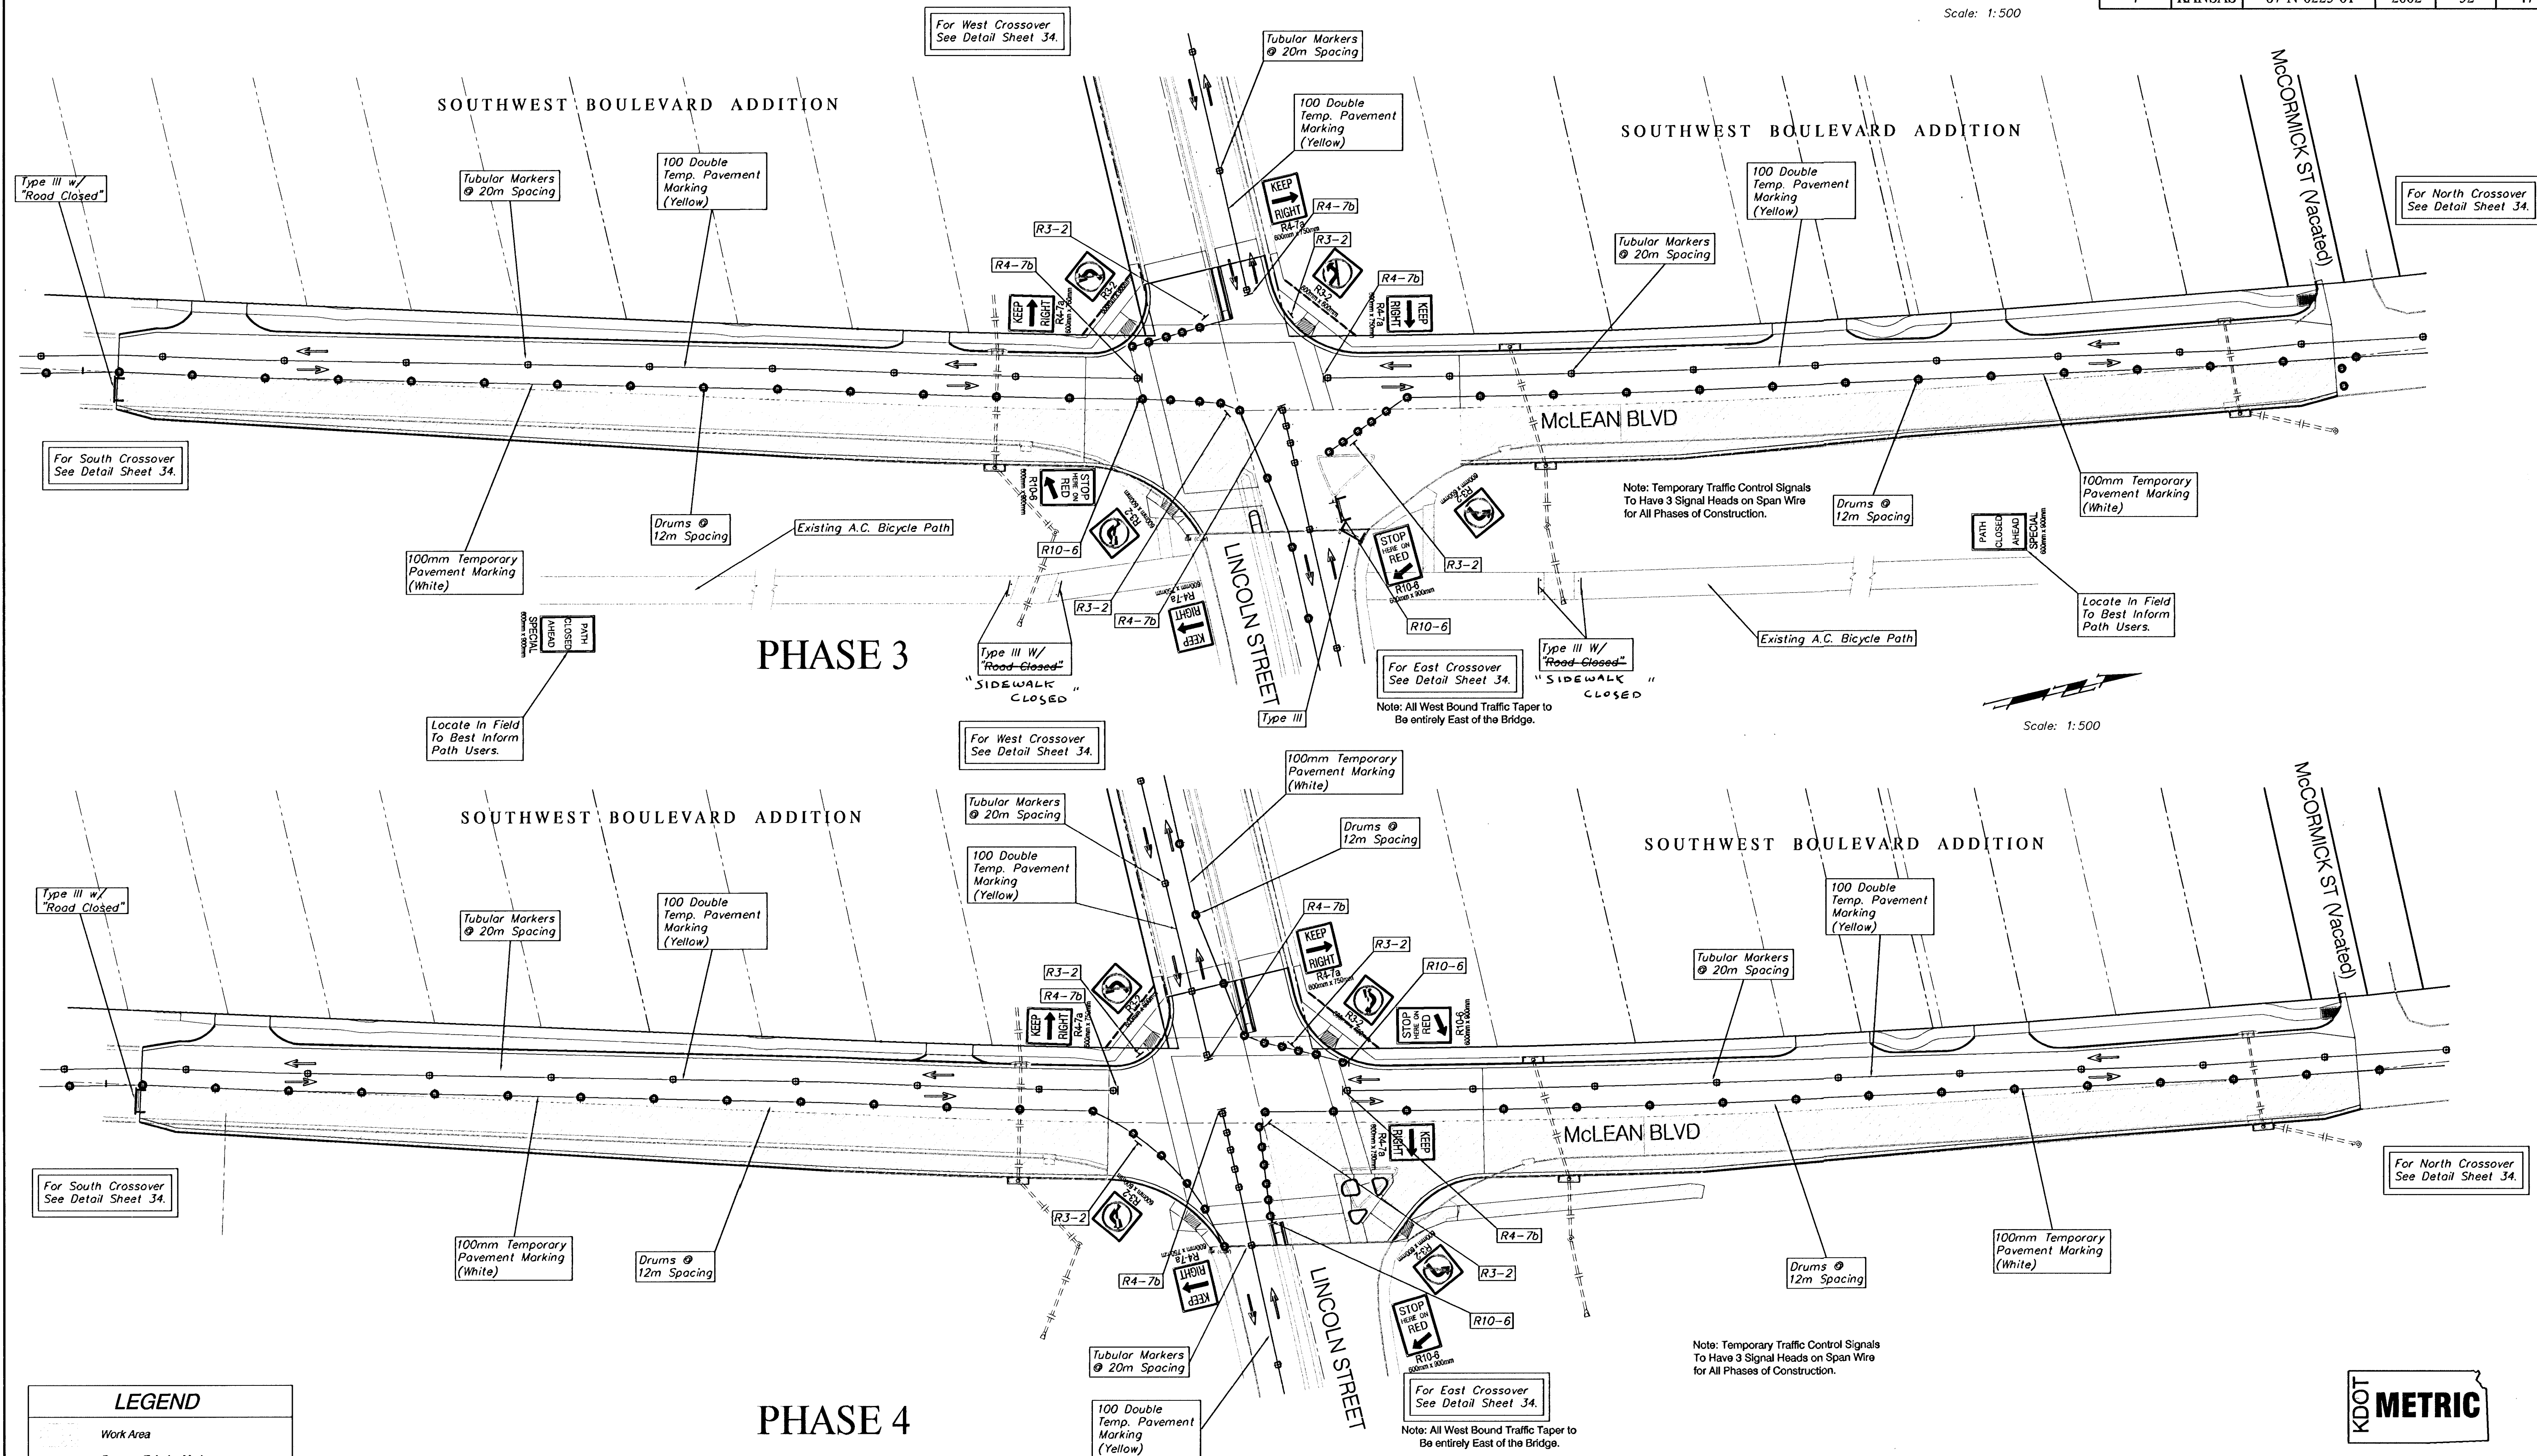

Scale: 1:500

LEGEND	
	Work Area
	Drum or Tubular Marker
	Type III Barricade
	Traffic Flow Pattern



PROJECT NUMBER 472-83799		SHEET NAME Conseq02		ENGINEERING DIRECTORY F:\Lin\Mcln\Conseq	
DESIGN JFB	DRAWN KWR	APPROVED JFB	DATE July 2003	SCALE 1:500 SI	BAUGHMAN NO 01-03-E944

CAPITAL IMPROVEMENT PROJECT
CONSTRUCTION SEQUENCING
 LINCOLN AND MCLEAN INTERSECTION IMPROVEMENTS

BAUGHMAN COMPANY, P.A.
 ENGINEERING, SURVEYING, & PLANNING
 316-262-7271 • 315 ELLIS • WICHITA, KANSAS 67211

SHEET 32 OF 47