
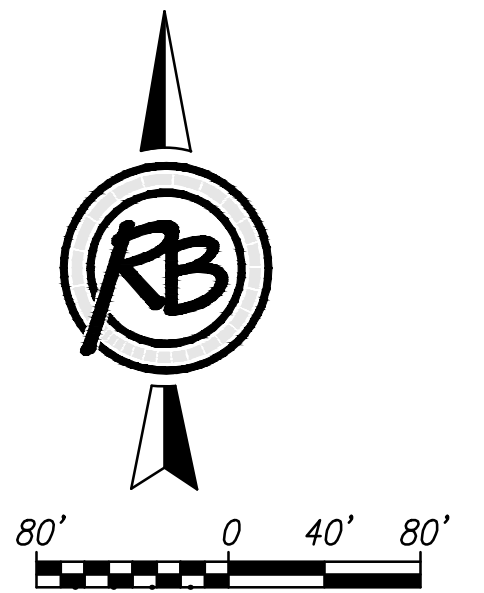
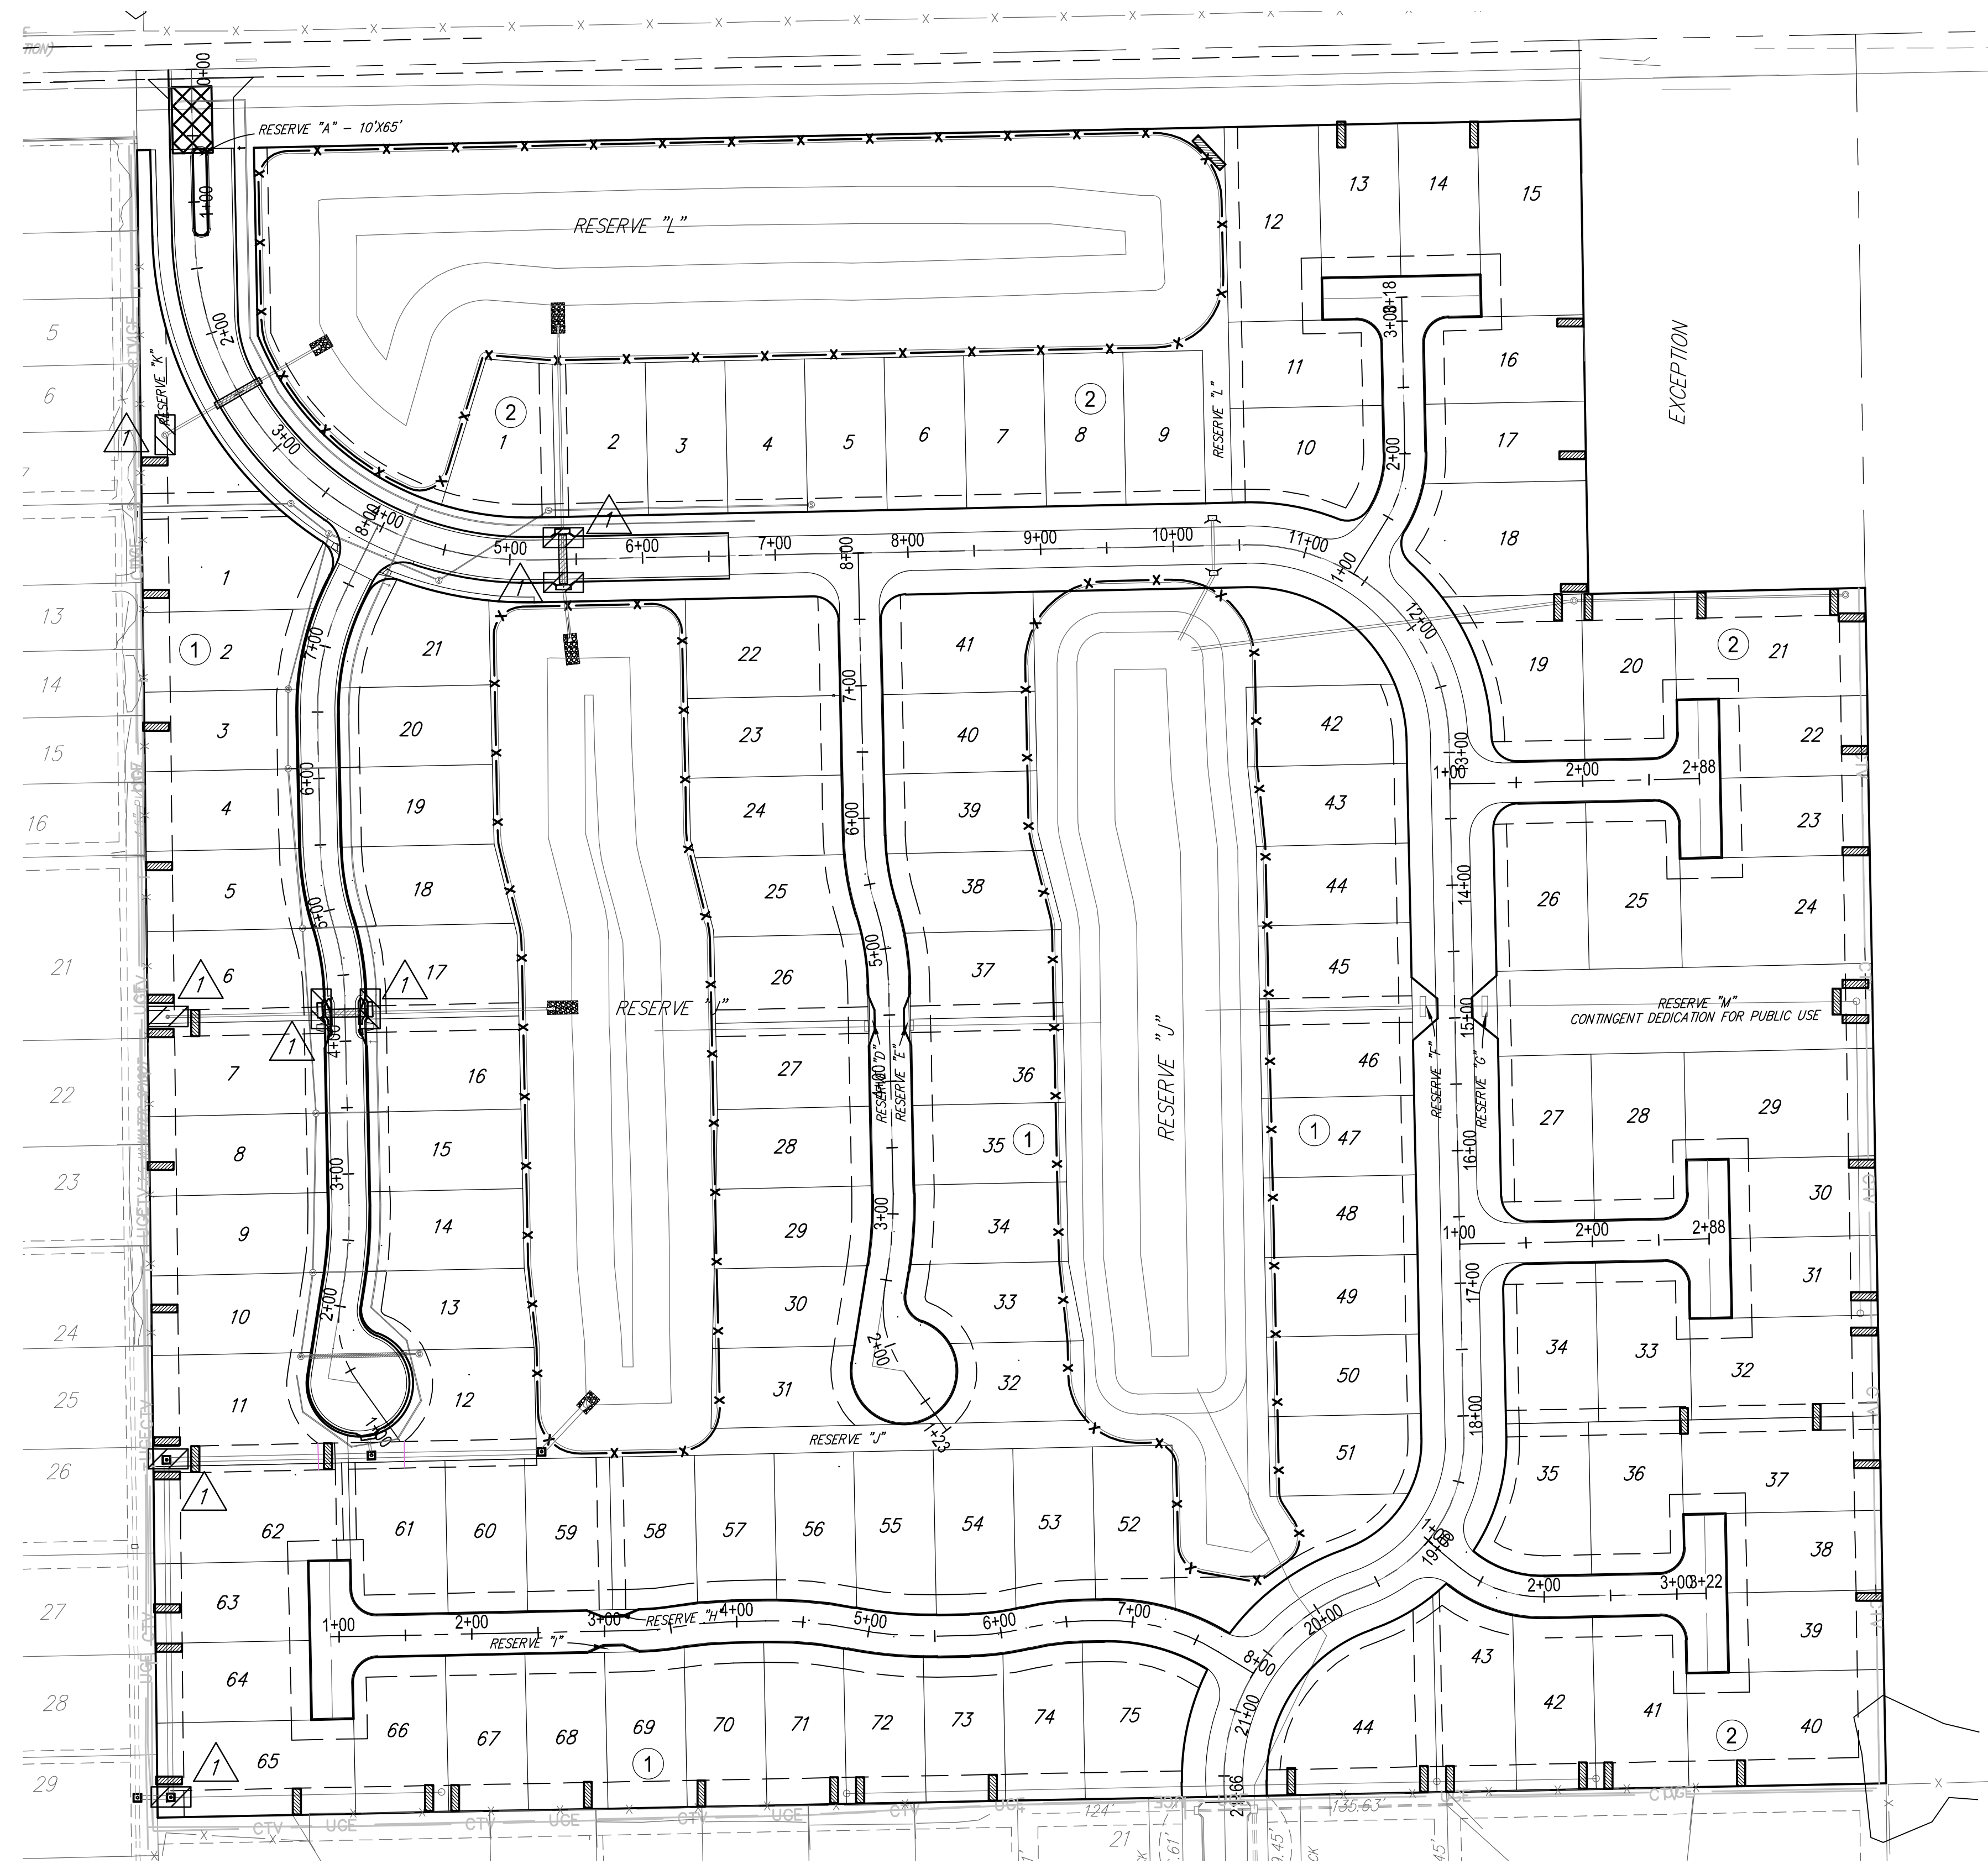
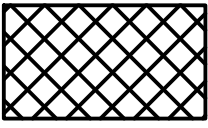


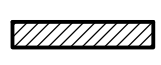

PROJECT QUANTITIES

-  MAINTAIN Construction Entrance
-  INSTALL Silt Fence (5083 L.F.)
-  INSTALL Linear Sediment Barrier (1070 L.F.)
-   INSTALL Inlet Protection (8 EACH)

SEAL

SIENA LAKES ADDITION PHASE 1

EROSION CONTROL PLAN



RUGGLES & BOHM

ENGINEERING | SURVEYING | LANDSCAPE ARCHITECTURE | GOVERNMENT

924 NORTH MAIN WICHITA, KANSAS 67203 P (316) 264-8008 F (316) 264-4621 WWW.RB-KANSAS.COM

PROJECT NUMBER

468-84971

DRAWING FILE

Siena Lakes Eng Base [EROSION CONTROL PLAN]

DATE

11-3-2015

DESIGN

EJG

DRAWN

DS

REVIEW

REVIEW

9-30-2015

SHEET

19

OF

37

(c) Copyright 2015, Ruggles & Bohm, P.A.