CONSTRUCTION PLANS FOR
SANITARY SEWER EXTENSIONS TO SERVE

LOT 5 and 6, BLOCK 4, BARTLOW ADDITION

TO

THE CITY OF WICHITA, KANSAS

LATERAL 38, MAIN 2, SOUTHWEST INTERCEPTOR

GARY JANZEN, P.E. - CITY ENGINEER

PROJECT NO. 468-85032
OCA NO. (744397)

Dutton Construction - Contractor
G. Baalman - City of Wichita, Field Project Engineer
J. Koleczek - City of Wichita, Inspector
As-built
Release Date: 02/02/2016
pdf: apr 04/22/2016

GENERAL NOTES:

1. Contractor will be required to provide a minimum advance notice of seventy–two (72) hours to utility companies prior to starting any excavation as follows:

   Kansas One–Call 1–800–344–7233

   The Contractor must notify the following in case of an emergency:

Southern Star Pipeline	529–6603
Cox Communications	262–4270 or 263–2061
Westar Energy	261–6824
Kansas Gas Service	832–3121
Aquila Networks	941–1608
AT&T	268–2102
City of Wichita Water Department	268–4908
City of Wichita Sewer Maintenance	268–4071

2. The Contractor shall be responsible for maintaining continuous flow of sewage through construction. Contractor's proposed method for maintaining sewage flow shall be approved by the Engineer. Cost of maintaining flow of sewage through construction will not be paid for directly and this cost shall be considered as subsidiary to the other pay items of the work.
3. The Contractor shall be responsible for preserving property irons. The Contractor will be required to re–establish any property irons which are damaged or destroyed by his construction operations. Such irons shall be re–established by a licensed land surveyor in accordance with state laws.
4. Trees and shrubs in public right–of–way which are in direct conflict with proposed new construction shall be removed by the Contractor with the Engineer's approval. Trees and shrubs which are not in direct conflict with the proposed new construction shall be saved and protected from damage.
5. Contractor shall vacuum test all manholes according to the City of Wichita standard specifications.
6. The tops of all Manholes to be set 0.4 feet above existing ground unless otherwise noted.
7. All areas disturbed by sewer construction, i.e. R/W, easements, and adjacent properties shall be restored with the same grass/sod as per AR 78.
8. Contractor shall maintain all existing BMP(s) on project site during construction. Contractor shall repair or replace any existing BMP(s) that are damaged (Cost subsidiary to site restoration). If BMP(s) were damaged prior to contractor beginning work on project, notify construction inspector or engineer prior to commencing construction.
9. In street right of way (not under street) and under parking lots, contractor shall backfill trench with sand and flush per City of Wichita specifications. Under pavement within the street right of way, contractor shall backfill trench with flowable fill per City of Wichita specifications.
10. Any street closure will require a traffic control plan to be submitted for review and approval to the Traffic Engineer. Traffic control as necessary shall be per the latest addition of the MUTCD.
11. Depth & location of all existing utilities shown must be field verified.
12. Existing flowline information obtained from city records & field survey.
13. Contractor to Field Verify location and depth of All Utilities prior to construction and report findings to Project Engineer.

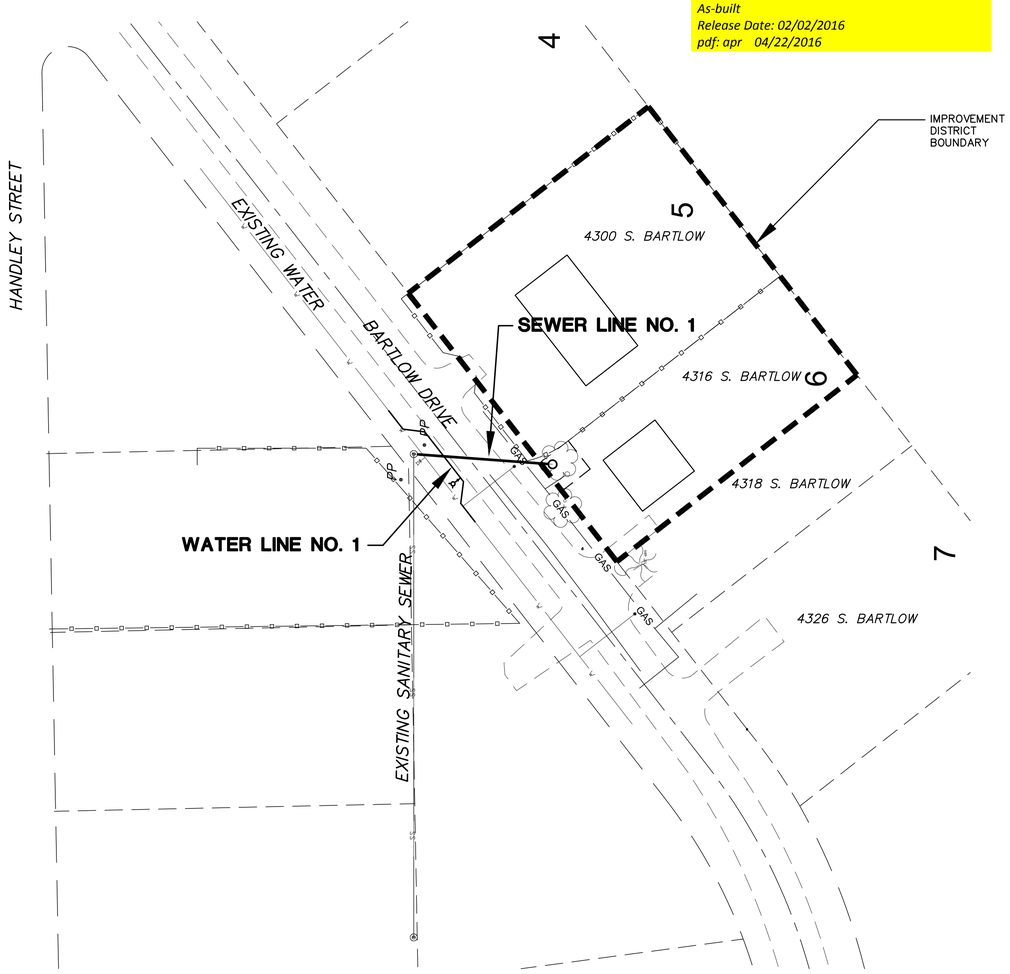

Scale: 1"=40'

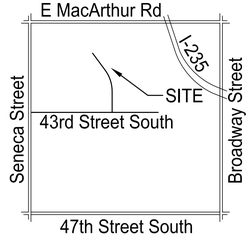

LOCATION MAP
No Scale

INDEX

TITLE SHEET	SHEET 1
SEWER LINE NO. 1	SHEET 2
WATERLINE NO. 1	SHEET 3
SANITARY SEWER DETAILS	SHEET 4-5
WATERLINE DETAILS	SHEET 6-7
EROSION CONTROL DETAILS	SHEET 8-12
PLAT	SHEET 13

BENCH MARKS

Bench Mark #1
RR Spike in Power Pole, 5' West of SSMH
Elevation 1279.08 NAVD88

No.	Date	By	Approved	Revision

OCTOBER 2015

PLANS PREPARED
BY

POE & ASSOCIATES, INC.
CONSULTING ENGINEERS
544 West Douglas Avenue □ Wichita, KS 67203
Phone 316/685-4114 □ FAX 316/685-4444

JOHN P. DICUS
18137
KANSAS
PROFESSIONAL ENGINEER
4 November 2015