


SANITARY SEWER PLANS FOR
17TH STREET SANITARY SEWER
 WICHITA, KANSAS

©2015
 MKEC Engineering
 All Rights Reserved
 www.mkec.com
 These drawings and their contents, including but not limited to all concepts, designs, & notes are the exclusive property of MKEC Engineering (MKEC), and may not be used or reproduced in any way without the express consent of MKEC.


SANITARY SEWER LINE 1 CONT.

PROJECT NO	468-85021	
DATE	MARCH 2015	
SCALE	AS SHOWN	
DESIGNED	DRAWN	CHECKED
JRA	WNJ	JRA
NO.	REVISION	DATE
2	CONST MH 1-10	9-25-15
1	REVISE TO DEPICT 20" WTR	7-27-15

SHEET NO.
 08 OF 51

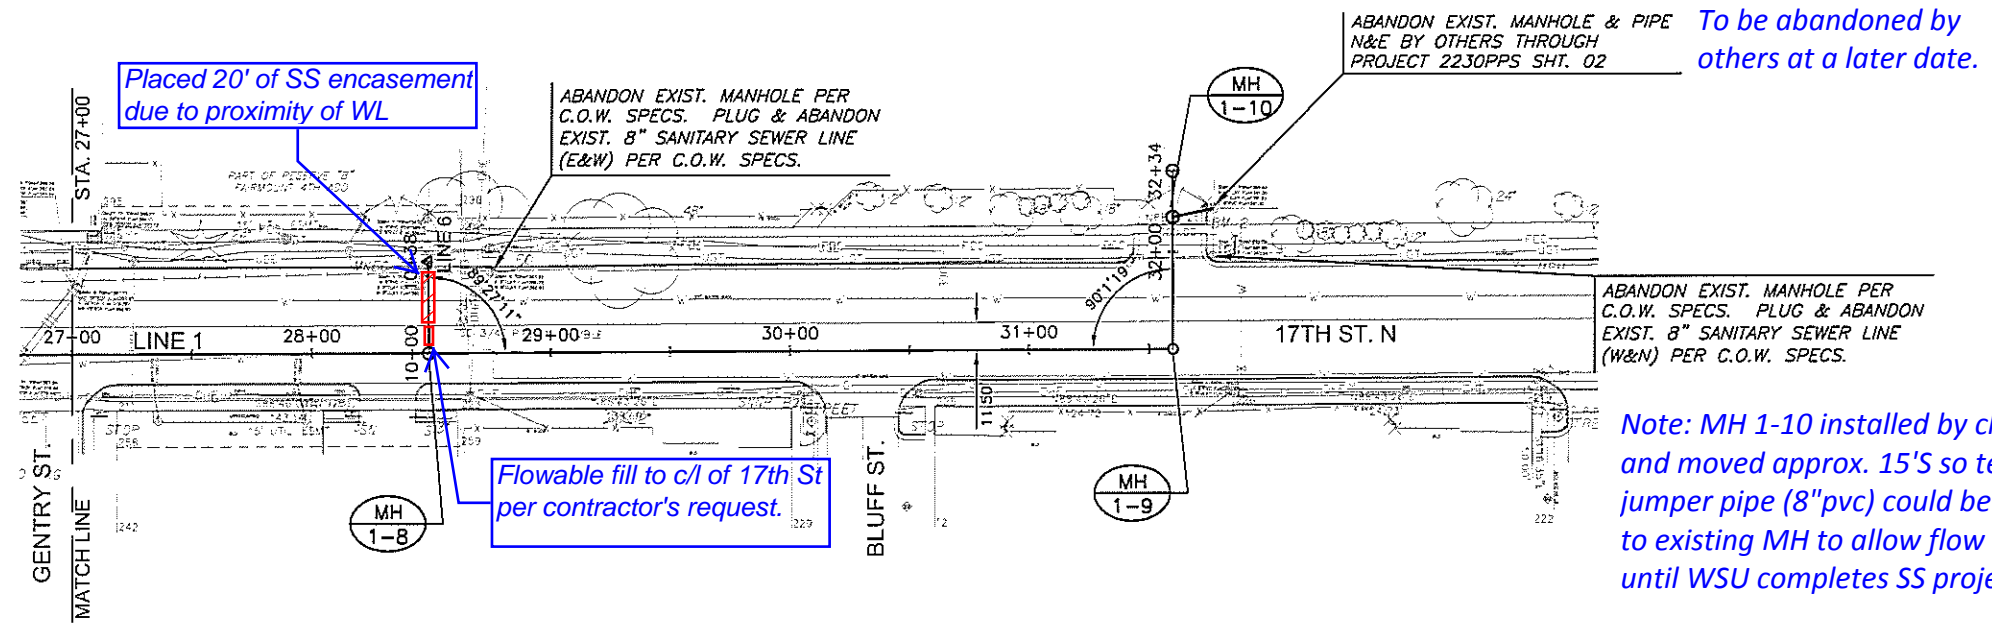

PLAN - SS LINE 1 (3)
 PROFILE - SS LINE 1 (3)

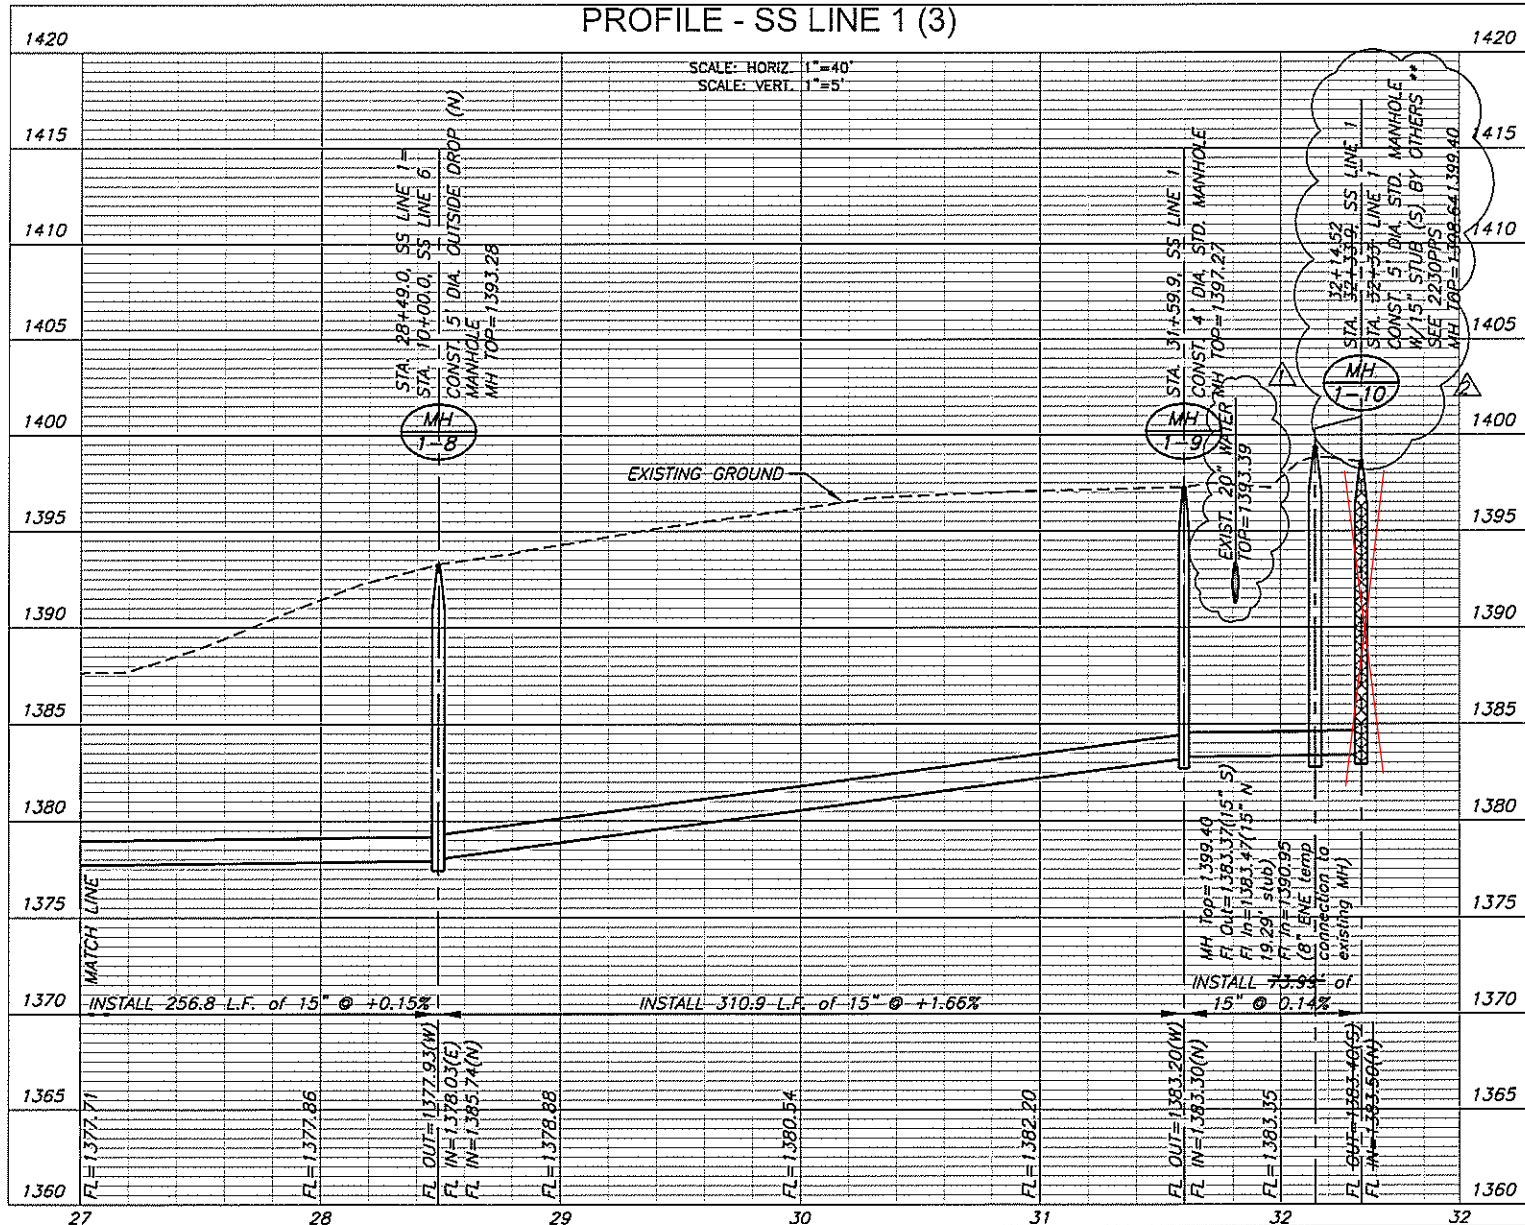

NOTE:
 CONTRACTOR TO VERIFY THE DEPTH AND LOCATION OF EXISTING UTILITIES PRIOR TO CONSTRUCTION.

J:\PROJECTS\2014\1403\17TH STREET SANITARY SEWER\GIS\CAD\DWG\M173_01.DWG