


PLOTED: Tuesday, February 09, 2016 @ 02:39PM

S:\PROJECTS\2014\40101462_PREAMER_ESTANCIA\05-CIVIL\DWG\PAV\RESIDENTIAL\PH11462_PAV17.DWG

SUBDIVISION BENCH MARKS

NO.	STREET AND STATION	FROM CL	DESCRIPTION	ELEVATIONS
4	MIRABELLA, STA. 14+77.65	14.5' RT	TOP OF CURB AT EAST END OF INLET HOOKUP	


NOTE: CONTRACTOR SHALL INSTALL SUBDIVISION BENCH MARKS ("FLAT SURVEY MARKERS NO. 8134-08 3" TOP DIAMETER" PROVIDED BY KANSAS BLUE PRINT CO., INC.) COSTS TO BE CONSIDERED SUBSIDIARY TO CONSTRUCTION OF COMBINED CURB AND GUTTER.

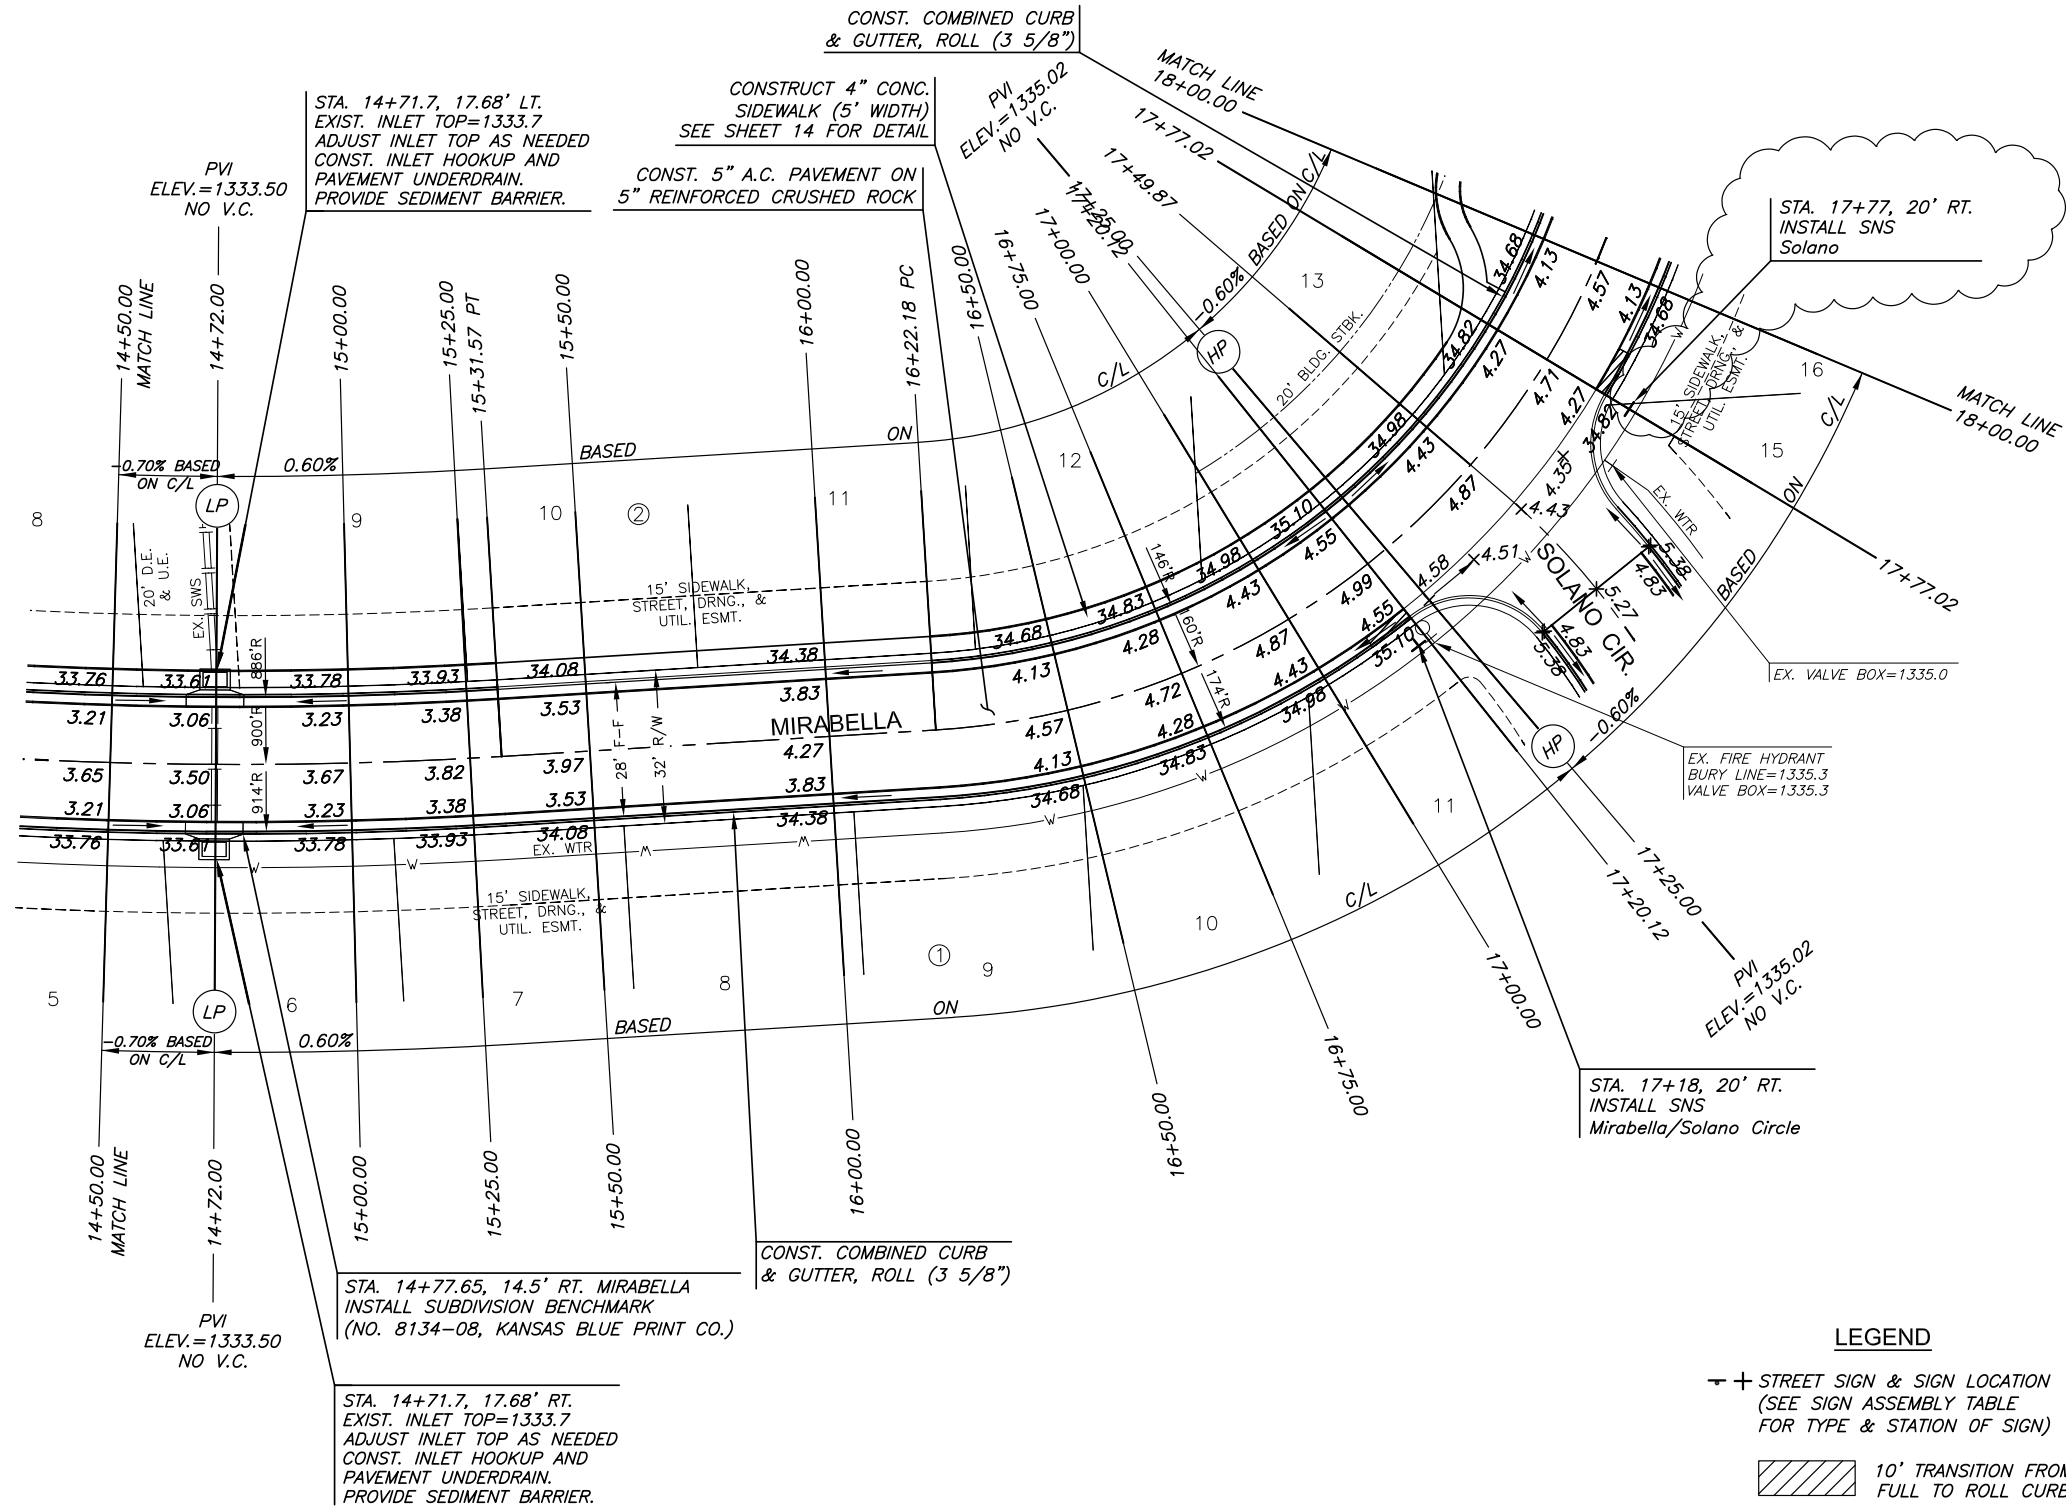

LEGEND

- +— STREET SIGN & SIGN LOCATION (SEE SIGN ASSEMBLY TABLE FOR TYPE & STATION OF SIGN)
- 10' TRANSITION FROM FULL TO ROLL CURB

NOTE: TOP OF CURB ELEVATIONS SHOWN ARE FOR FULL CURB. CONSTRUCT CURB AND GUTTER AS NOTED.

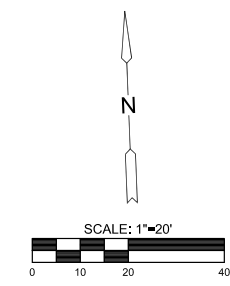

PAVING & INCIDENTAL DRAINAGE FOR
ESTANCIA ADDITION
 PHASE 1

©2016 MKEC Engineering
 All Rights Reserved
 www.mkec.com
 These drawings and their contents, including, but not limited to, all concepts, designs, & ideas are the exclusive property of MKEC Engineering (MKEC), and may not be used or reproduced in any way without the express consent of MKEC.

MIRABELLA CONT.

PROJECT NO.	472-85243	
DATE	JAN. 2015	
SCALE	1"=20'	
DESIGNED	DRAWN	CHECKED
DFL	BKS	GJA
NO.	REVISION	DATE
1	ADDED STREET SIGN	02-09-16