


Point Table			Point Table				
Point #	Northing	Easting	Description	Point #	Northing	Easting	Description
1	9938.06	19864.50	Iron	56	8541.42	20993.98	Iron
2	8263.59	20472.30	Iron	57	8526.13	20992.47	Iron
6	9947.05	21090.33	Iron	58	8531.83	20934.75	Iron
7	9922.54	21115.56	Iron	61	8864.92	20634.05	Iron
8	9697.55	21117.61	Iron	62	8310.17	21145.25	Iron
9	8298.99	20502.54	Iron	63	8547.12	20936.26	Iron
10	8957.35	21139.35	Iron	65	8818.96	20587.74	Iron
11	9952.70	20612.60	Iron	66	8840.62	20334.20	Iron
12	9597.69	21133.52	Iron	67	8841.24	20398.20	Iron
13	8869.35	21140.15	Iron	68	8773.48	20011.84	Iron
14	9892.71	20613.78	Iron	69	8774.05	20069.83	Iron
15	9894.44	20701.76	Iron	70	8580.22	20013.72	Iron
16	9834.17	20626.93	Iron	71	8580.79	20071.71	Iron
17	9835.43	20690.91	Iron	72	8772.16	19875.84	Iron
18	9806.09	20627.48	Iron	73	8836.16	19875.22	Iron
19	9816.43	20691.29	Iron	74	8837.48	20011.21	Iron
20	9807.60	20070.61	Iron	75	8838.04	20069.21	Iron
21	9744.02	20077.98	Iron	76	9295.60	20006.76	Iron
22	9816.25	20145.27	Iron	77	9281.21	20064.90	Iron
23	9752.68	20152.64	Iron	78	8953.38	20704.34	Iron
24	9808.12	20317.36	Iron	79	8889.39	20704.93	Iron
25	9745.53	20304.03	Iron	80	9180.27	20330.89	Iron
26	9745.13	20648.77	Iron	81	9180.89	20394.89	Iron
27	9798.59	20891.74	Iron	82	9269.73	20481.50	Iron
28	9737.07	20874.11	Iron	83	9333.73	20480.48	Iron
29	9672.33	20923.38	Iron	84	9275.41	20840.07	Iron
30	9672.93	20987.37	Iron	85	9339.40	20839.05	Iron
31	8868.79	21078.16	Iron	86	9283.81	20887.55	Iron
32	8891.94	20984.94	Iron	87	9269.31	20895.97	Iron
33	8891.41	20926.94	Iron	88	9312.95	20937.70	Iron
34	8814.48	20923.80	Iron	89	9298.45	20946.12	Iron
35	8809.22	20981.56	Iron	90	9227.47	20910.86	Iron
36	8667.98	20930.88	Iron	91	9236.55	20968.14	Iron
37	8678.79	20987.86	Iron	92	9227.66	20969.55	Iron
38	8267.81	20558.43	Iron	93	9218.58	20912.27	Iron
39	8351.02	20581.44	Iron	94	9428.21	20925.66	Iron
40	8352.99	20517.47	Iron	95	9428.81	20989.66	Iron
41	8439.35	20542.32	Iron	98	8781.92	20597.68	Iron
42	8435.06	20620.38	Iron	99	8782.52	20661.68	Iron
43	8440.33	20625.90	Iron	109	8361.98	20209.85	Iron
44	8484.16	20579.21	Iron	110	8358.98	19879.86	Iron
45	8507.33	20510.96	Iron	112	10024.01	21189.63	Sec Cor
46	8449.33	20511.52	Iron				
47	8448.53	20429.75	Iron				
48	8506.53	20429.18	Iron				
49	8533.74	20600.00	Iron				
50	8534.34	20664.00	Iron				
51	8441.91	20794.87	Iron				
52	8385.91	20795.39	Iron				
53	8307.65	20875.13	Iron				

BENCHMARKS:
 BM #1: "□" cut in top of curb near intersection of 27th Street North & Woodridge, south of SE corner of Lot 24, Block C, Woods North 3rd Addition.
 Elev. = 1392.97 NGVD29

BM #2: "□" cut in top of curb near intersection of Woodridge Court & Woodridge, south of SE corner of Lot 6, Block A, Woods North 3rd Addition.
 Elev. = 1390.10 NGVD29

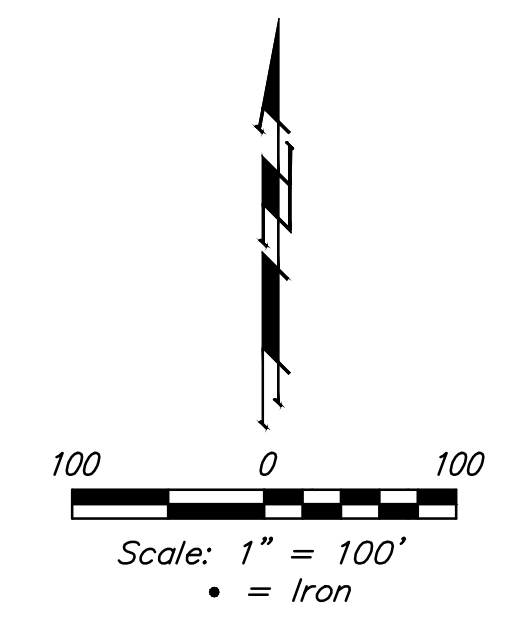

Point Table			
Point #	Northing	Easting	Description
2001	9481.26	20931.16	0+00
2002	9680.17	20929.30	BEND
2003	9685.78	20926.97	PVI
2004	9726.41	20910.08	PVI
2005	9731.06	20908.15	BEND
2006	9740.73	20881.54	BEND
2008	9742.84	20875.76	PC
2011	9758.01	20690.51	TEE
2012	9816.31	20685.29	PI
2014	9751.00	20647.54	PRC
2015	9835.91	20684.90	BEND
2017	9744.68	20340.58	FH
2018	9894.93	20695.75	BEND
2020	9751.40	20305.28	PRC
2021	9954.31	20694.59	BO
2022	9758.64	20151.95	PT
2023	9749.06	20069.33	BEND
2024	9733.82	20057.05	BEND
2025	9731.26	20034.95	BEND
2026	9736.66	20015.97	BEND
2027	9750.46	19998.56	BEND
2028	9783.16	19994.77	BEND
2029	9808.95	20015.21	BEND
2030	9815.33	20070.21	BO



Baughman Woods North 3rd Addition - Phase IV
COORDINATES
 Water Distribution System

Baughman Company, P.A. 315 Ellis St. Wichita, KS 67211 P 316-262-7271 F 316-262-0149
 ENGINEERING | SURVEYING | PLANNING | LANDSCAPE ARCHITECTURE

PROJECT NUMBER	DESIGN	DRAWN
	AEG	JAK
REVISIONS:	APPROVED	DATE
		1/20/16
	SCALE	
	Noted	
	SHEET	
	12 OF 13	

E:\Projects\Woods North 3rd_11-12-18\47\Engineering\Phase 4\WTR_15-08-E279\Wtr Plans.dwg