


**NOTE:**  
CONTRACTOR TO VERIFY THE  
DEPTH AND LOCATION OF EXISTING  
UTILITIES PRIOR TO CONSTRUCTION.

BUILT PER PLAN -twd


PLAN LINE 5  
PROFILE LINE 5

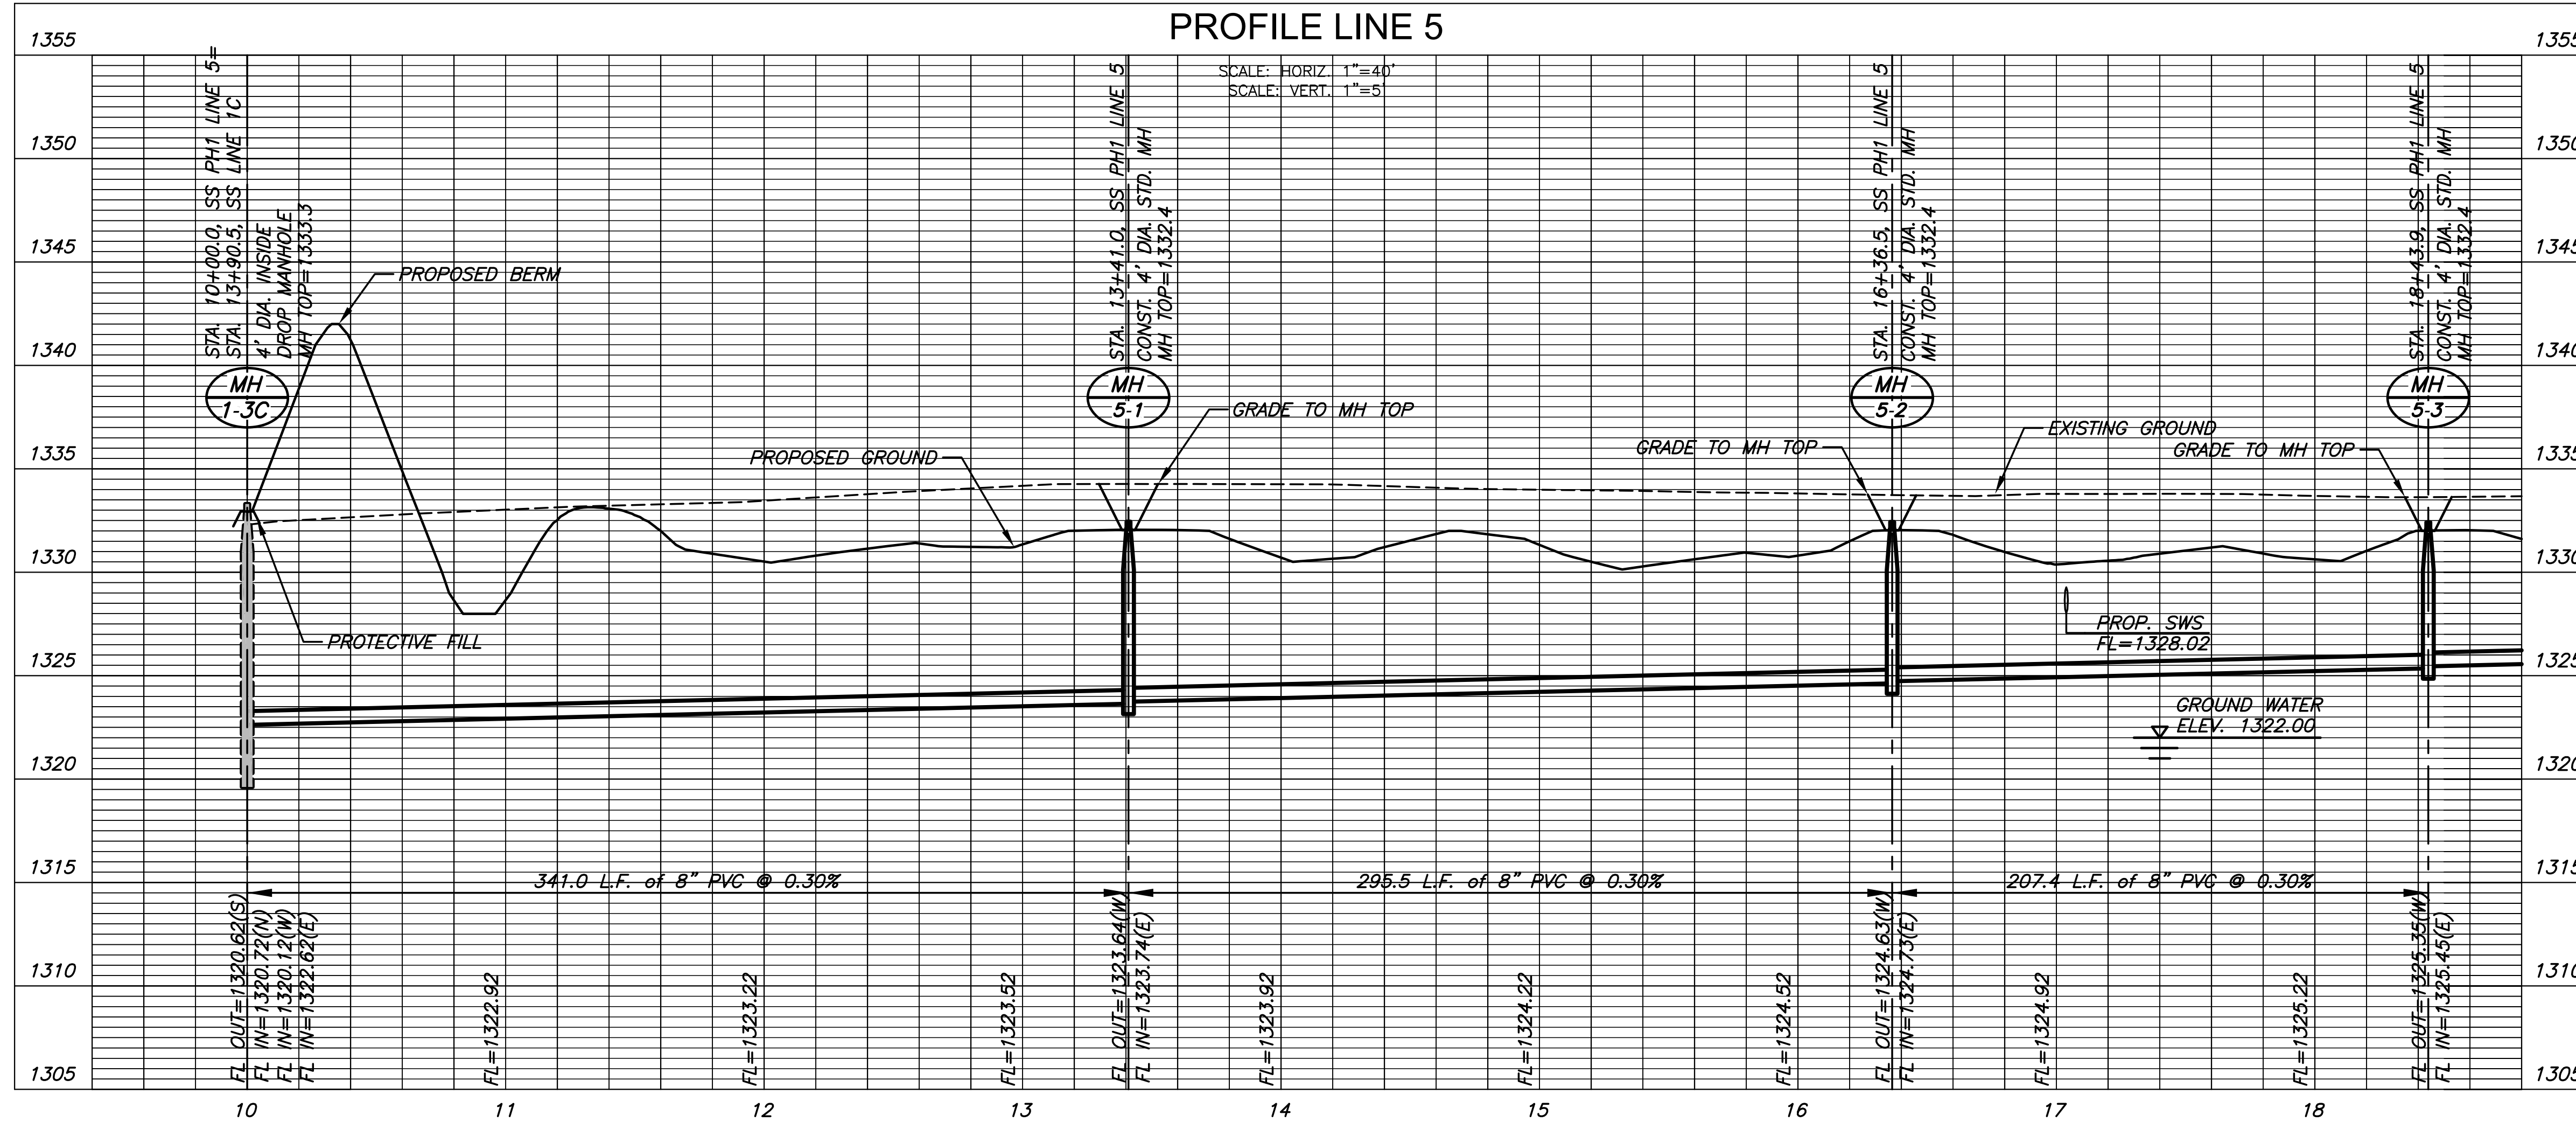

SANITARY SEWER PLANS FOR  
**ESTANCIA ADDITION**  
RESIDENTIAL PHASE 1

©2015  
MKEC Engineering  
All Rights Reserved  
www.mkec.com  
These drawings and their contents,  
including, but not limited to, all concepts,  
designs, & ideas are the exclusive  
property of MKEC Engineering (MKEC),  
and may not be used or reproduced in any  
way without the express consent of MKEC.

LINE 5	
PROJECT NO.	468-850785
DATE	OCT. 2015
SCALE	1" = 40'
DESIGNED	DRAWN
DFL	JWC
CHECKED	GJA
NO.	REVISION
DATE	
SHEET NO.	
10 OF 20	

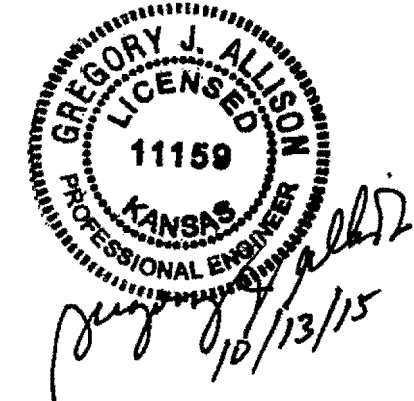

Gregory J. Allison  
10/13/15