

©2015
MKEC Engineering
All Rights Reserved
www.mkec.com
These drawings and their contents, including, but not limited to, all concepts, designs, & ideas are the exclusive property of MKEC Engineering (MKEC), and may not be used or reproduced in any way without the express consent of MKEC.

LINES 6 & 7

PROJECT NO. 468-850785

DATE OCT. 2015

SCALE 1"=40'




DESIGNED DRAWN CHECKED
DFL BKS GJA

NO. REVISION DATE

SHEET NO.

PLOTED: Wednesday, October 14, 2015 @ 11:59AM

J:\PROJECTS\2015\1401010462_PREAMER_ESTANCIA\DWG\CAD\SAN\RESIDENTIAL\1462-8P-06R.DWG

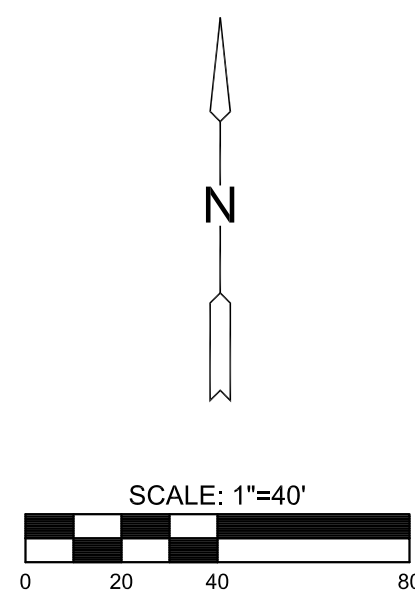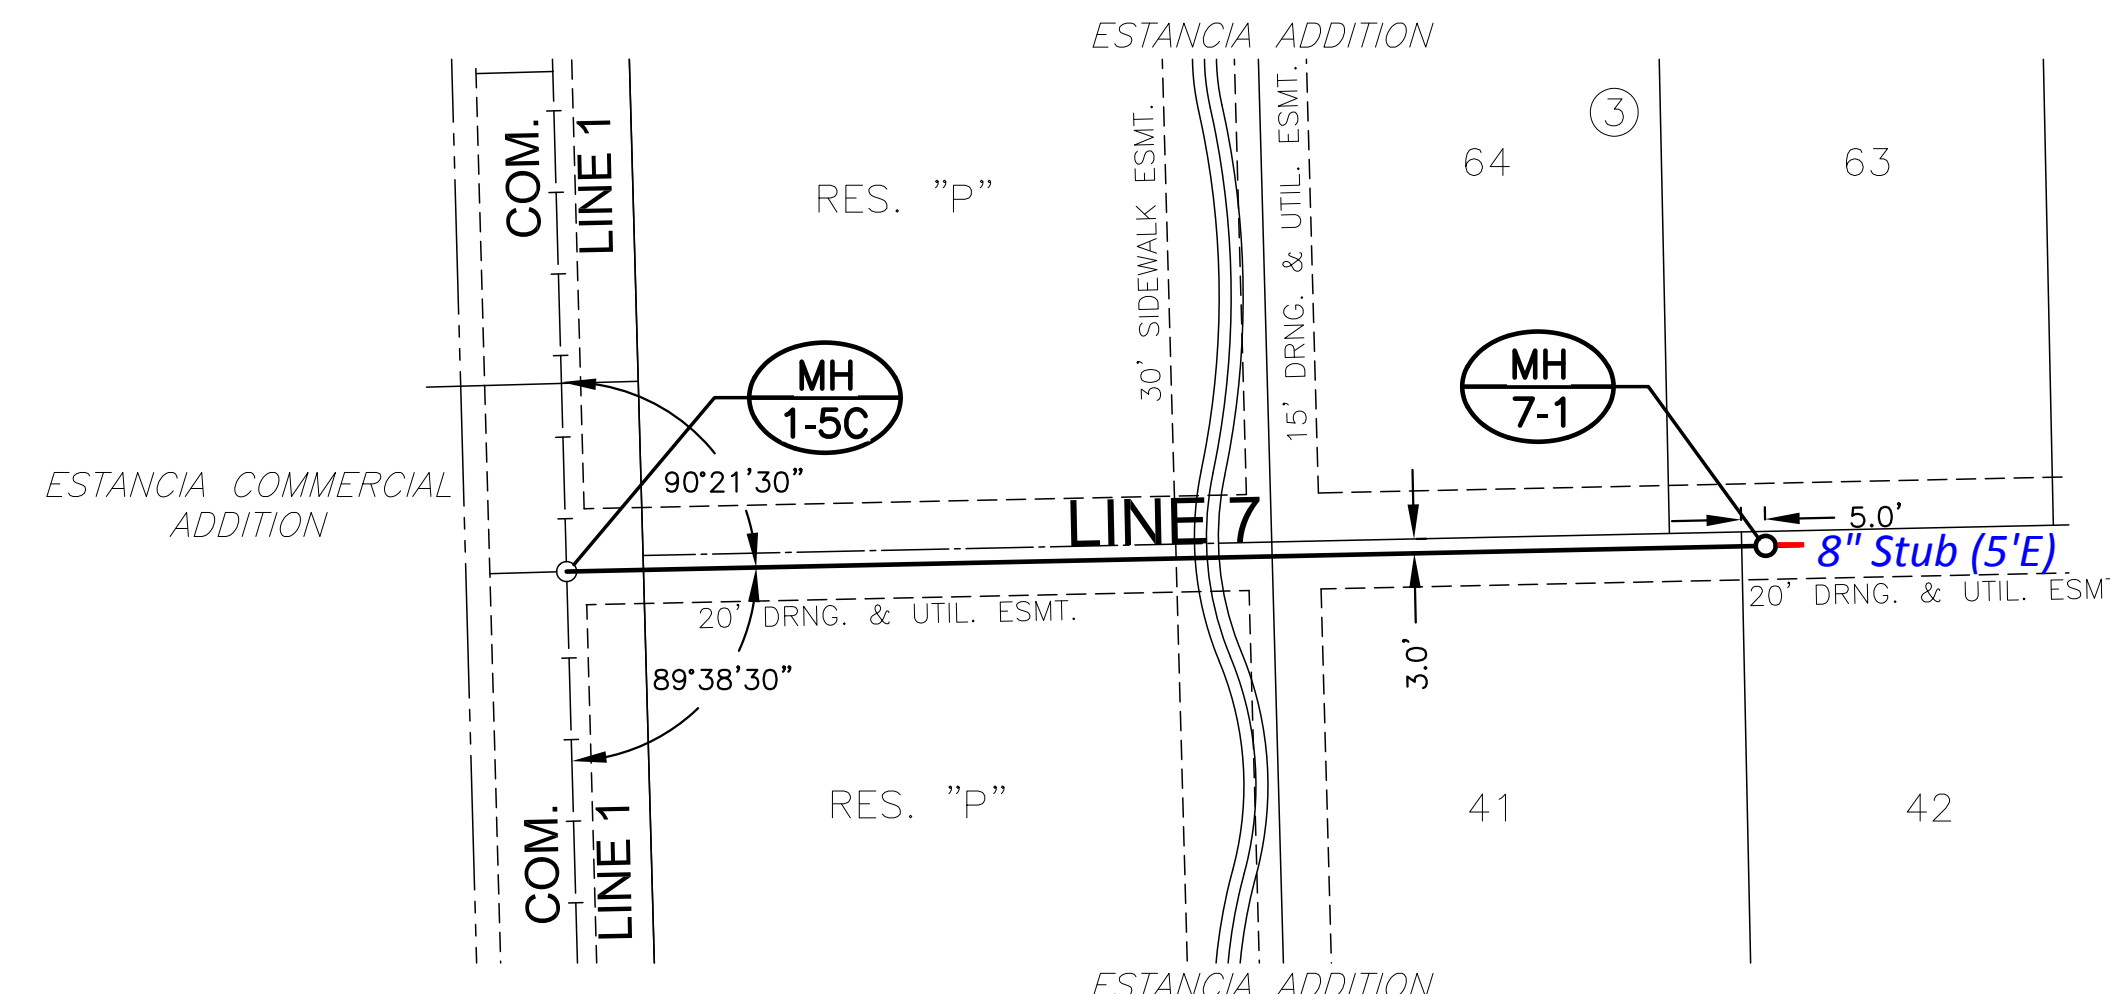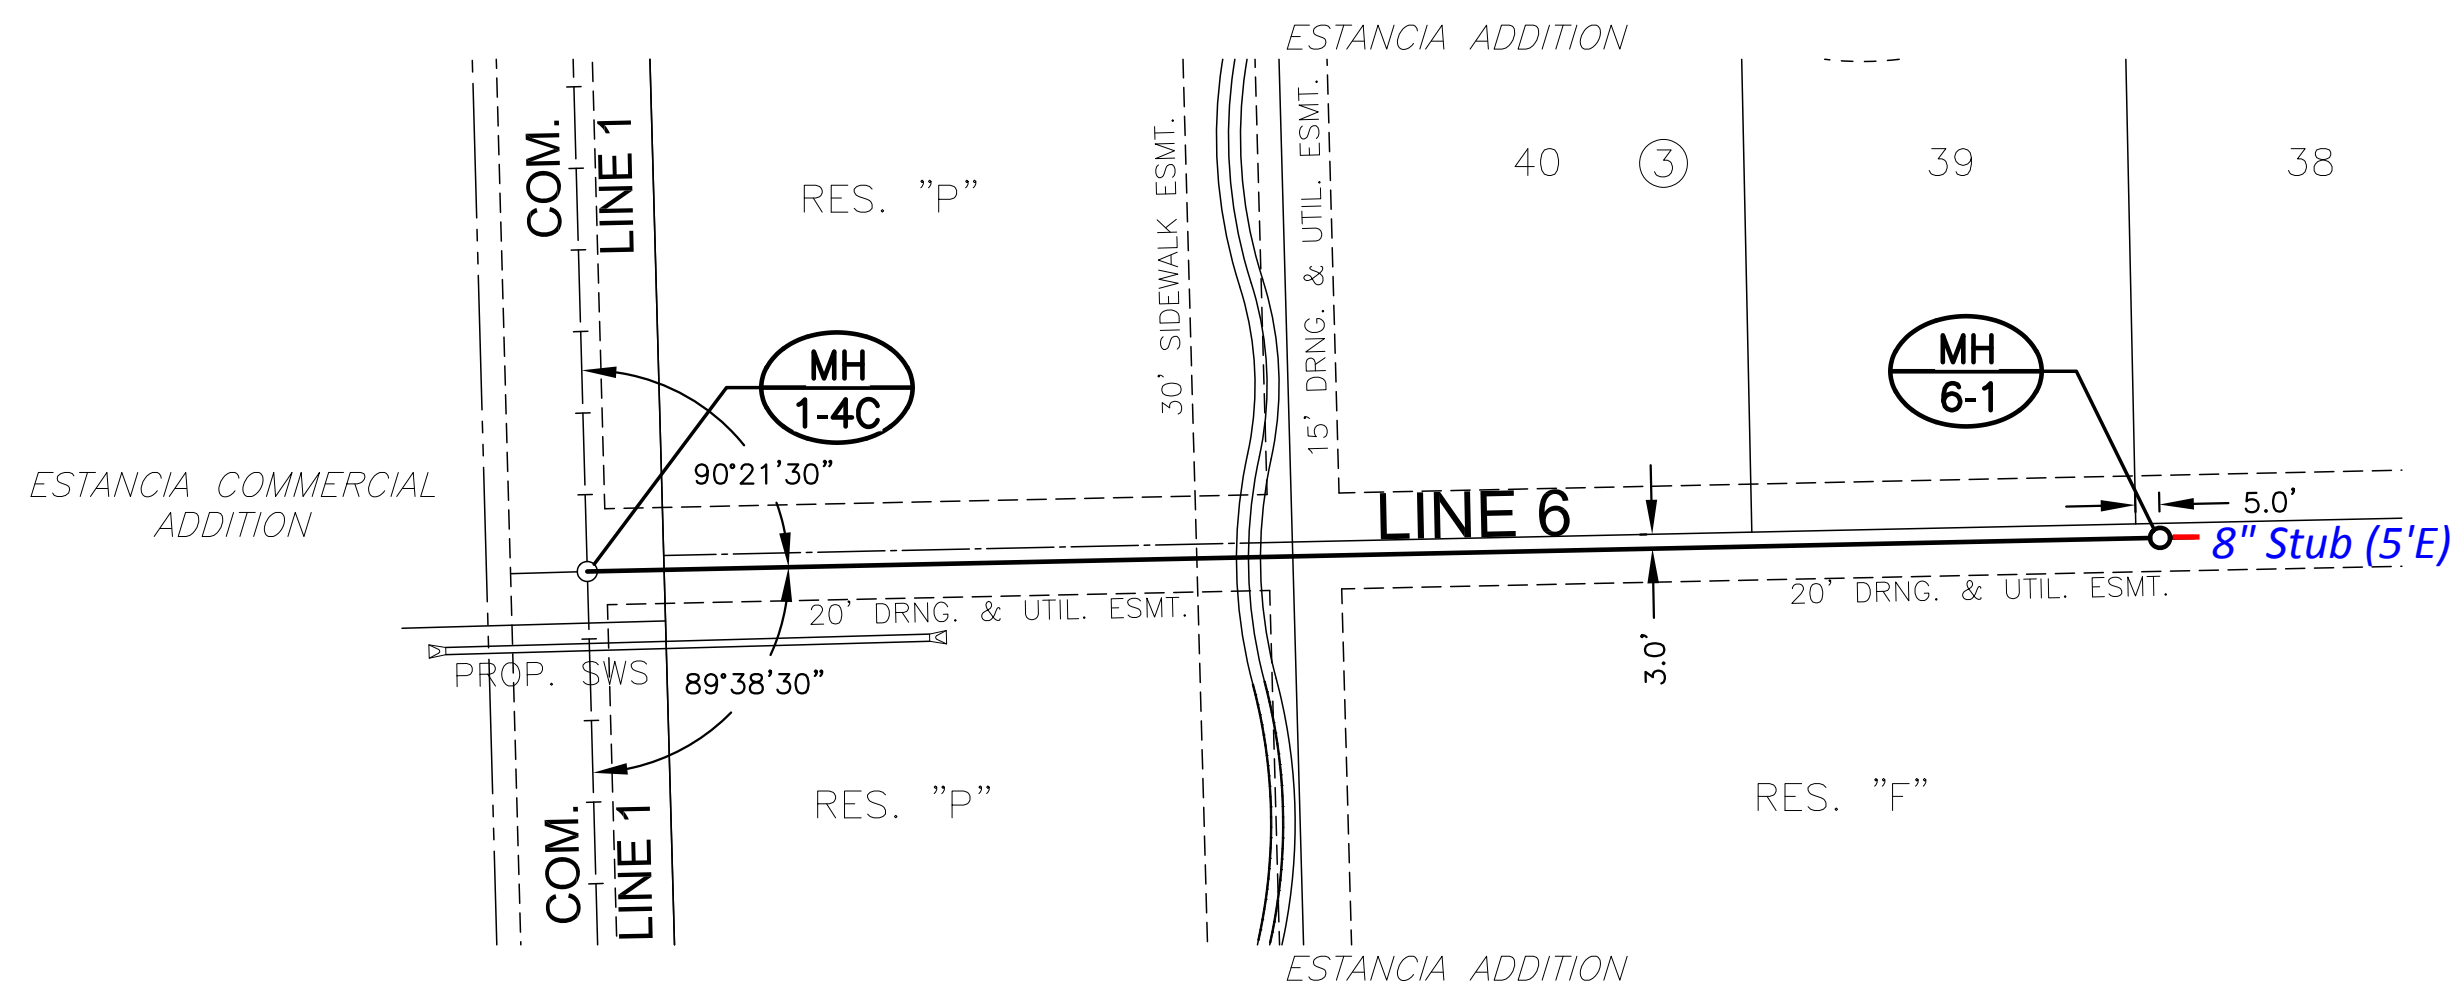

NOTE:
CONTRACTOR TO VERIFY THE DEPTH AND LOCATION OF EXISTING UTILITIES PRIOR TO CONSTRUCTION.

BUILT PER PLAN -twd

BUILT PER PLAN -twd

GREGORY J. ALLISON
LICENSED PROFESSIONAL ENGINEER
KANSAS
11159
10/13/15

