



©2015 MKEC Engineering All Rights Reserved
 These drawings and their contents, including, but not limited to, all concepts, designs, & ideas are the exclusive property of MKEC Engineering (MKEC), and may not be used or reproduced in any way without the express consent of MKEC.

LINES 1 & 2

PROJECT NO.	468-850785	
DATE	OCT. 2015	
SCALE	1" = 40'	
DESIGNED	DRAWN	CHECKED
DFL	JWC	GJA

NO.	REVISION	DATE

J:\PROJECTS\2015\10\10462_PREMIER_ESTANCIA\DWG\CAD\SANRESIDENTIAL\1462-SP016.DWG
 PLOTTED: Wednesday, October 14, 2015 @ 11:46AM

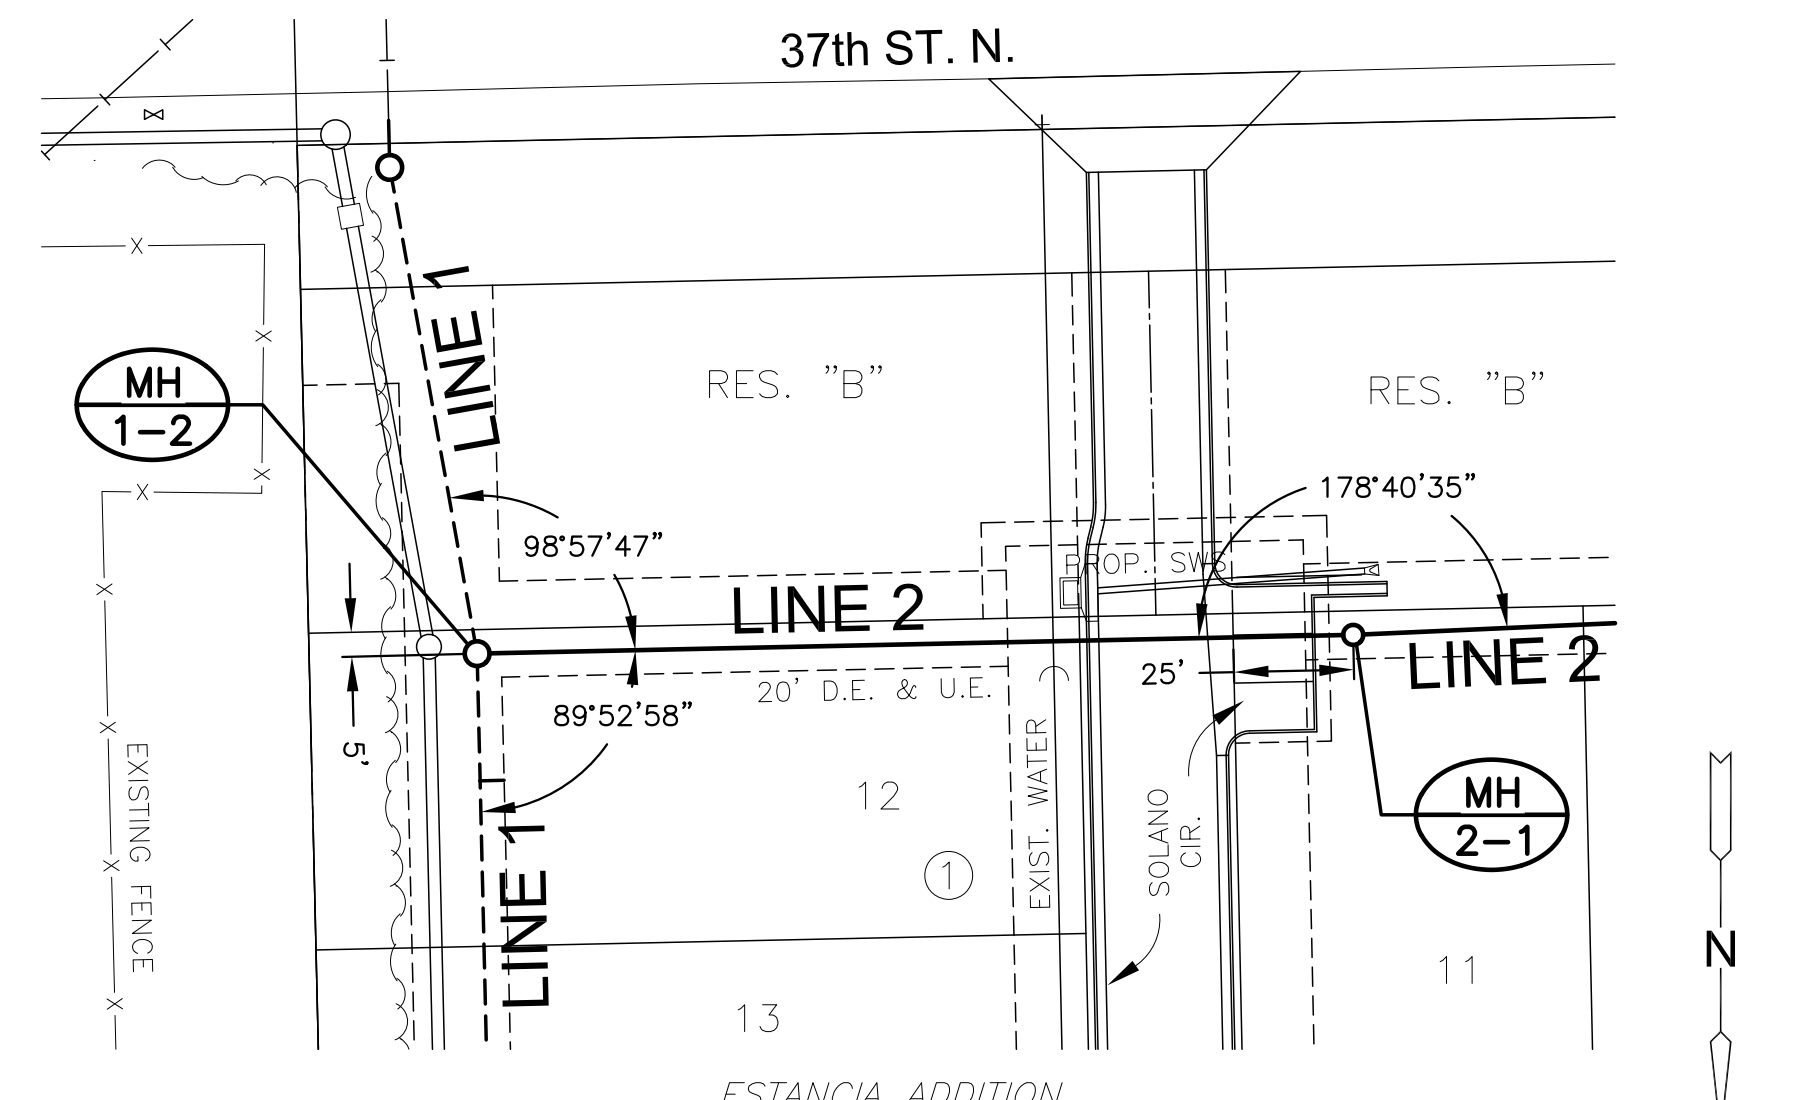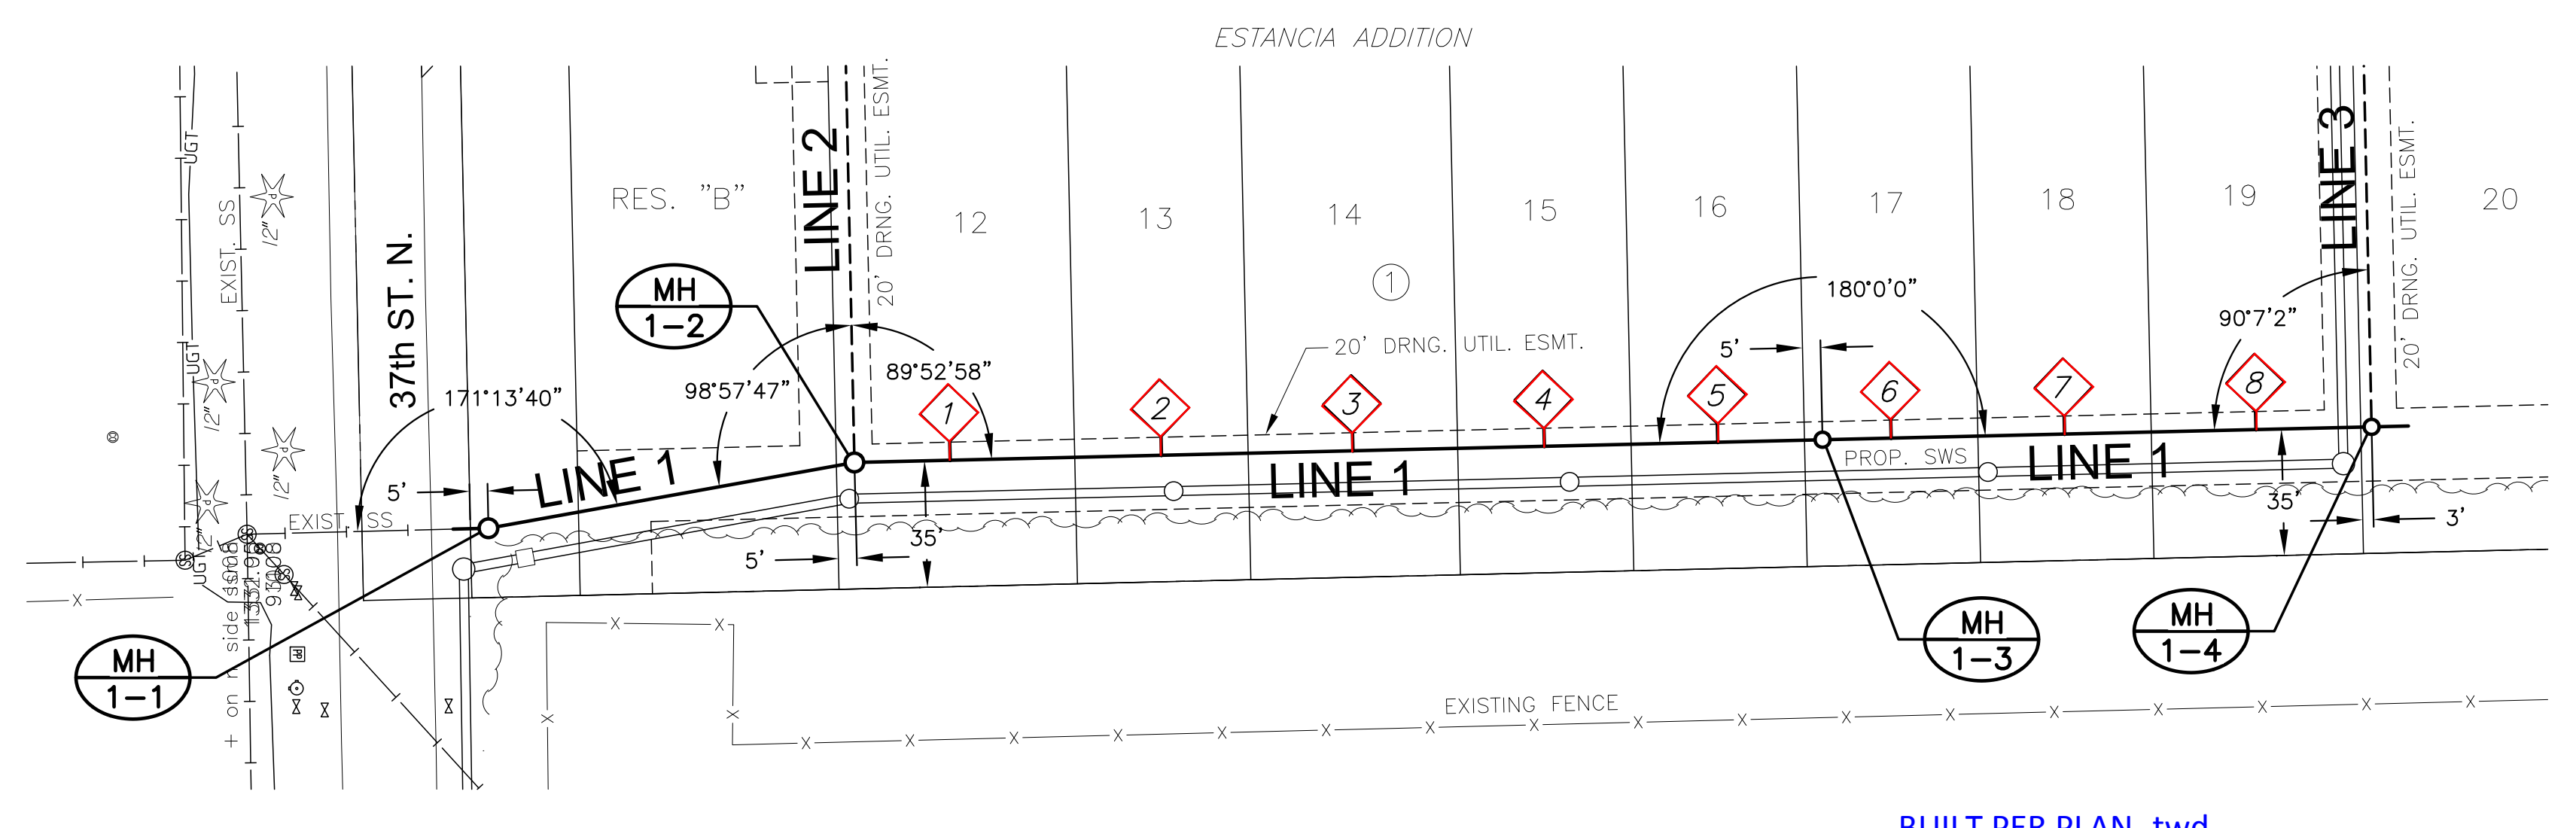


BUILT PER PLAN -twd

Distance from Main to Riser (Lt./Rt.)	Distance from		SEWER SERVICE RISER TABLE							FOR INFORMATION ONLY	
	Upstream MH	Downstream MH	LOCATION			STATION	DIRECTION	APPROXIMATE LENGTH			
			LOT NO.	BLOCK NO.	LINE NO.			VERTICAL (FT)	HORIZONTAL (FT)		
5' Lt	241.7'	26.3'	1	4" TEE	12	1	1	11+39	LT.	12'	5'
5' Lt	182.7'	85.3'	2	4" TEE	13	1	1	11+98	LT.	12'	5'
5' Lt	126.7'	141.3'	3	4" TEE	14	1	1	12+54	LT.	12.5'	5'
5' Lt	73.7'	194.3'	4	4" TEE	15	1	1	13+07	LT.	12'	5'
5' Lt	20.7'	247.3'	5	4" TEE	16	1	1	13+60	LT.	12'	5'
5' Lt	124.7'	27.3'	6	4" TEE	17	1	1	14+08	LT.	12'	5'
5' Lt	76.7'	75.3'	7	4" TEE	18	1	1	14+56	LT.	12'	5'
5' Lt	28.7'	123.3'	8	4" TEE	19	1	1	15+04	LT.	12'	5'

NOTE:
 CONTRACTOR TO VERIFY THE DEPTH AND LOCATION OF EXISTING UTILITIES PRIOR TO CONSTRUCTION.

PLAN LINE 1
PROFILE LINE 1

PLAN LINE 2
PROFILE LINE 2

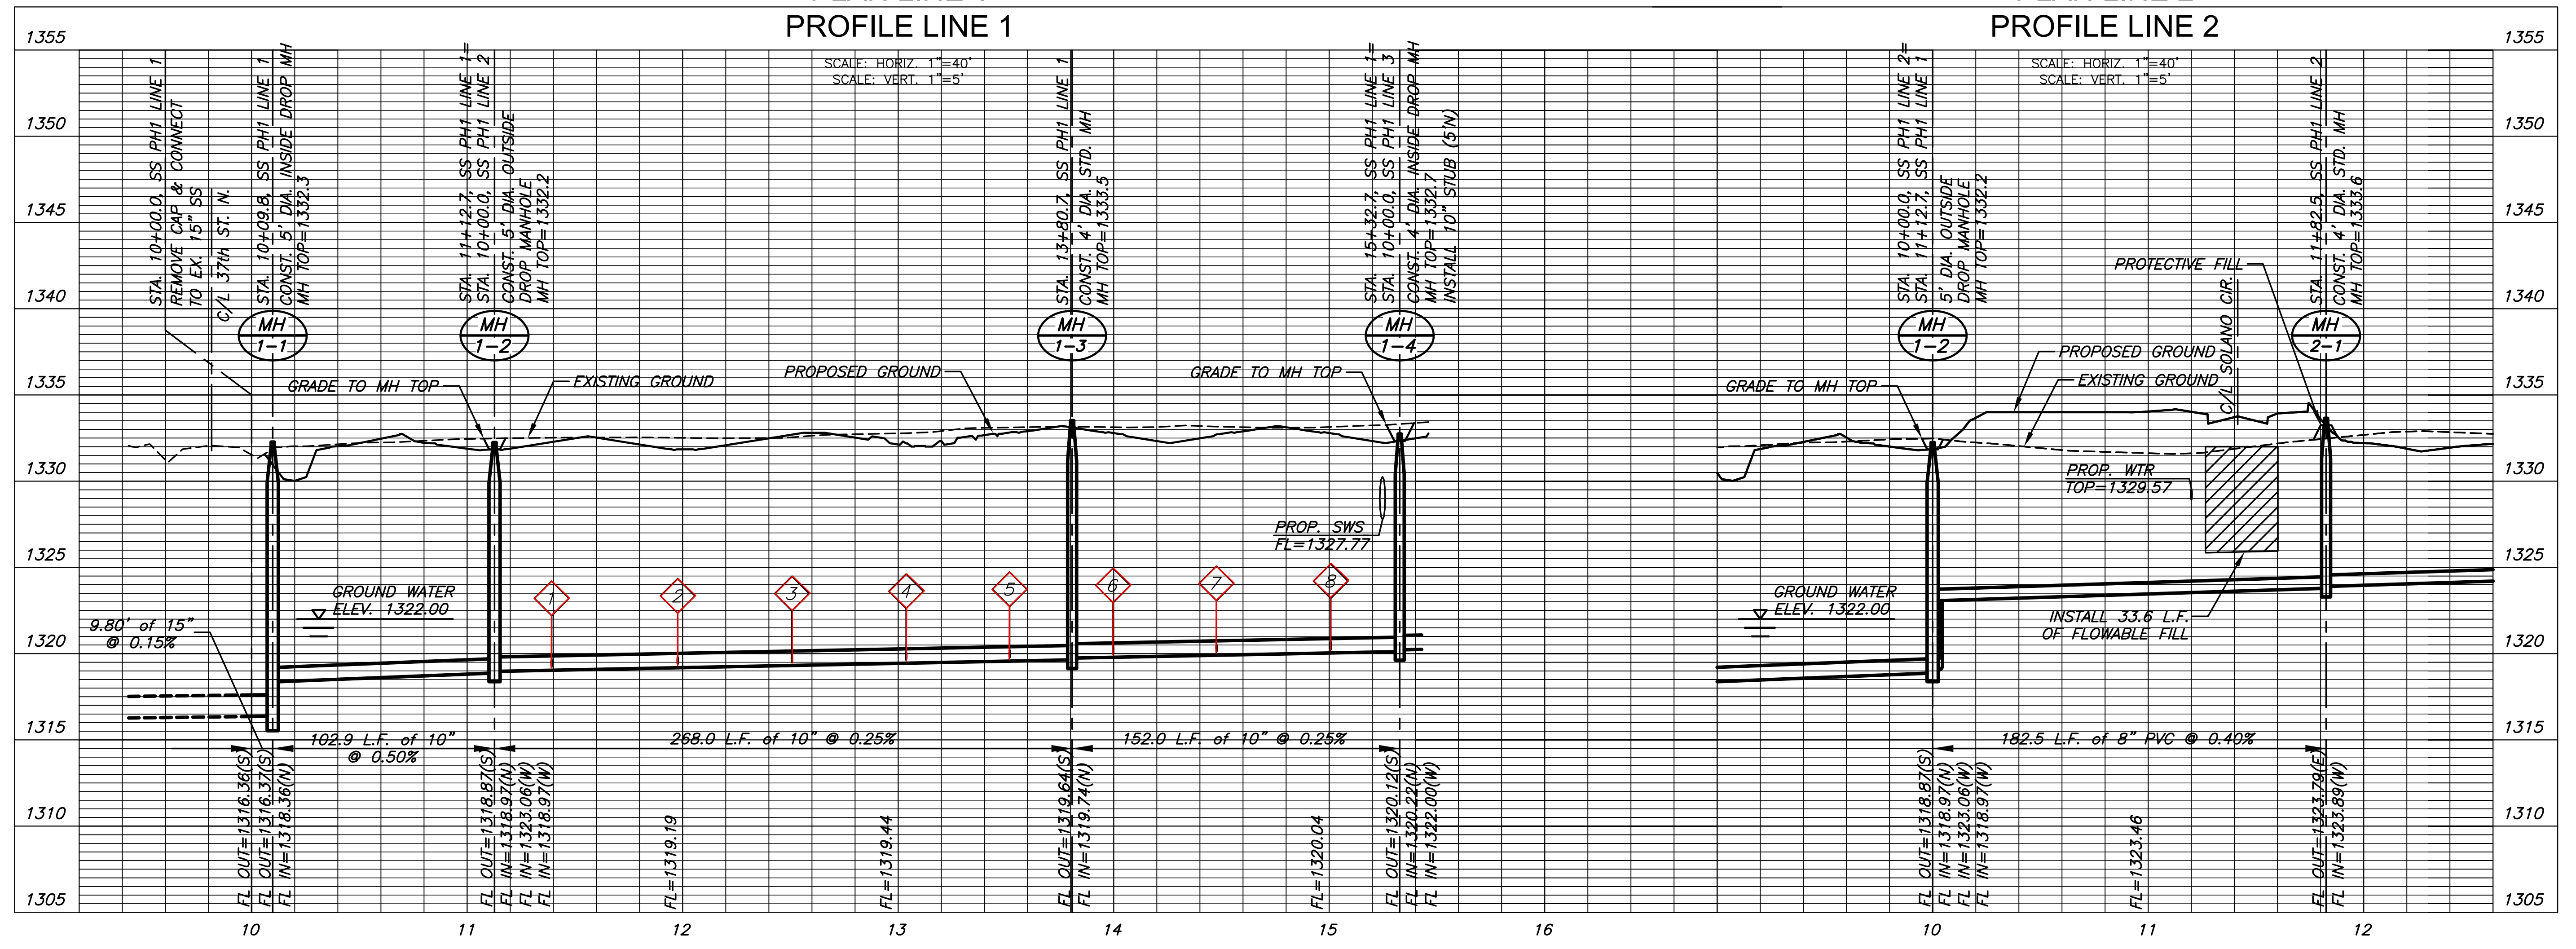

NO.	REVISION	DATE