
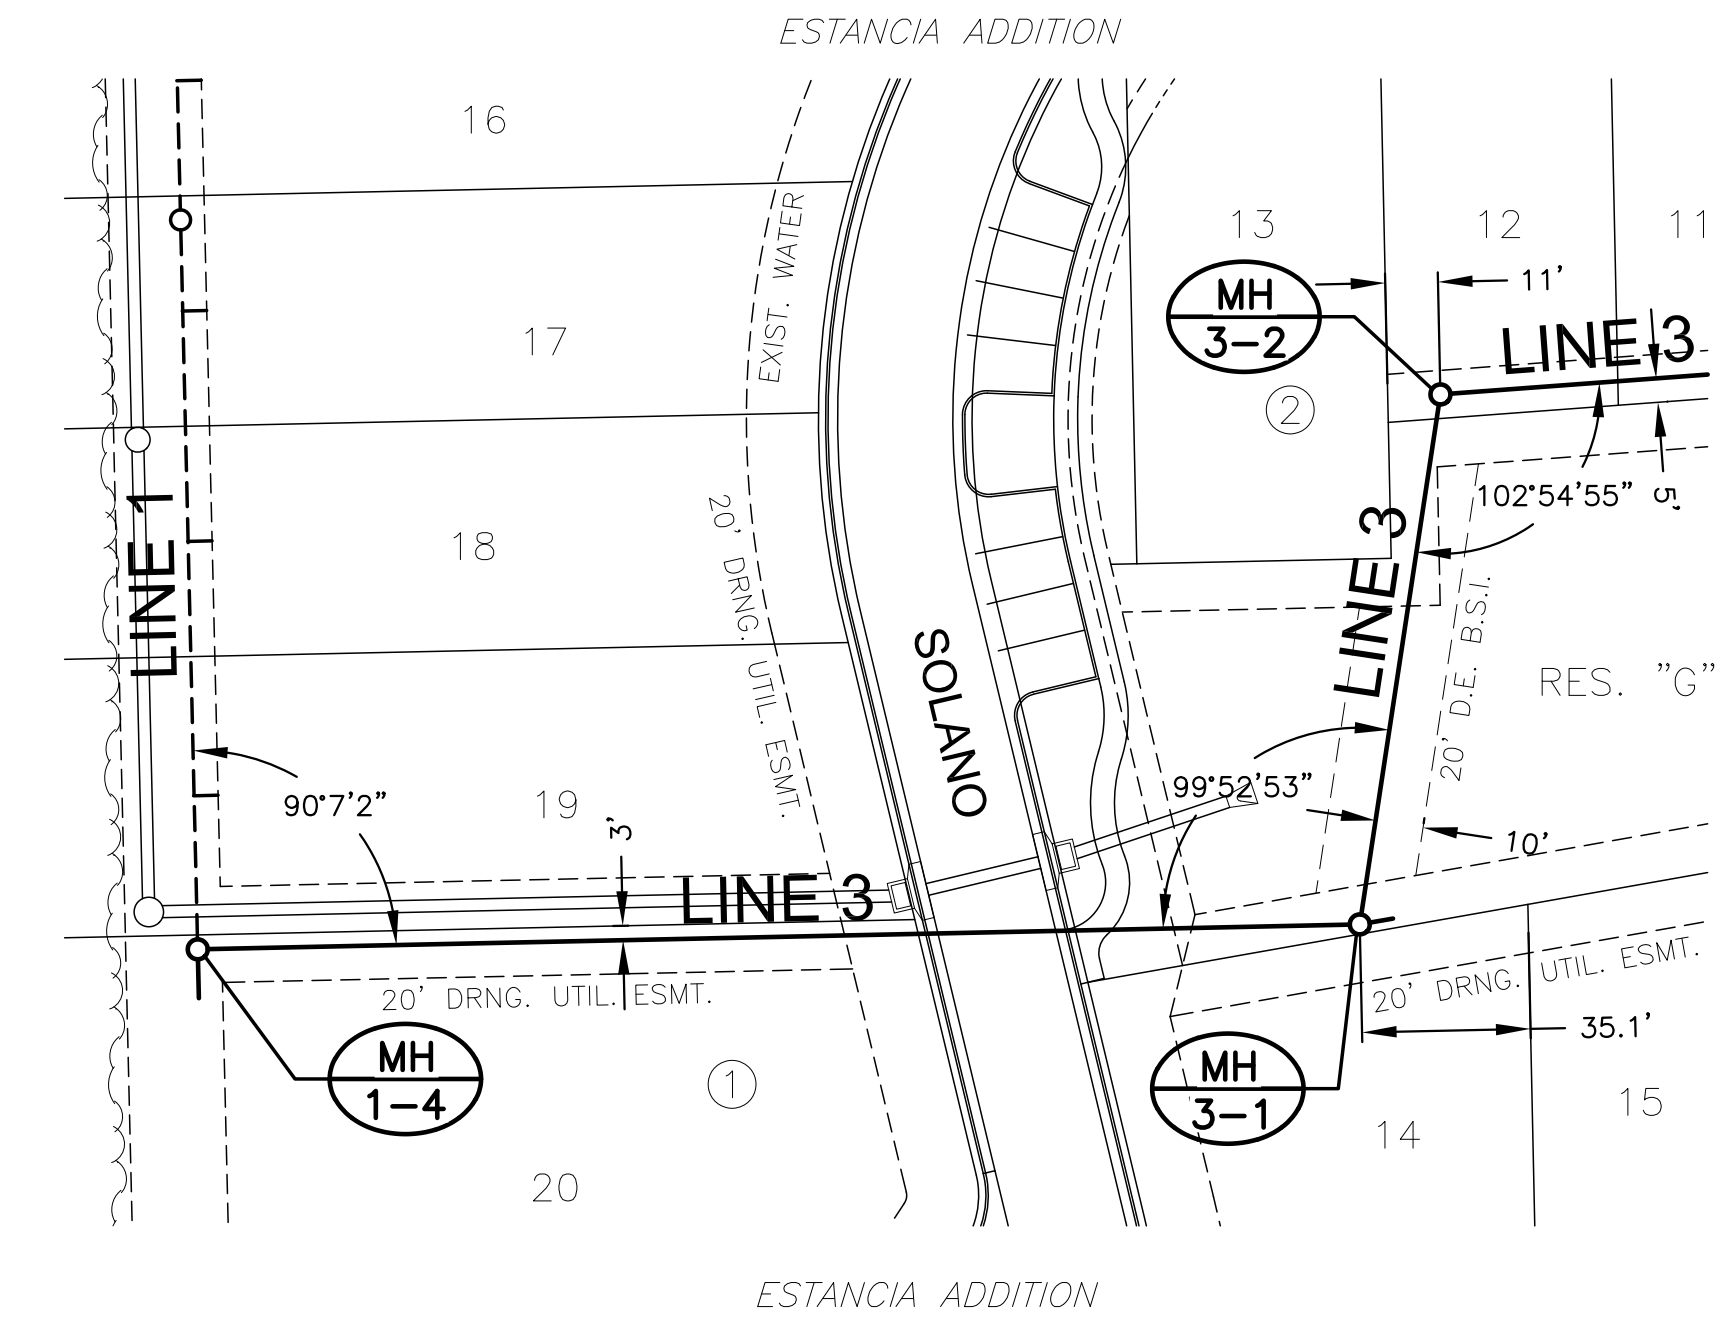


J:\PROJECTS\2015\10\10\10462 - PREMIER ESTANCIA\DWG\CAD\RESIDENTIAL\14462-SP-026.DWG  
 PLOTTED: Wednesday, October 14, 2015 @ 11:46AM

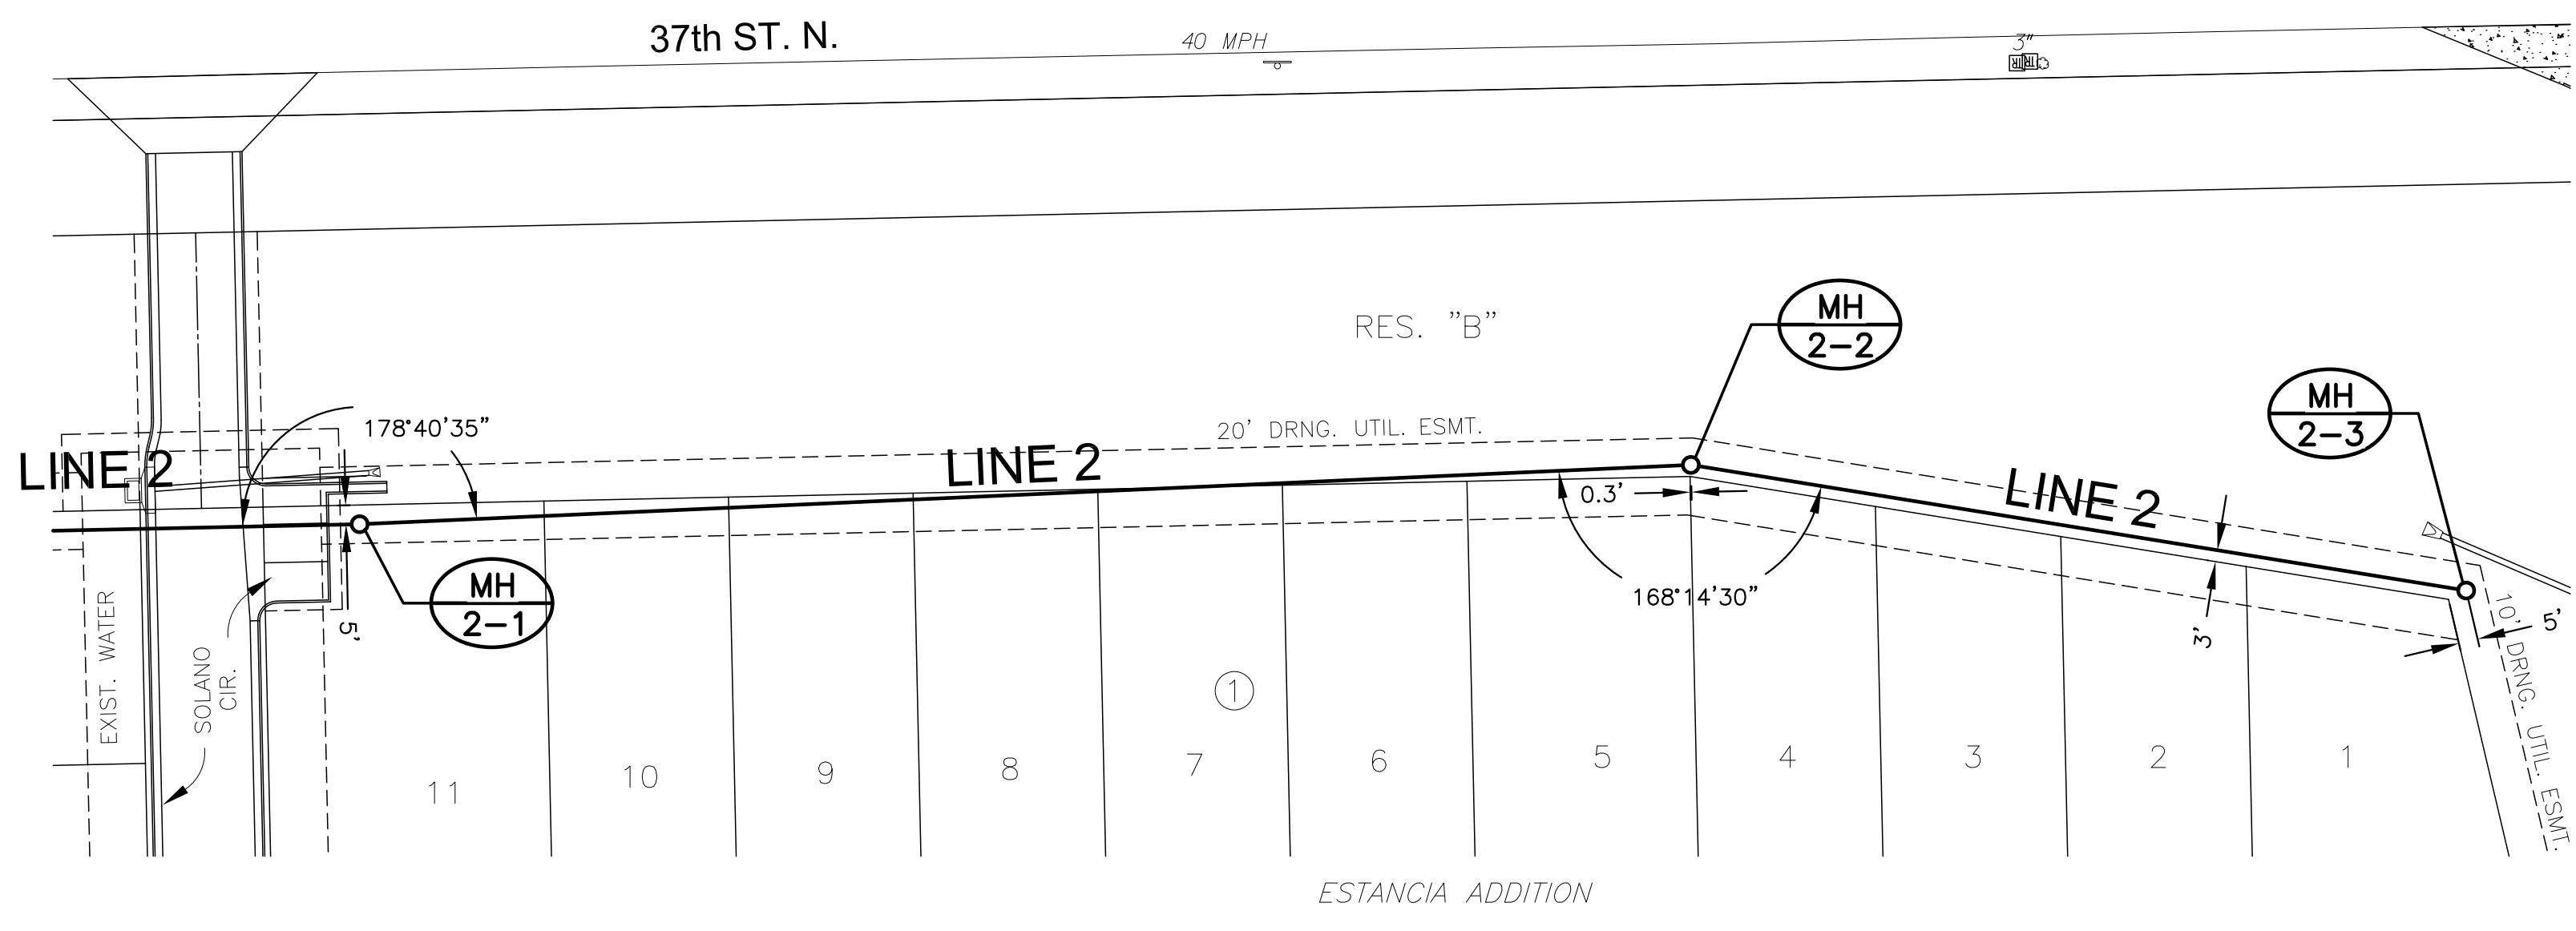


GREGORY J. ALLISON  
 LICENSED PROFESSIONAL ENGINEER  
 KANSAS  
 11159  
 10/13/15

**NOTE:**  
CONTRACTOR TO VERIFY THE DEPTH AND LOCATION OF EXISTING UTILITIES PRIOR TO CONSTRUCTION.

**PLAN LINE 2 (CONT.)**  
**PROFILE LINE 2 (CONT.)**

BUILT PER PLAN -twd

**PLAN LINE 3**  
**PROFILE LINE 3**

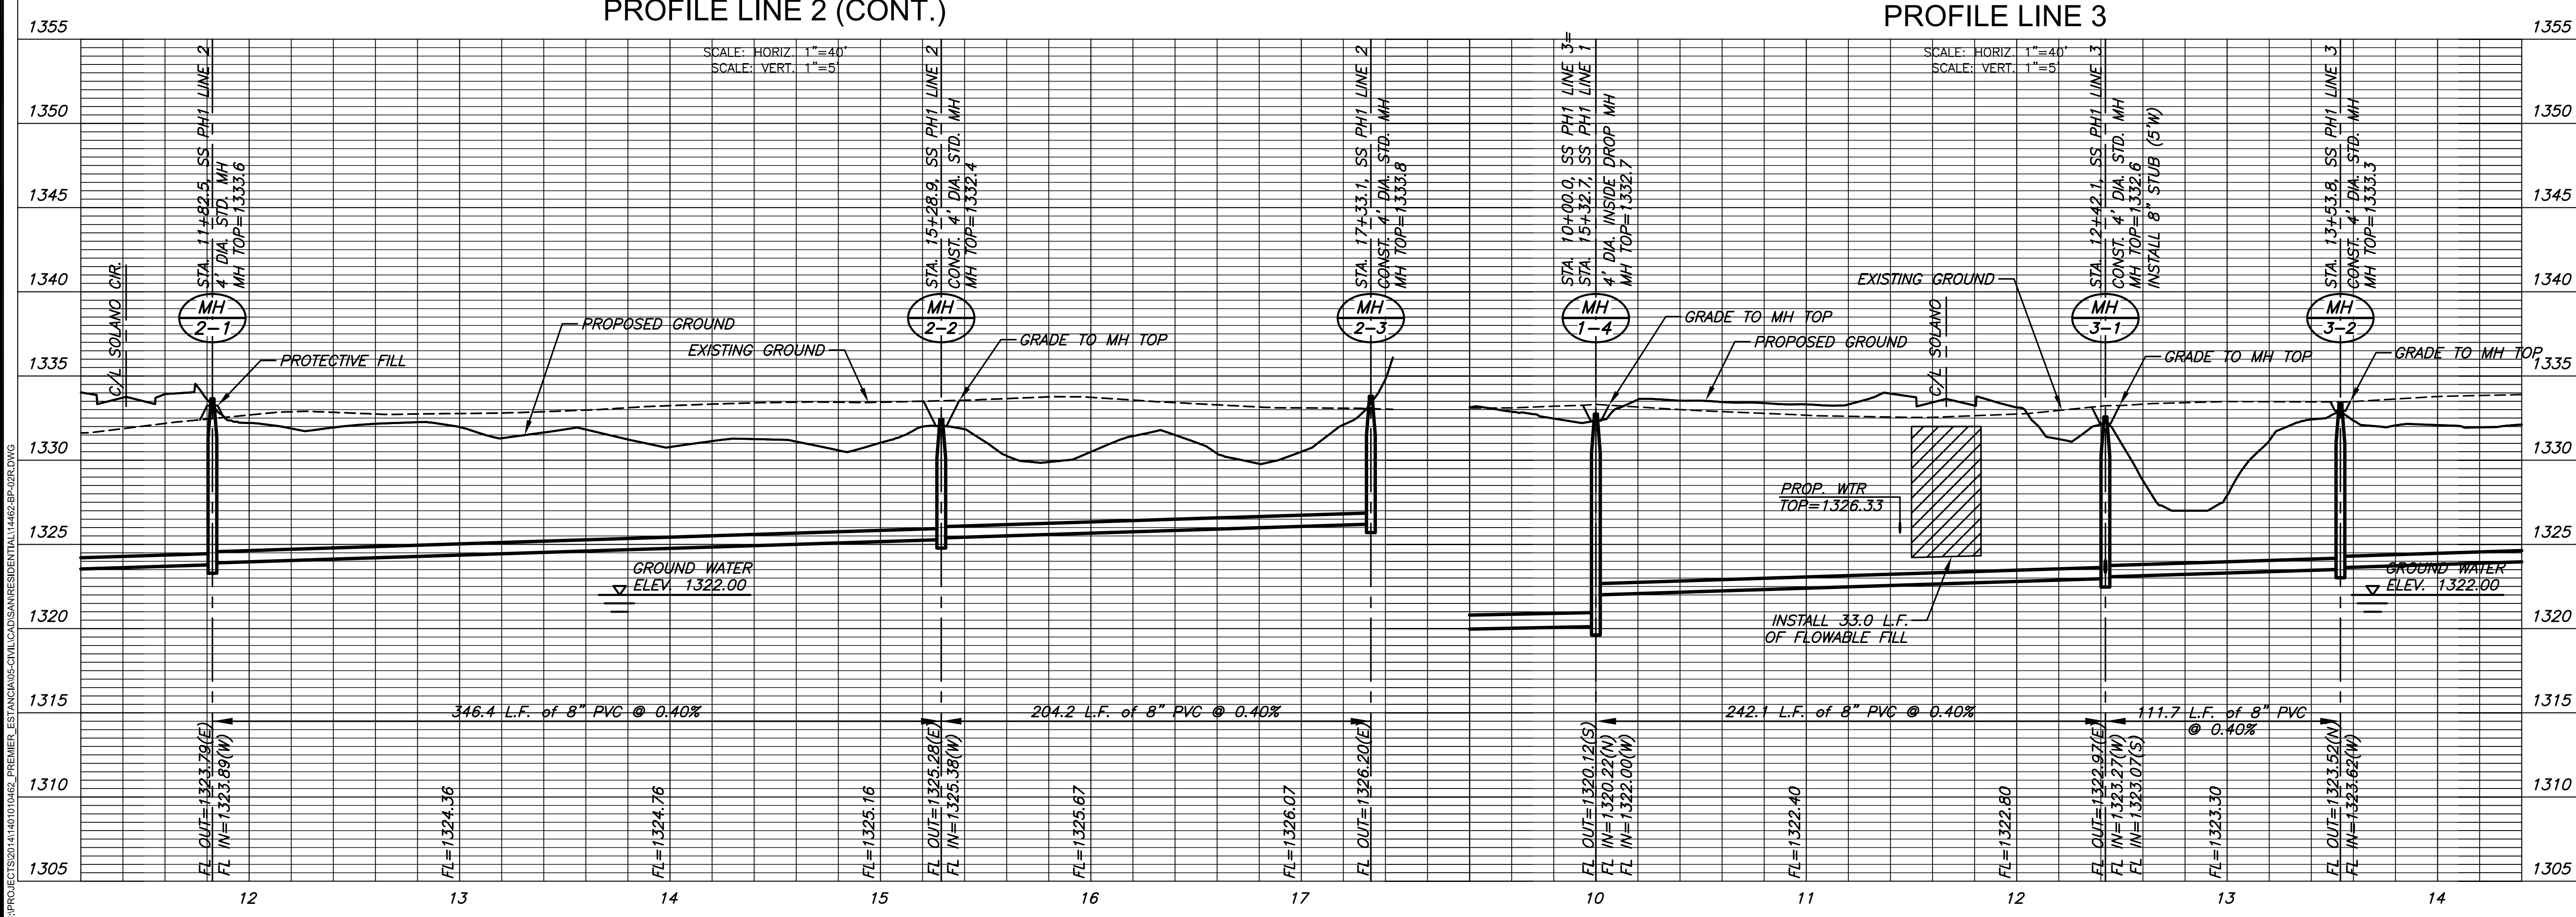

©2015  
 MKEC Engineering  
 All Rights Reserved  
 www.mkec.com  
 These drawings and their contents, including, but not limited to, all concepts, designs, & ideas are the exclusive property of MKEC Engineering (MKEC), and may not be used or reproduced in any way without the express consent of MKEC.

<b>LINES 2 &amp; 3</b>		
PROJECT NO.	468-850785	
DATE	OCT. 2015	
SCALE	1" = 40'	
DESIGNED	DRAWN	CHECKED
DFL	JWC	GJA
NO.	REVISION	DATE
SHEET NO.		
6 OF 20		