



PLOTTED: Wednesday, October 14, 2015 @ 11:54AM

J:\PROJECTS\2015\1401010462_PREMIER_ESTANCIA\DWG\CIVIL\CAD\RESIDENTIAL\1462-8P404R CONT.DWG

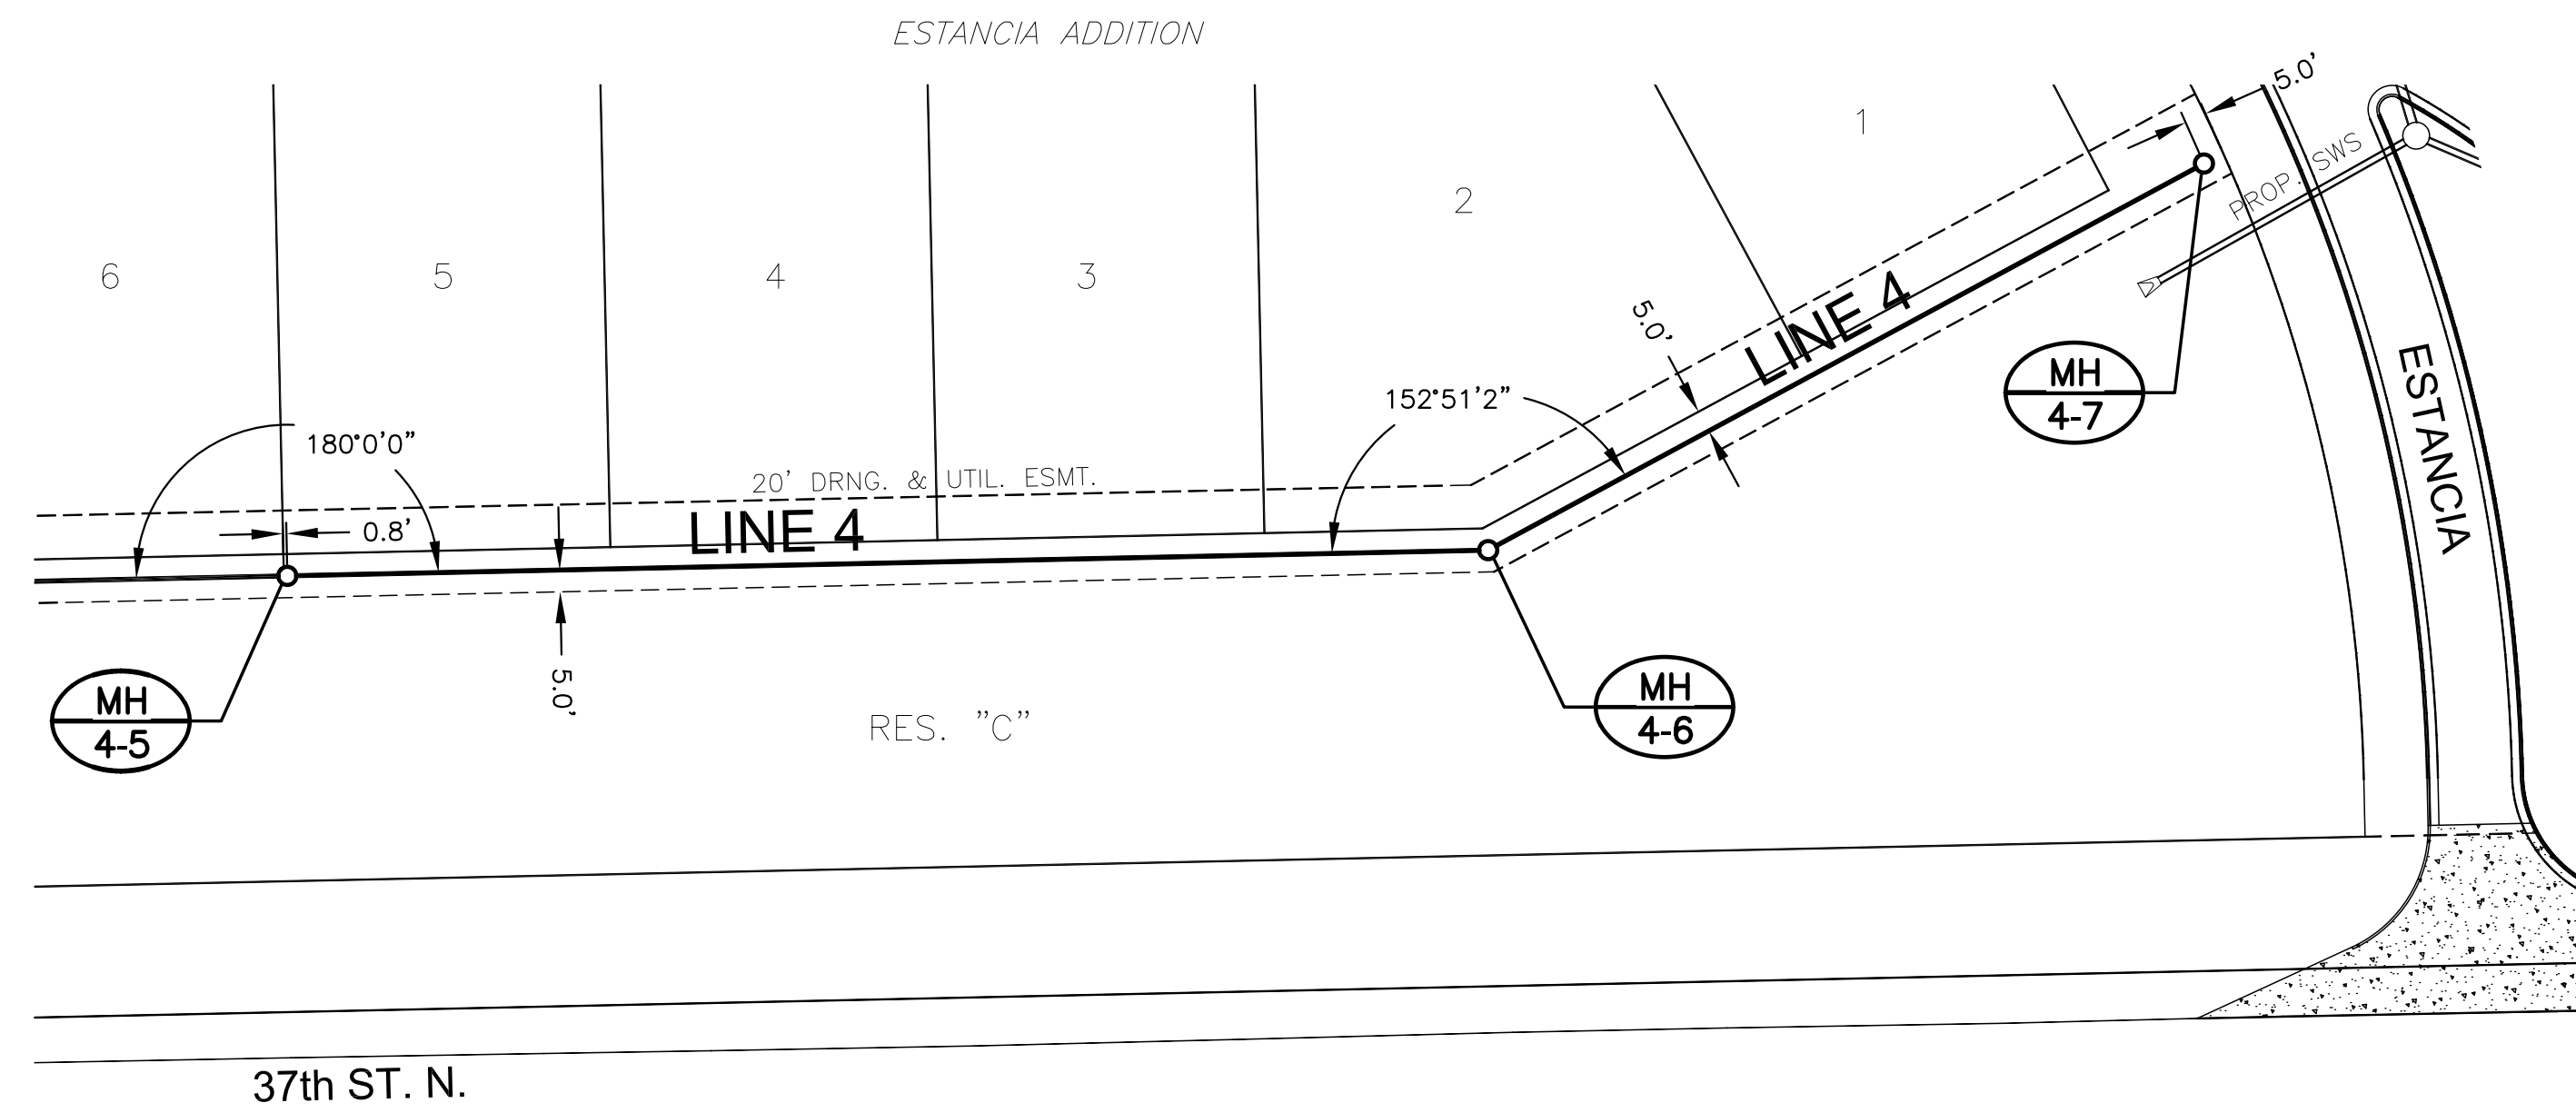


37th ST. N.

BUILT PER PLAN -twd

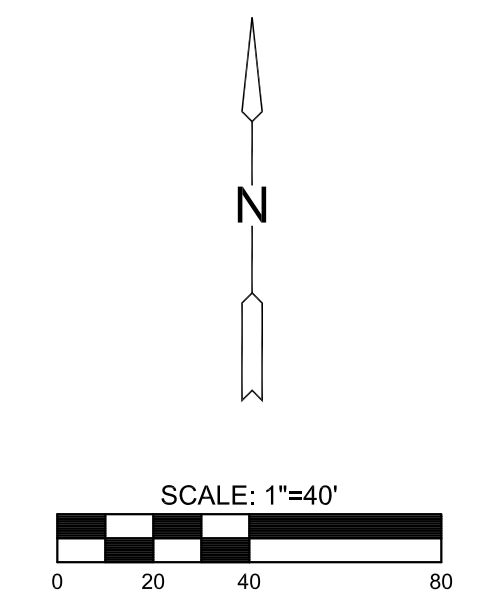

NOTE:
CONTRACTOR TO VERIFY THE DEPTH AND LOCATION OF EXISTING UTILITIES PRIOR TO CONSTRUCTION.

PLAN LINE 4 (CONT.)
PROFILE LINE 4 (CONT.)

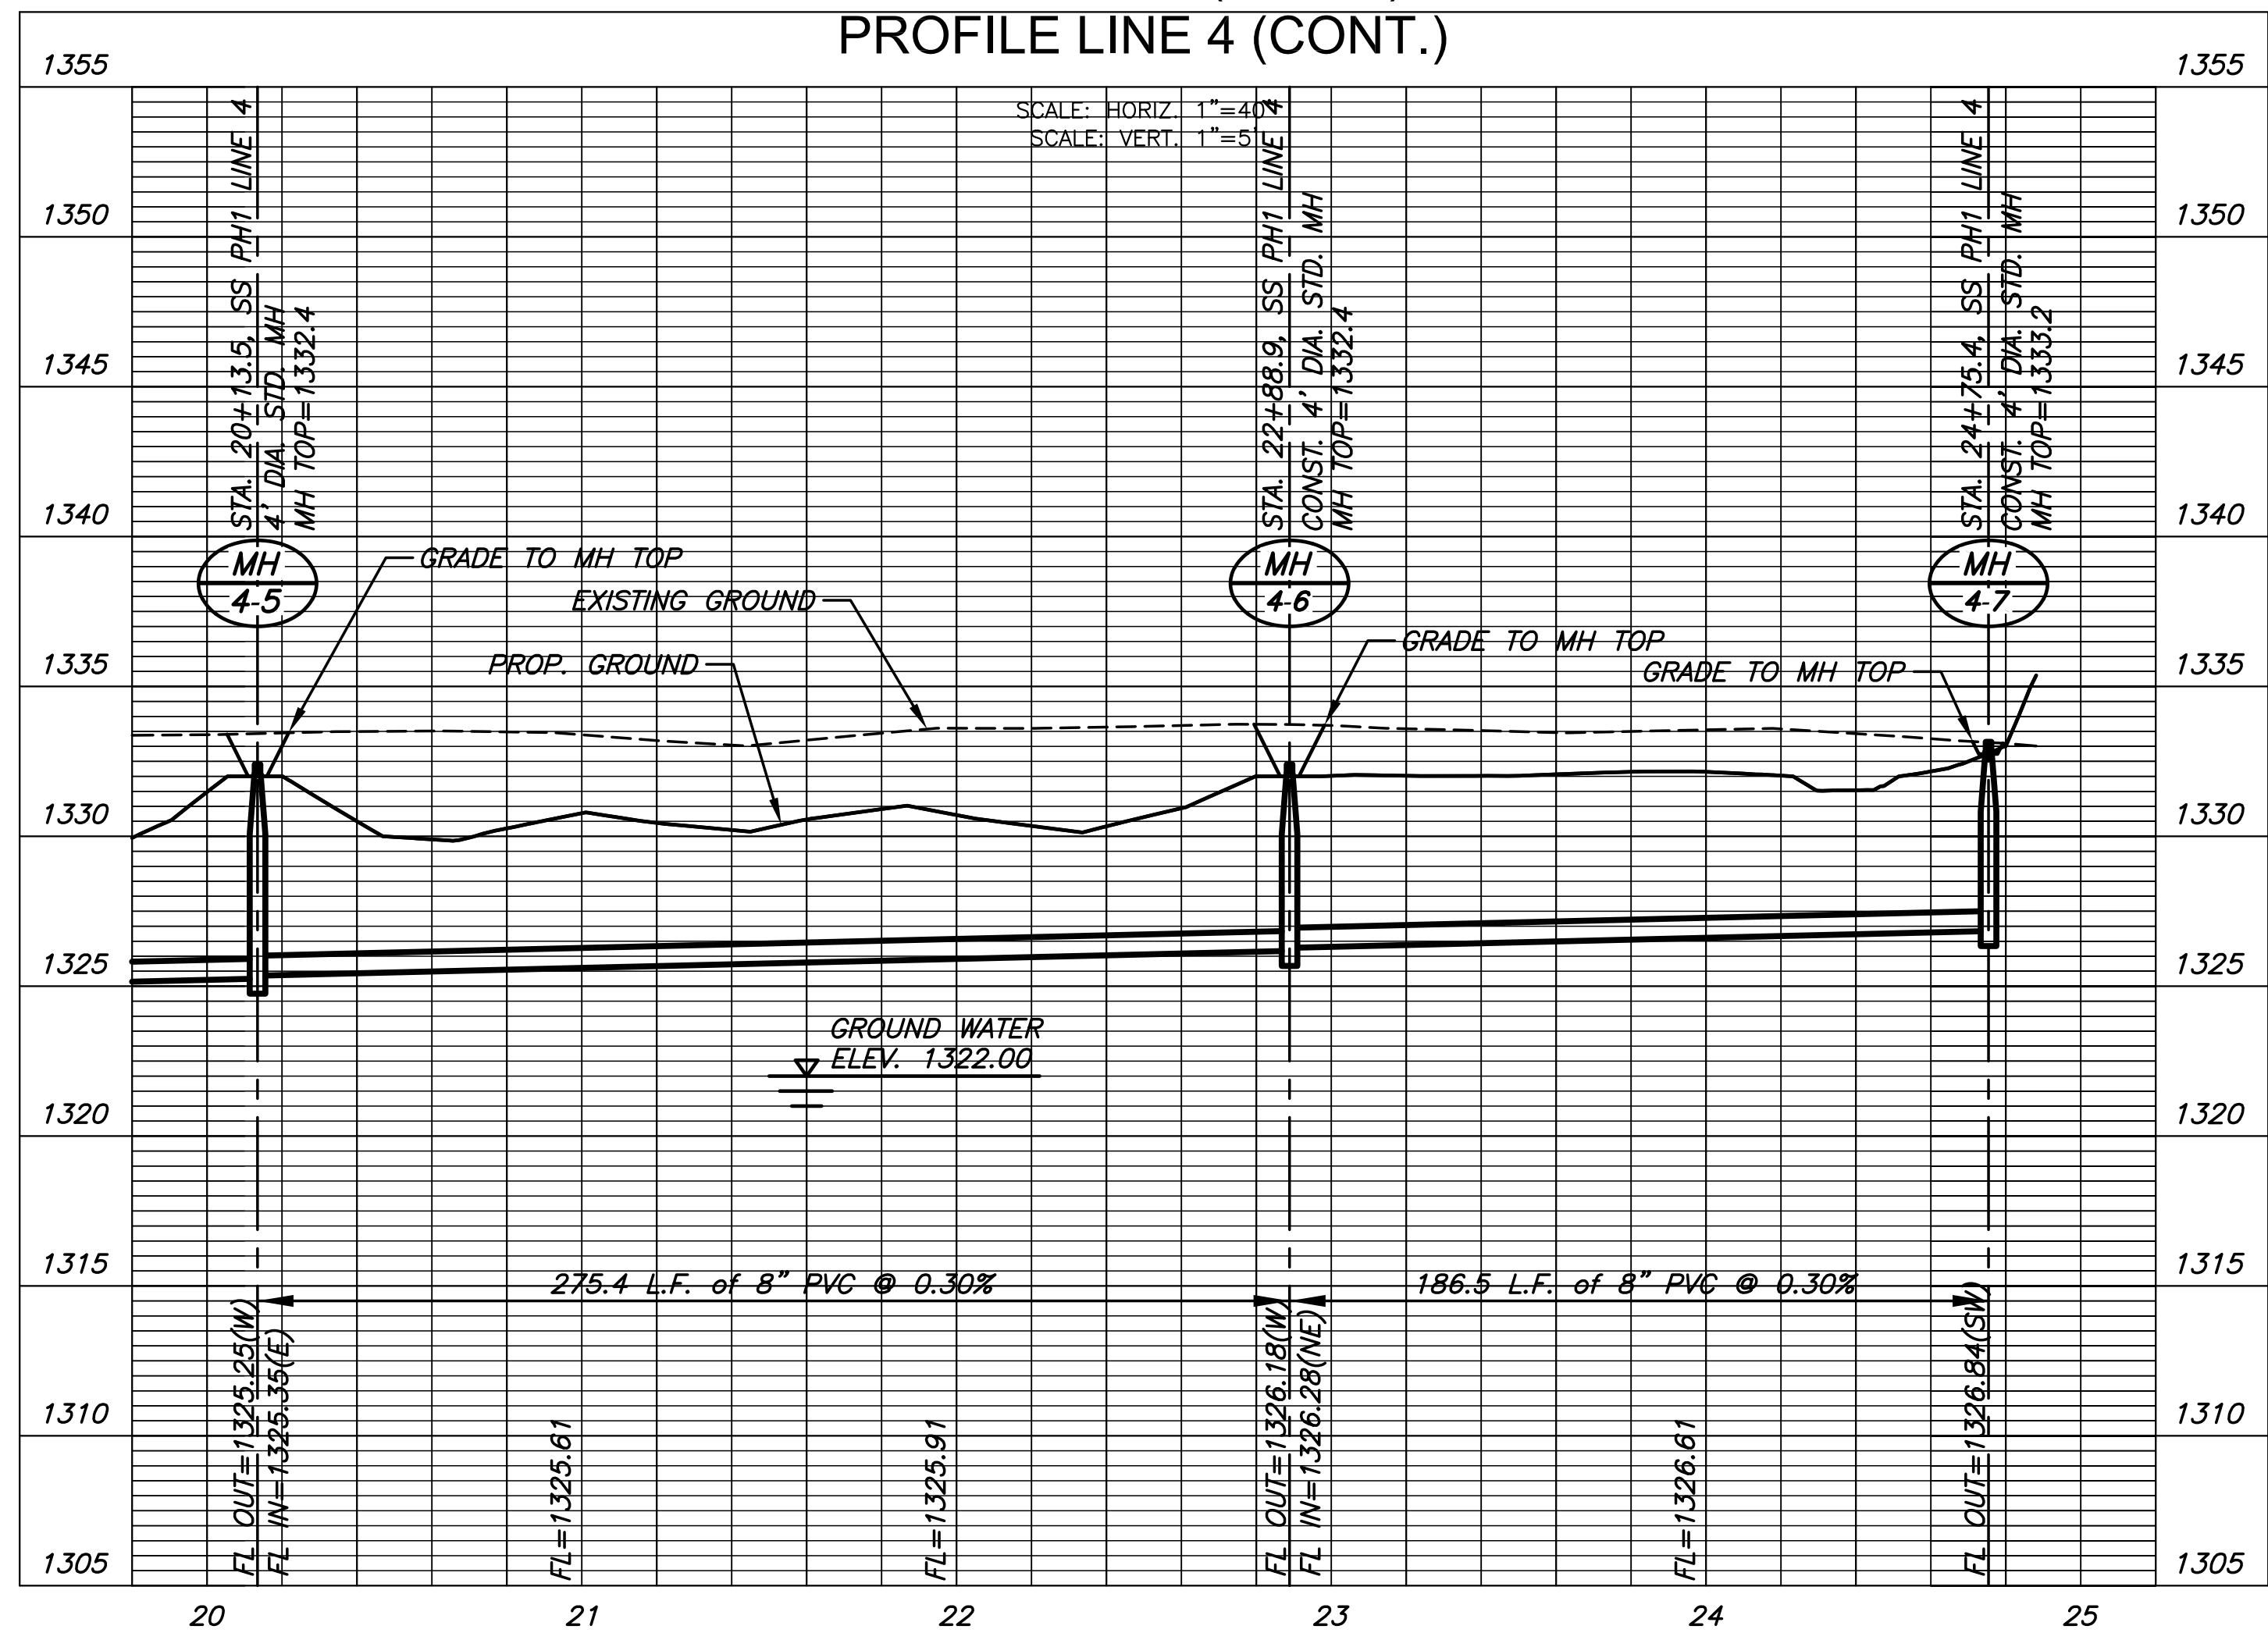

GREGORY J. ALLISON
LICENSED PROFESSIONAL ENGINEER
KANSAS
11159
10/13/15



SANITARY SEWER PLANS FOR
ESTANCIA ADDITION
RESIDENTIAL PHASE 1

©2015 MKEC Engineering All Rights Reserved
www.mkec.com
These drawings and their contents, including, but not limited to, all concepts, designs, & ideas are the exclusive property of MKEC Engineering (MKEC), and may not be used or reproduced in any way without the express consent of MKEC.

LINE 4 CONT.

PROJECT NO.	468-850785
DATE	OCT. 2015
SCALE	1"=40'
DESIGNED	DFL
DRAWN	BKS
CHECKED	GJA

NO.	REVISION	DATE

SHEET NO.