

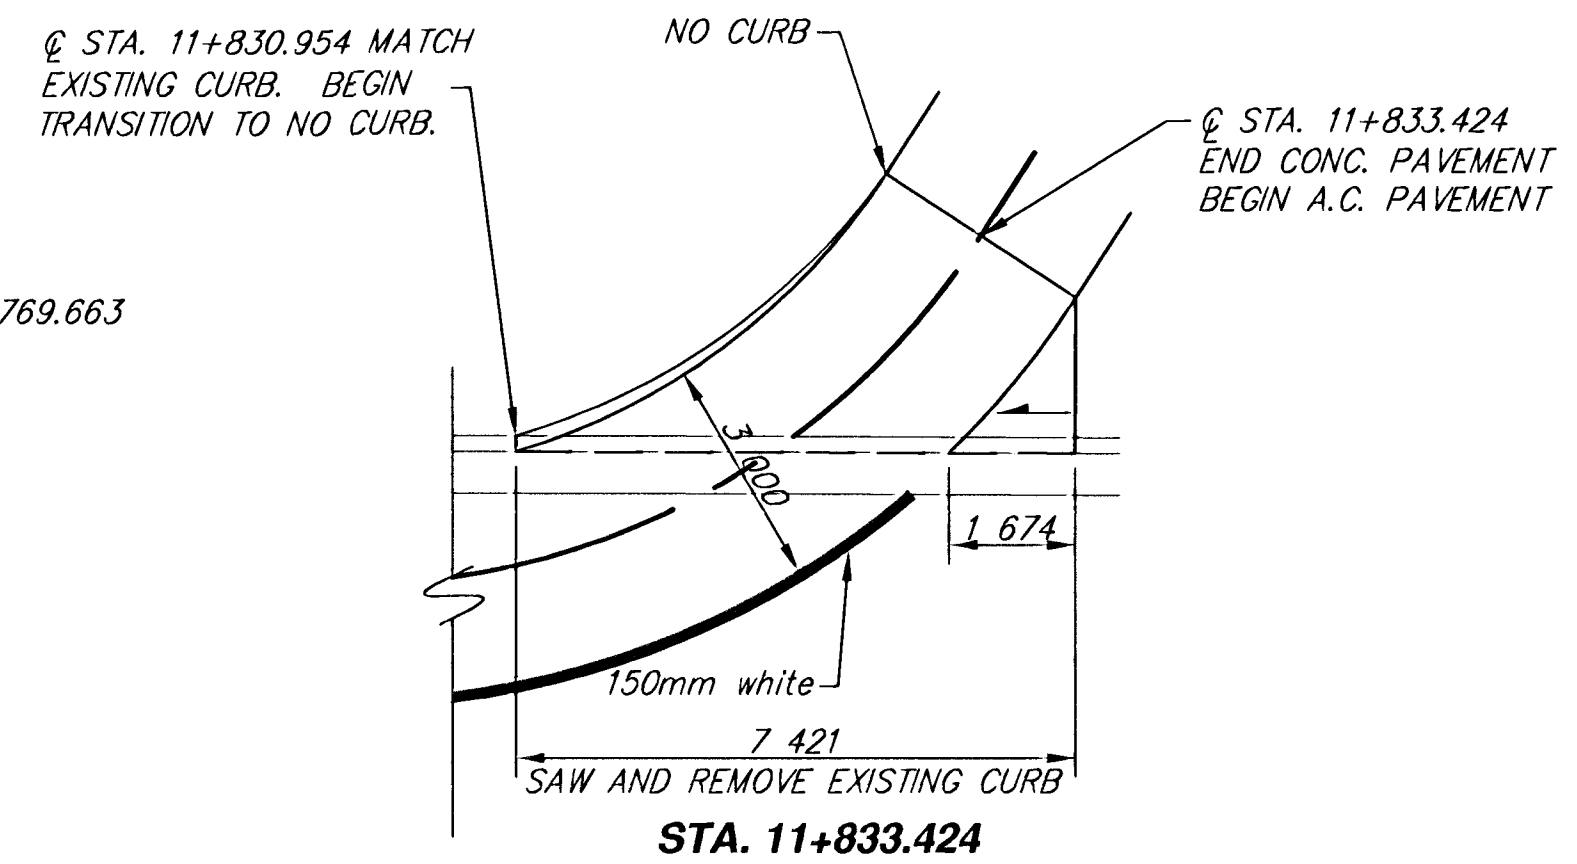


FHWA REGION NO.	STATE	PROJECT NUMBER	FISCAL YEAR	SHEET NUMBER	TOTAL SHEETS
7	KANSAS	871E-0115-01	1997	34	49

DATE	BY	REFERENCES NOTED	REFERENCES CHECKED

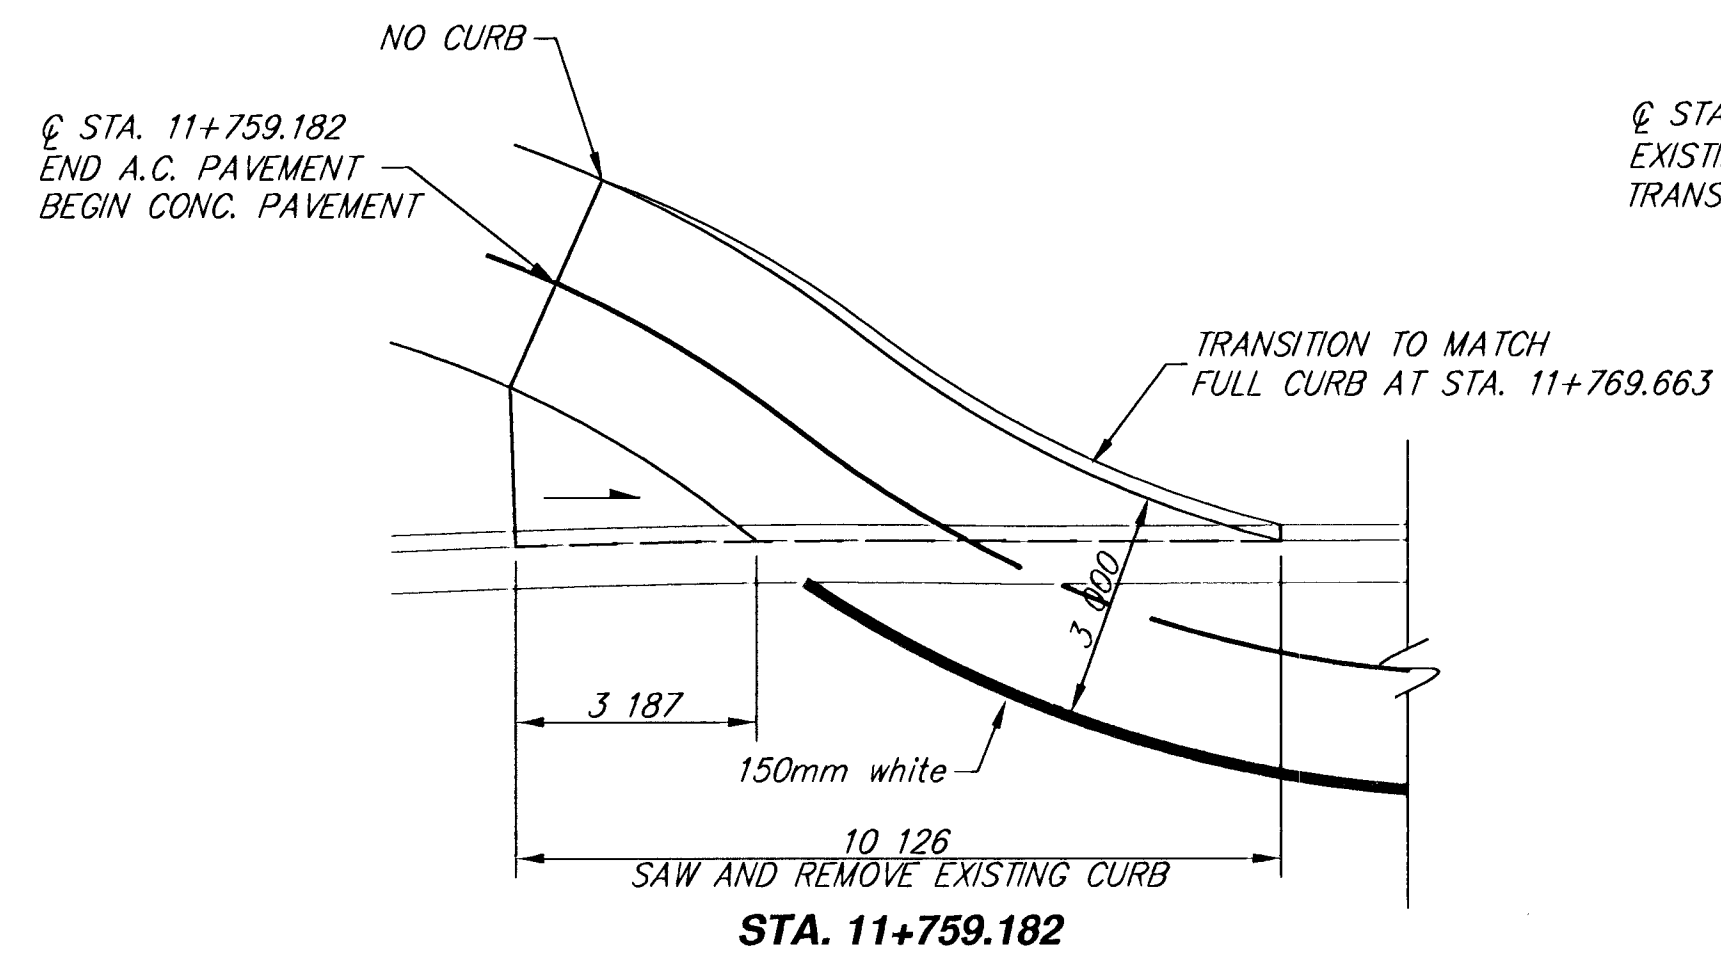

SPECIAL RAMPS

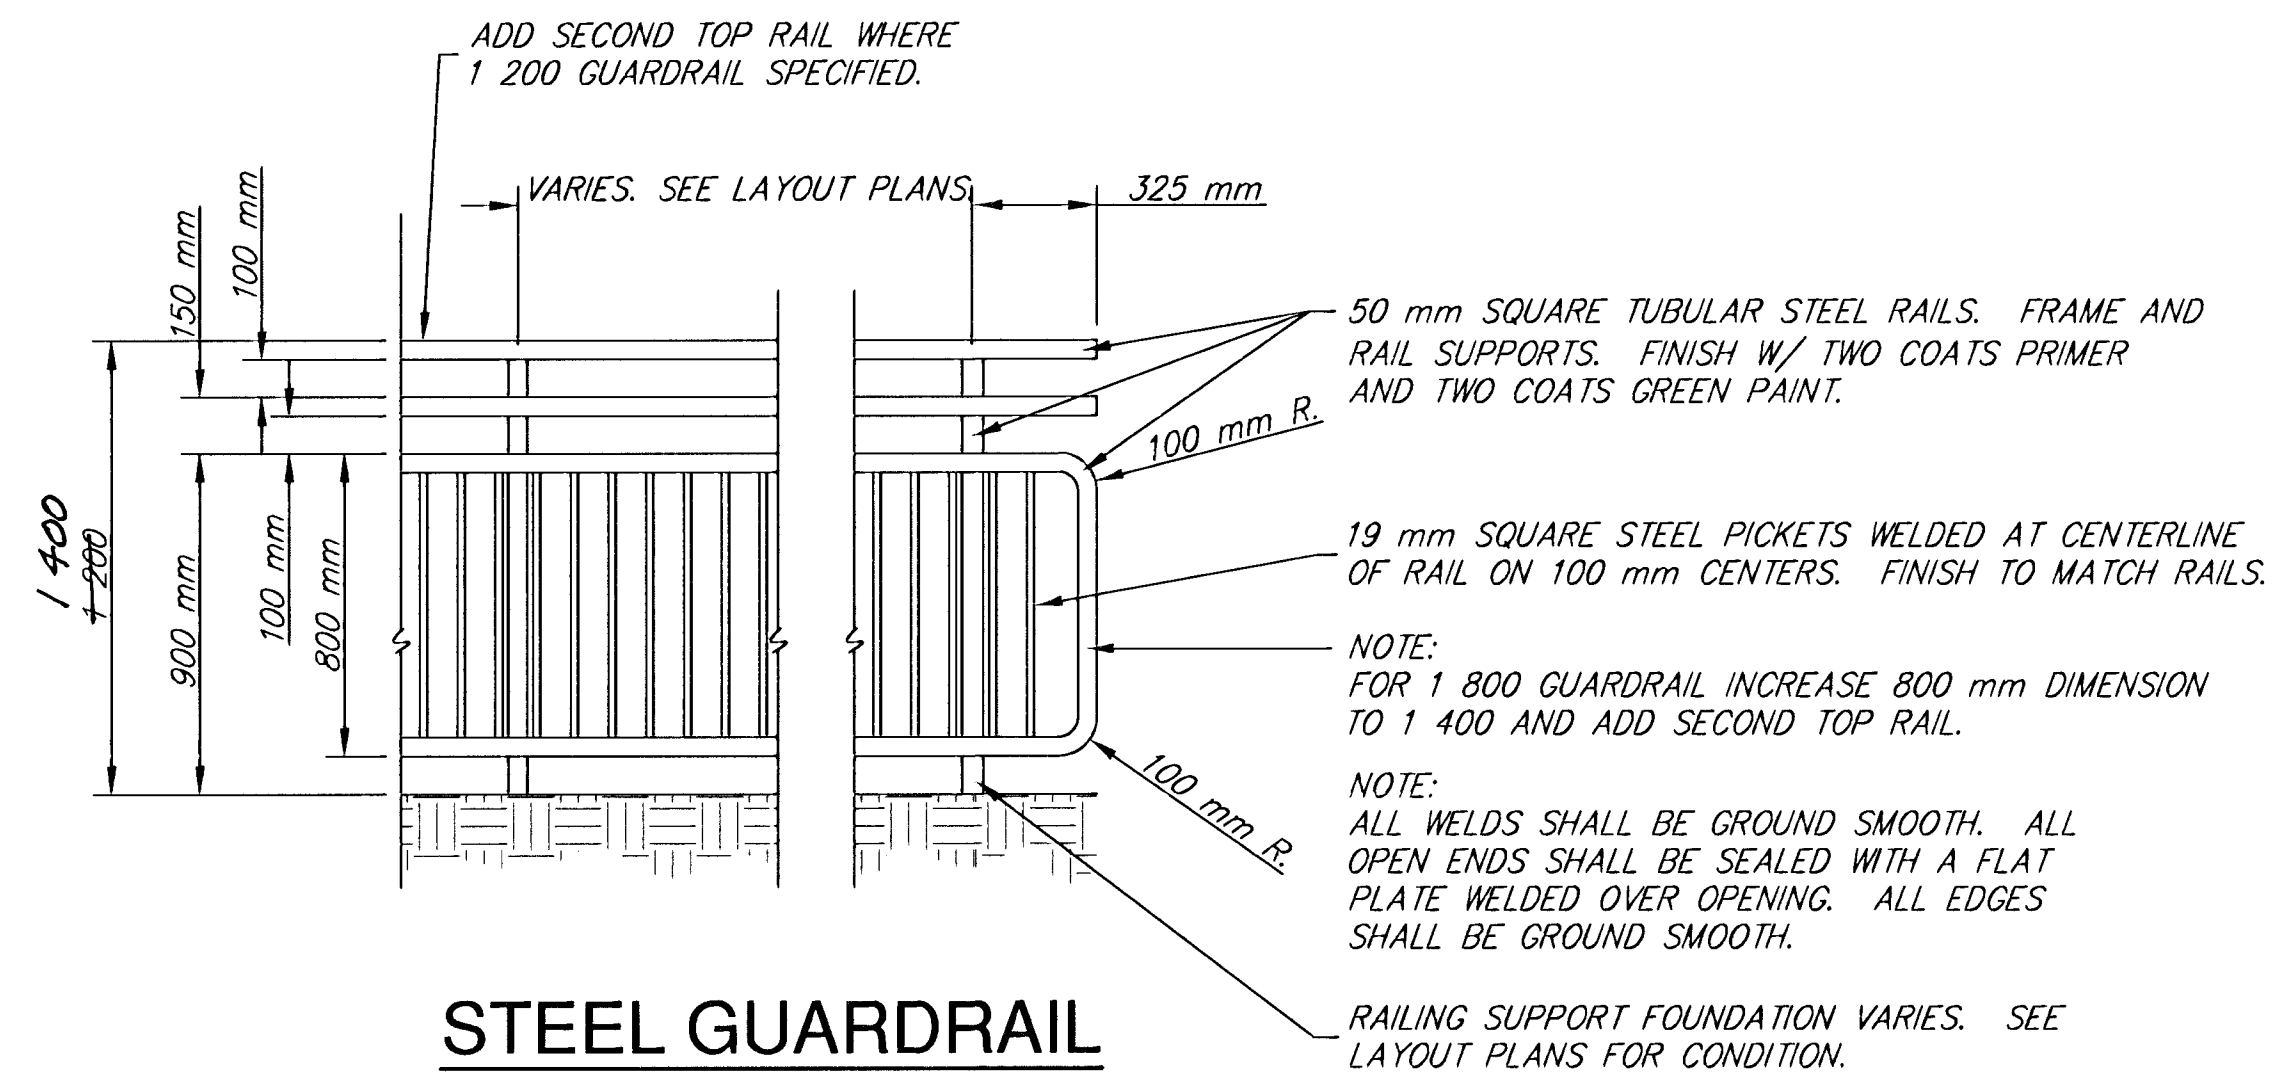

K96 BIKEPATH MISCELLANEOUS DETAILS					
SRB		924 NORTH MAIN WICHITA, KANSAS 67203 www.srb1.com	316-264-8008 FAX 264-4621 E-Mail: w@wob1.com	REVISED	
SAVOY, RUGGLES & BOHM, P. A. ENGINEERING & SURVEYING					34
PROJECT NUMBER					49
DRAWN JTS	DESIGN T.C.R.	REVIEW	DATE June 27, 2001	UTILITY SRB JOB 1554T	