


FHWA REGION NO.	STATE	PROJECT NO.	YEAR	SHEET NO.	TOTAL SHEETS
7	KANSAS	87 N-0212-01	2002	29	59

Plotted By : J. TRUMPP
Plot File : 2232SIG
Plot Date : 4-25-02


Std. Base File :
Server File :
Server :
View =

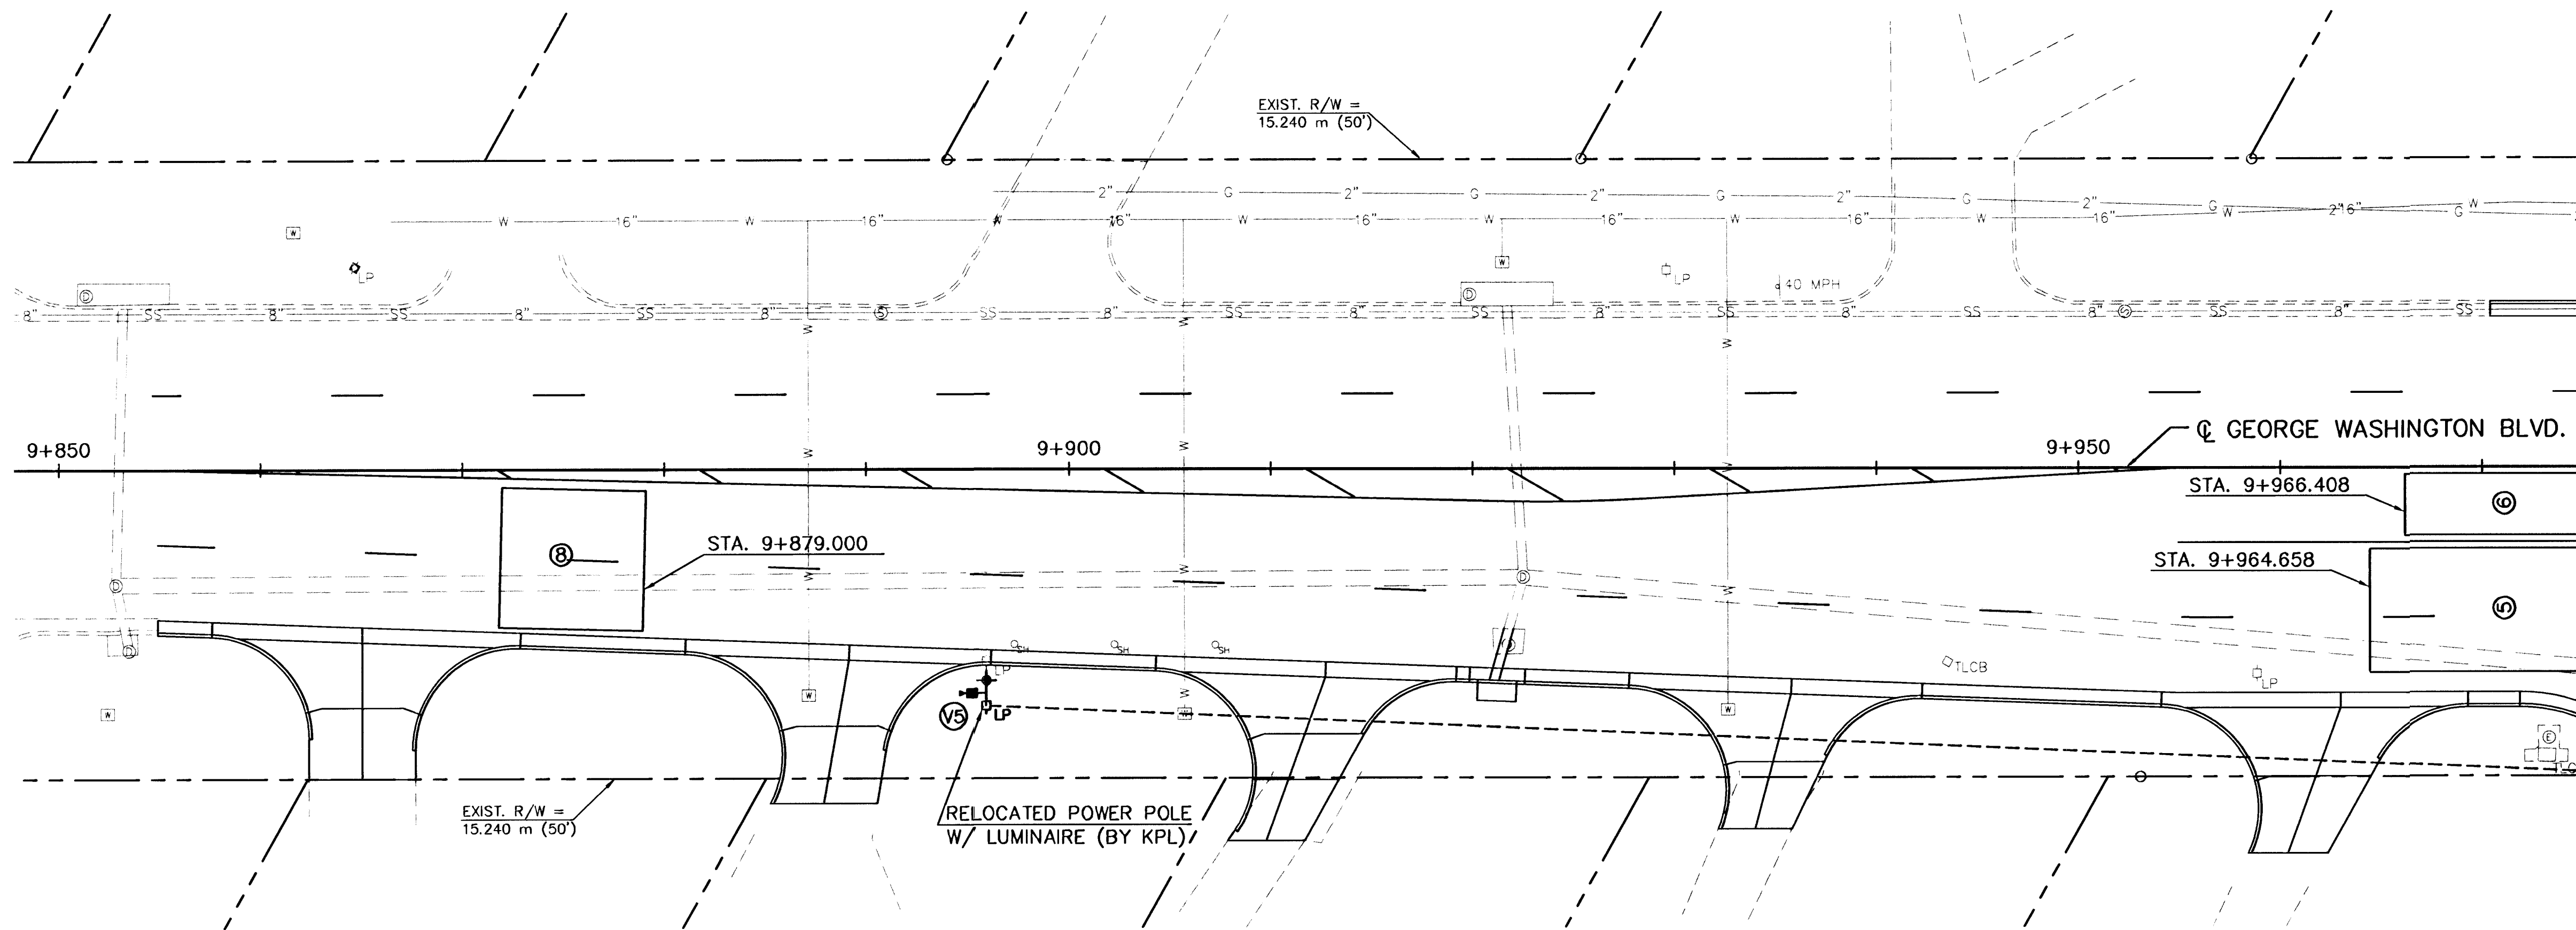


SCALE 1:200

LEGEND

- MAST ARM MOUNTED TRAFFIC SIGNAL W/ BACKPLATE (LENGTH OF MAST ARM)
- VERTICAL BRACKET MOUNTED TRAFFIC SIGNAL
- TRAFFIC SIGNAL POLE
- TRAFFIC SIGNAL POLE DESIGNATION NUMBER
- TRAFFIC SIGNAL HEAD W/ TYPE DESIGNATION
- PEDESTRIAN SIGNAL AND PUSHBUTTON
- CONTROLLER
- SERVICE BOX
- DETECTION ZONE
- LUMINAIRE
- MOUNTED VIDEO DETECTION CAMERA
- MOUNTED VIDEO DETECTION CAMERA DESIGNATION NUMBER

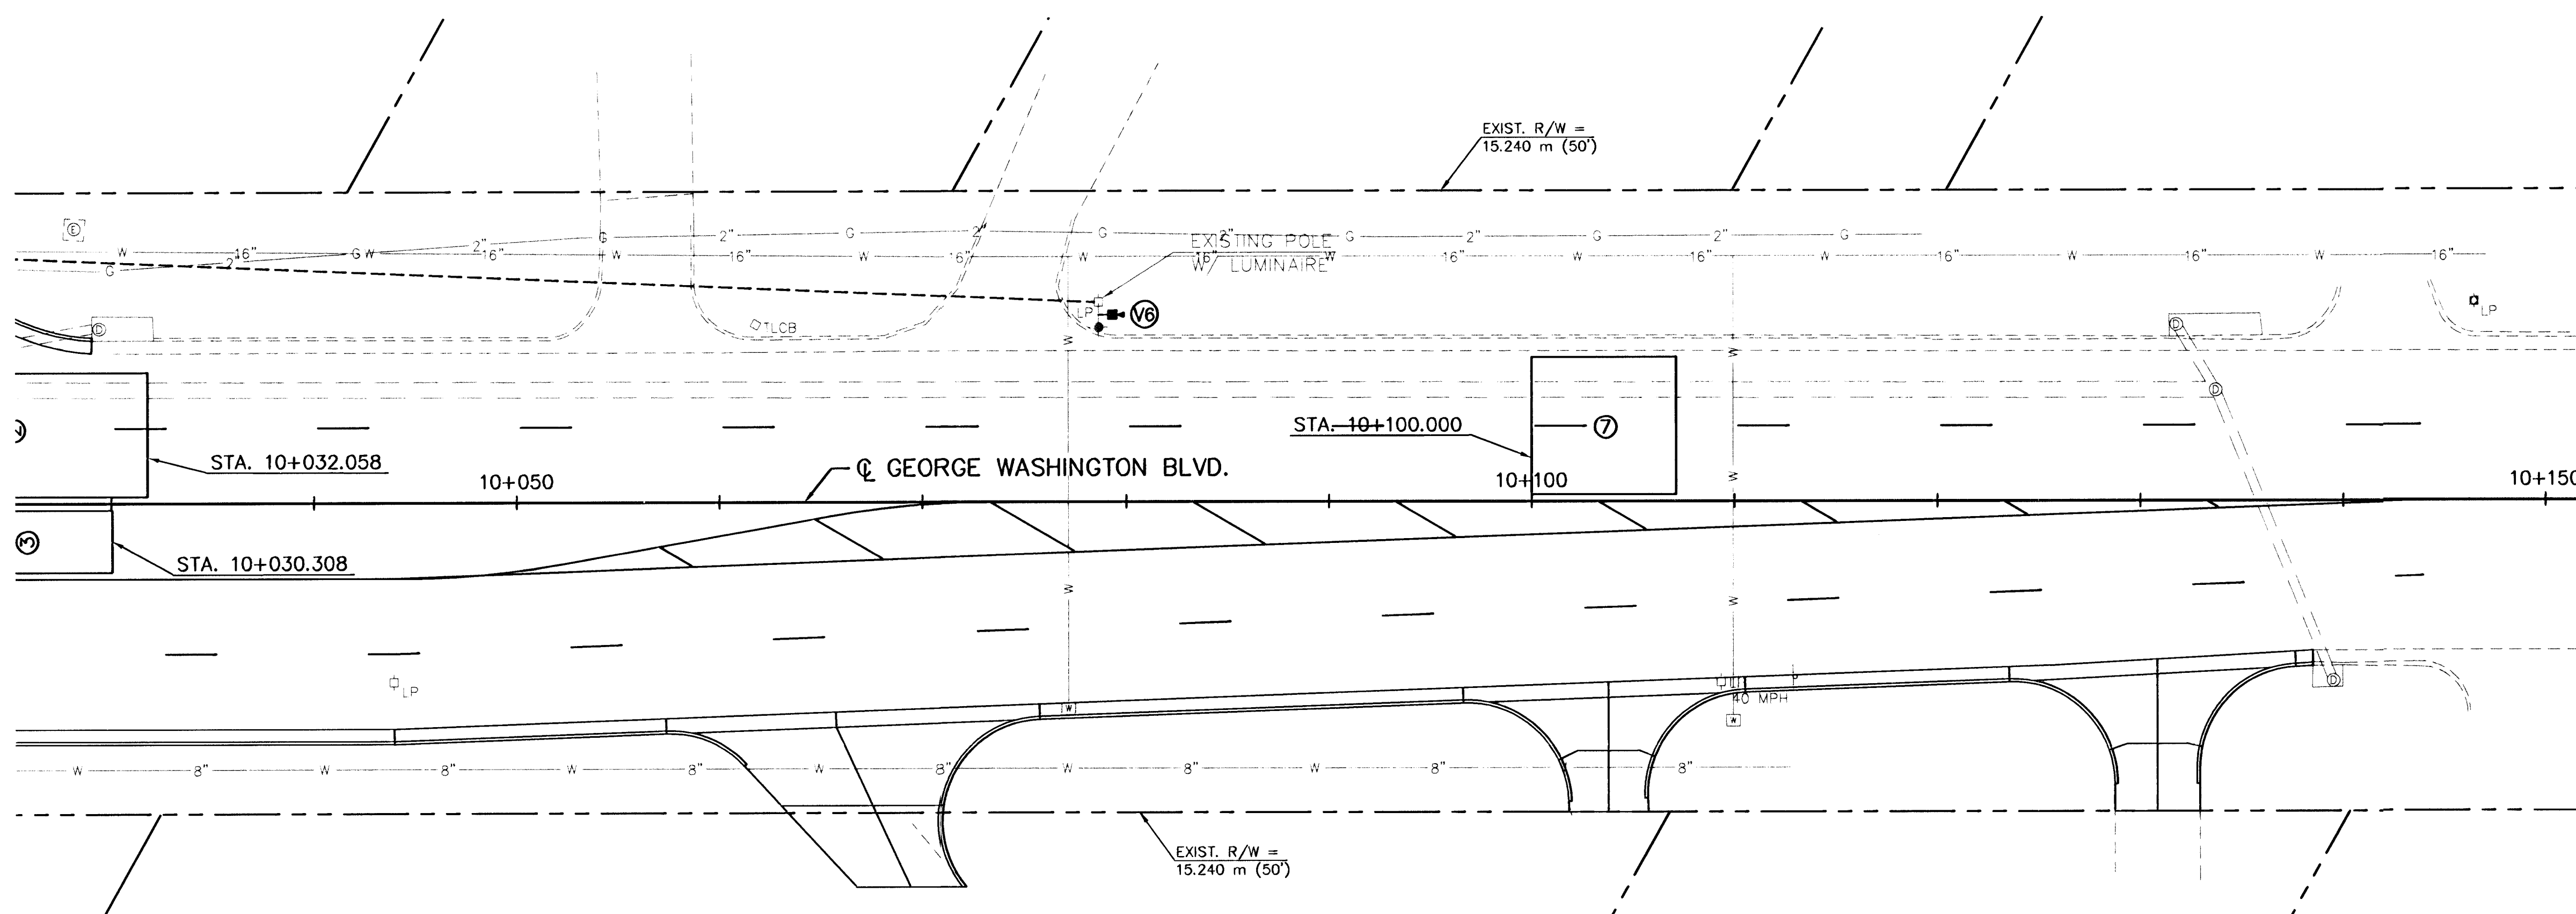

TRAFFIC SIGNAL PLAN

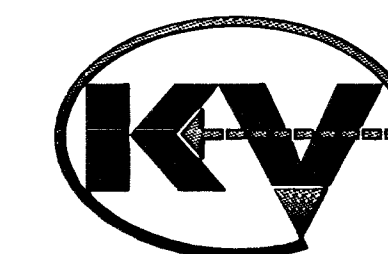

KAW VALLEY ENGINEERING
ENGINEERS AND LAND SURVEYORS
2319 NORTH JACKSON
P.O. BOX 1304
JUNCTION CITY, KANSAS 66441
(785)762-5040 FAX (785)762-7744
E-MAIL jco@kveng.com

PROJ. NO.
A02232
DATE
4-25-02
DESIGNER
CDM
DRAWN BY
JT
CHECKED BY
CFN
2232SIG
SHEET
29 OF 59