


NOTE BOOK TEMPLATE AREAS CHECKED

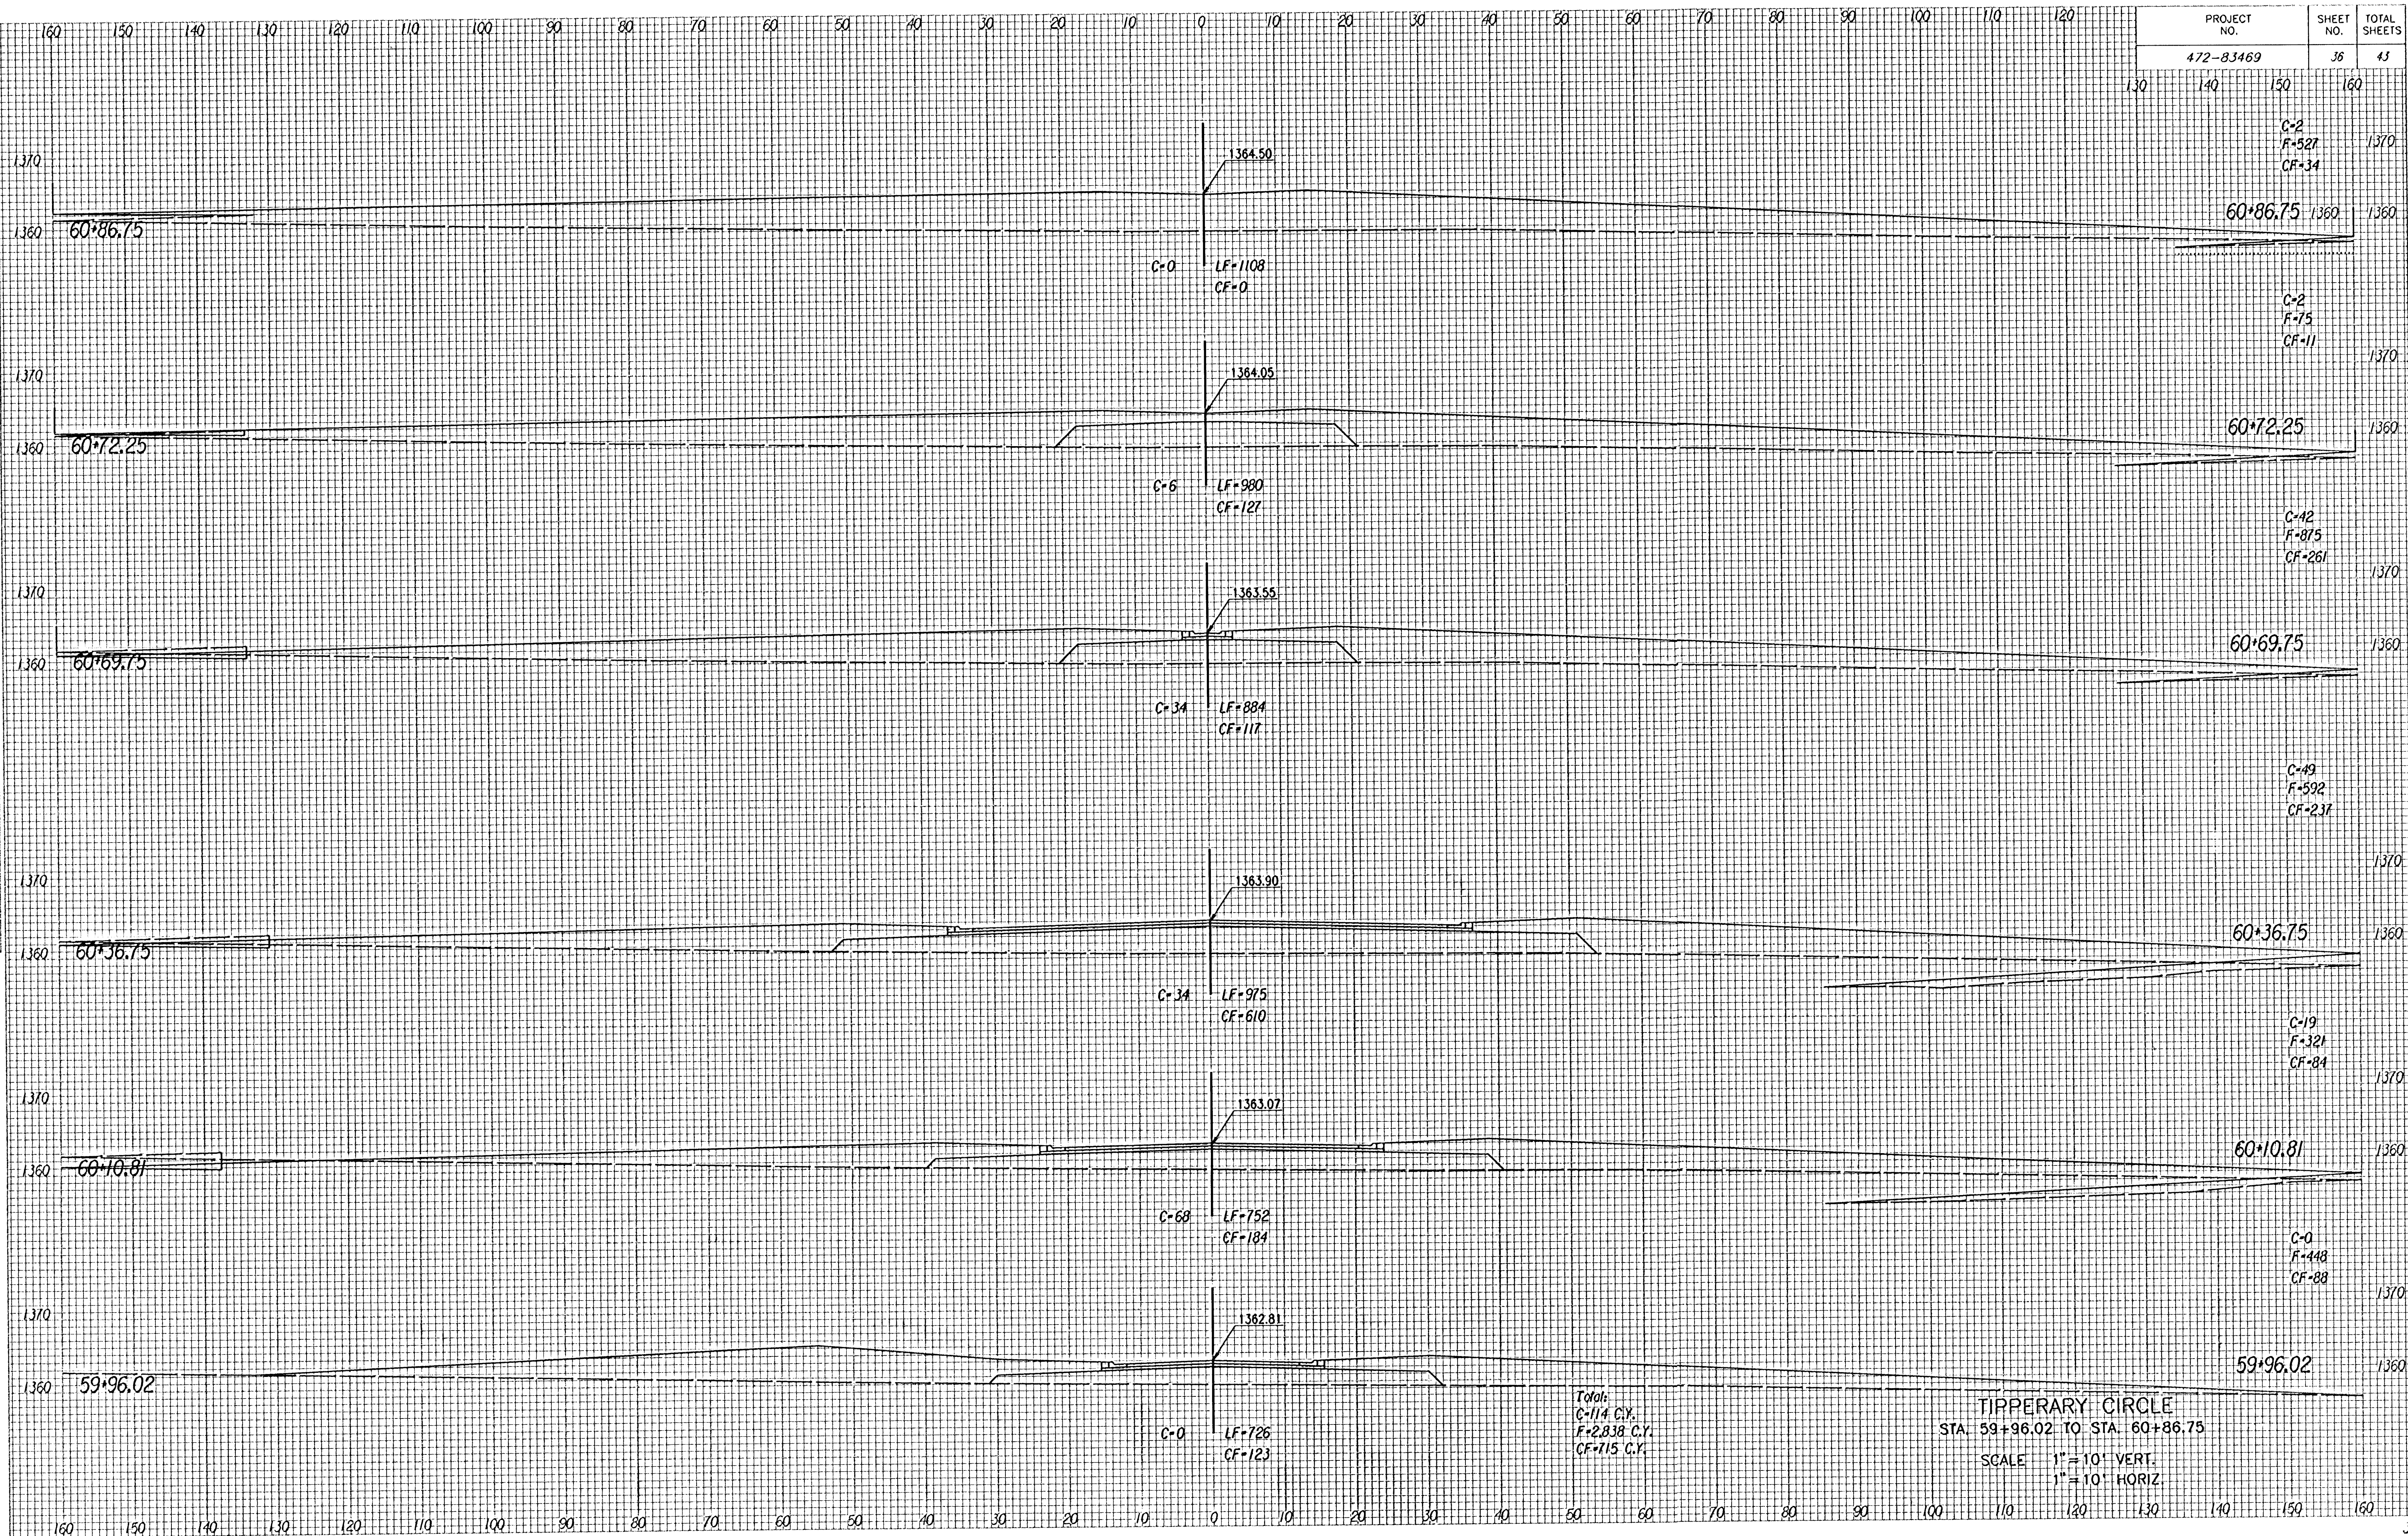

Total:
C=114 C.Y.
F=2838 C.Y.
CF=115 C.Y.

TIPPERARY CIRCLE
STA. 59+96.02 TO STA. 60+86.75
SCALE 1"=10' VERT.
1"=10' HORIZ.