


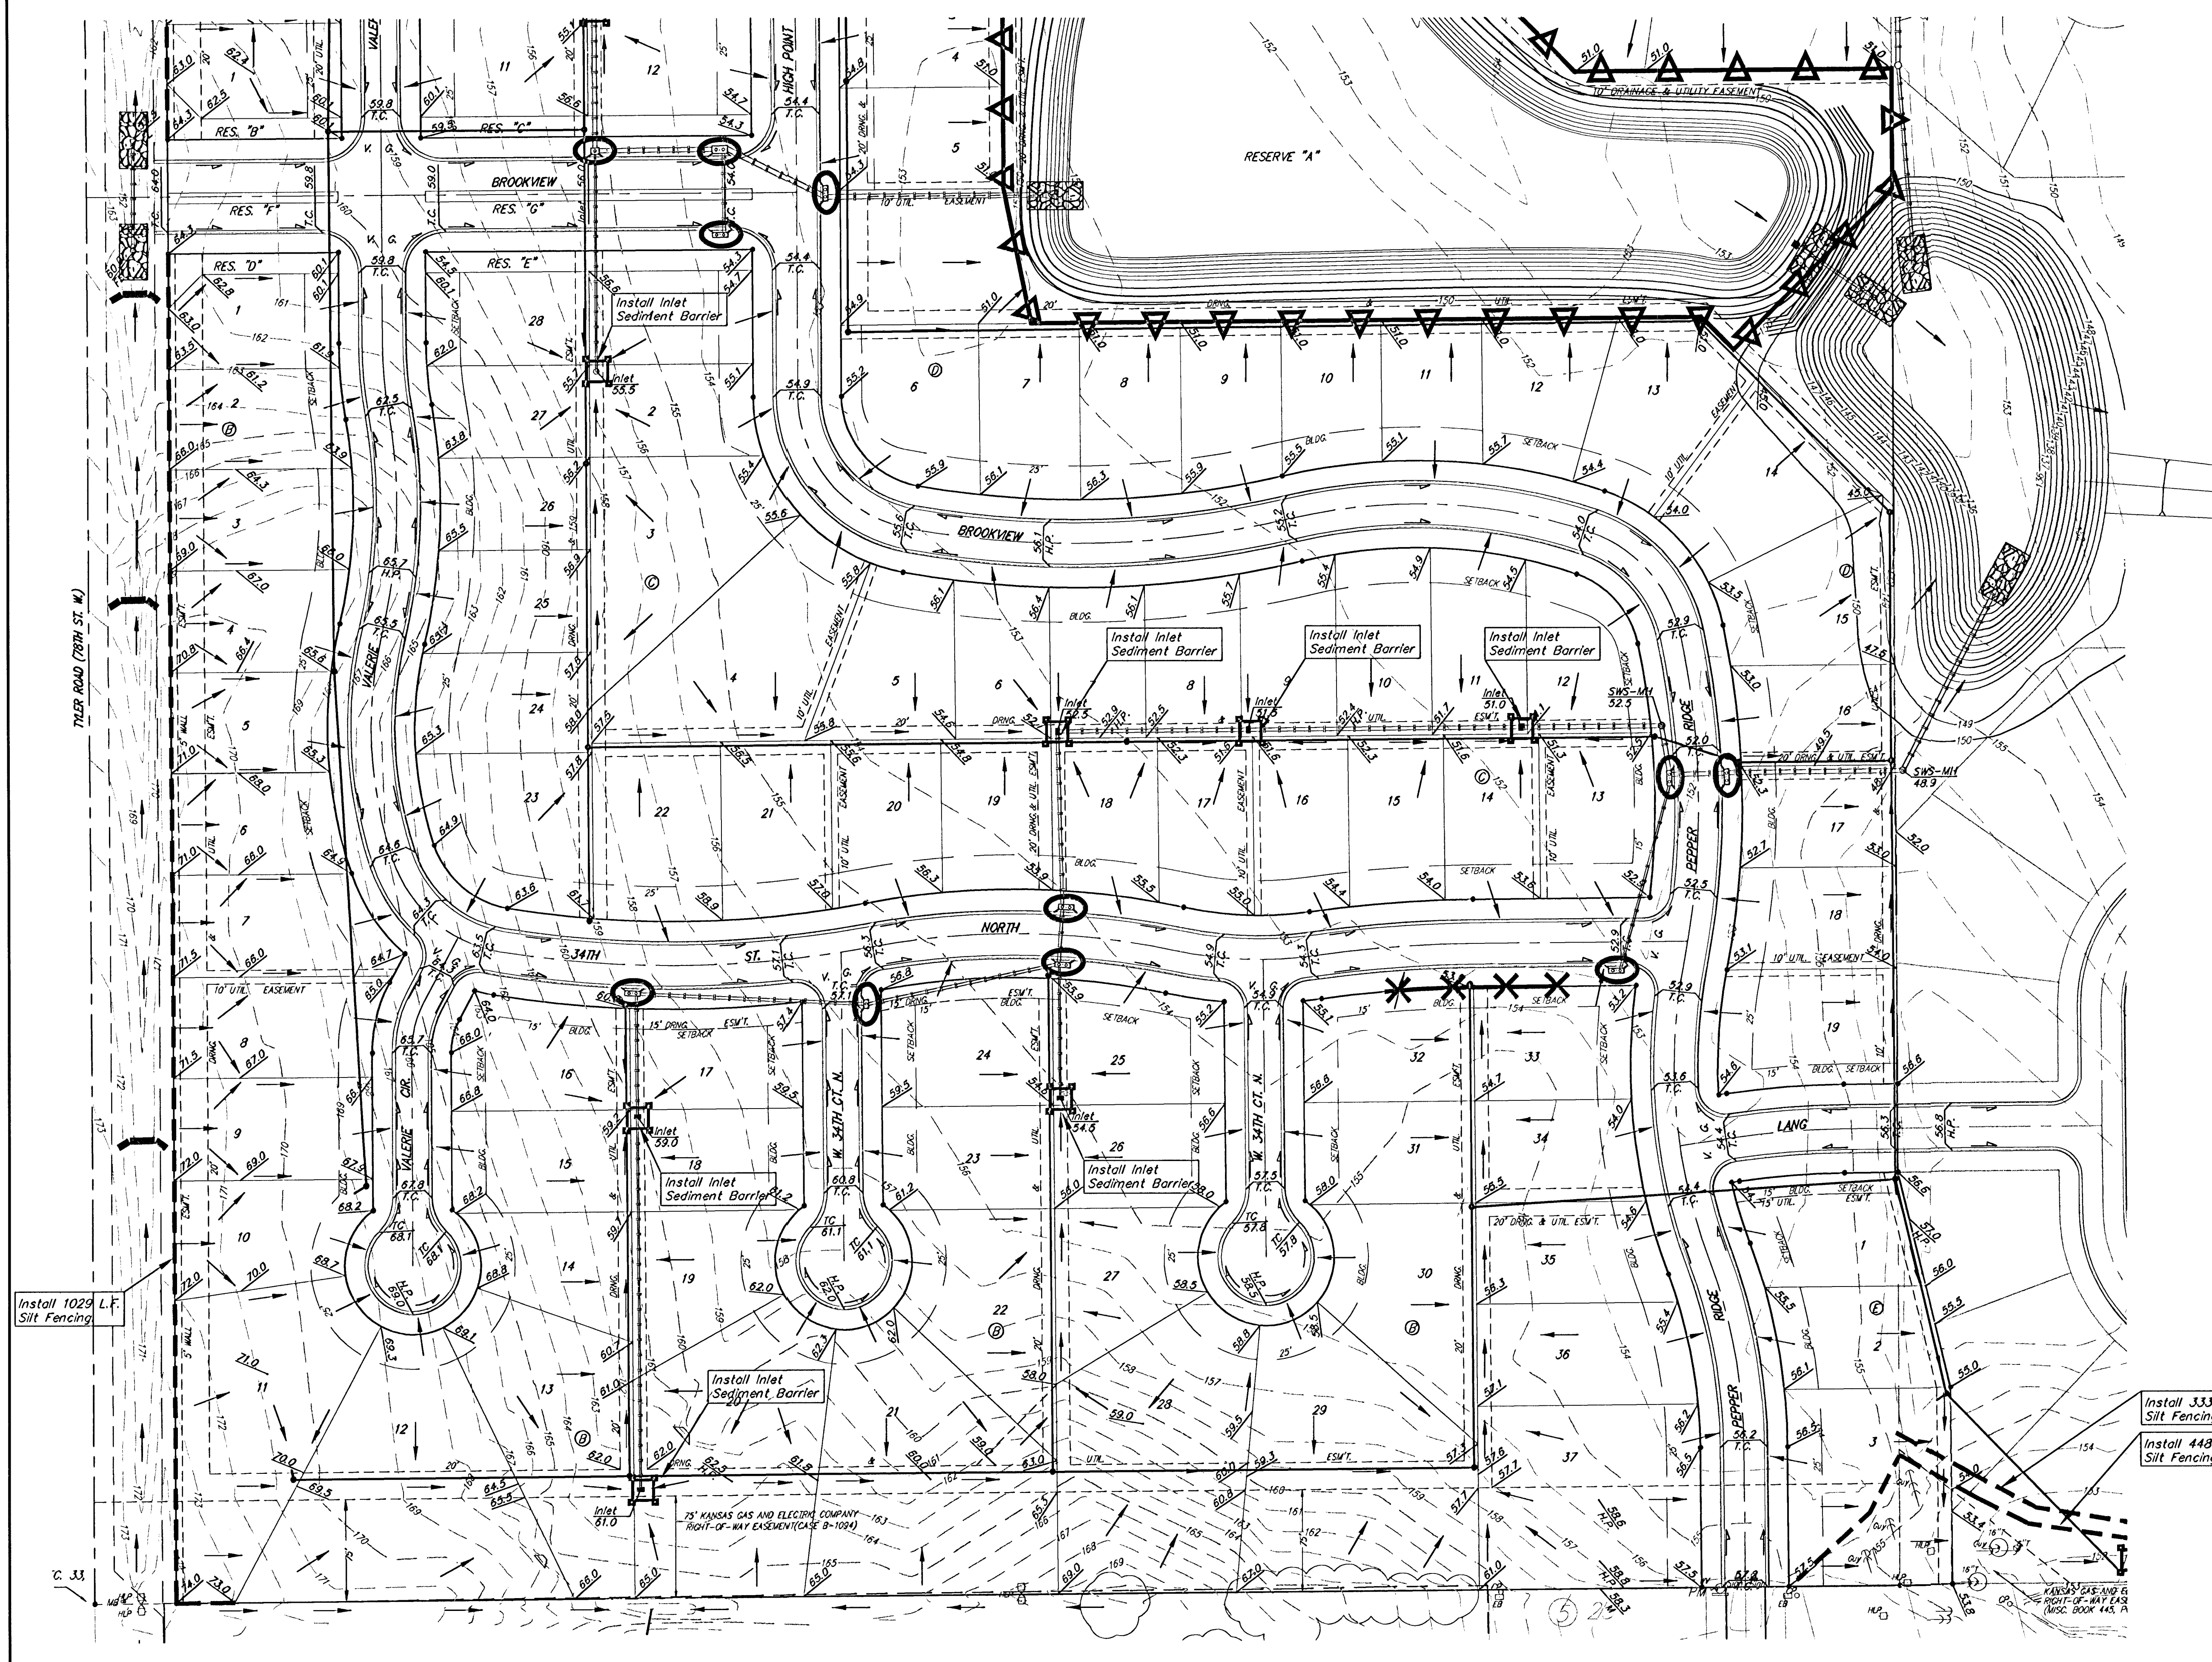

SCALE: 1" = 60'
• = Iron

Contractor to
Install 4 Straw
Bale Ditch
Checks in Ditch

Contractor to
Install 2-100
L.F. Silt Fence
Ditch Checks at
end of Ditch

EROSION CONTROL PLAN
LEGEND
(Installation Details Found in the SMP2 Plan)

- LIGHT STONE RIP-RAP
See Plan Sheets
- DROP INLET PROTECTION
10 Ea.
- CURB INLET PROTECTION
- STRAW BALE BARRIERS
4 Ea.
- SILT FENCING
3019 L.F.
- EARTH DIKES
2472 L.F.

NO SCALE

Install 333 L.F.
Silt Fencing.

Install 448 L.F.
Silt Fencing.

TYLER'S LANDING ADDITION
EROSION CONTROL PLAN
CITY OF WICHITA, KANSAS

BAUGHMAN COMPANY P.A.
ENGINEERING, SURVEYING, & PLANNING
318-282-7271 • 318 ELLIS • WICHITA, KANSAS 67211

PROJECT NUMBER

DESIGN SCL	DRAWN SCL	APPROVED NBW	DATE 03/13/03	SCALE 1"=60'
---------------	--------------	-----------------	------------------	-----------------

SHEET
24
OF
32

GRADE.DWG