| FHWA REG NO. | STATE | PROJECT NO. | YEAR | SHEET NO. | TOTAL SHEETS |
|---|---|---|---|---|---|
| 7 | KANSAS | STP-N012(901) | 1999 | 40 | 131 |

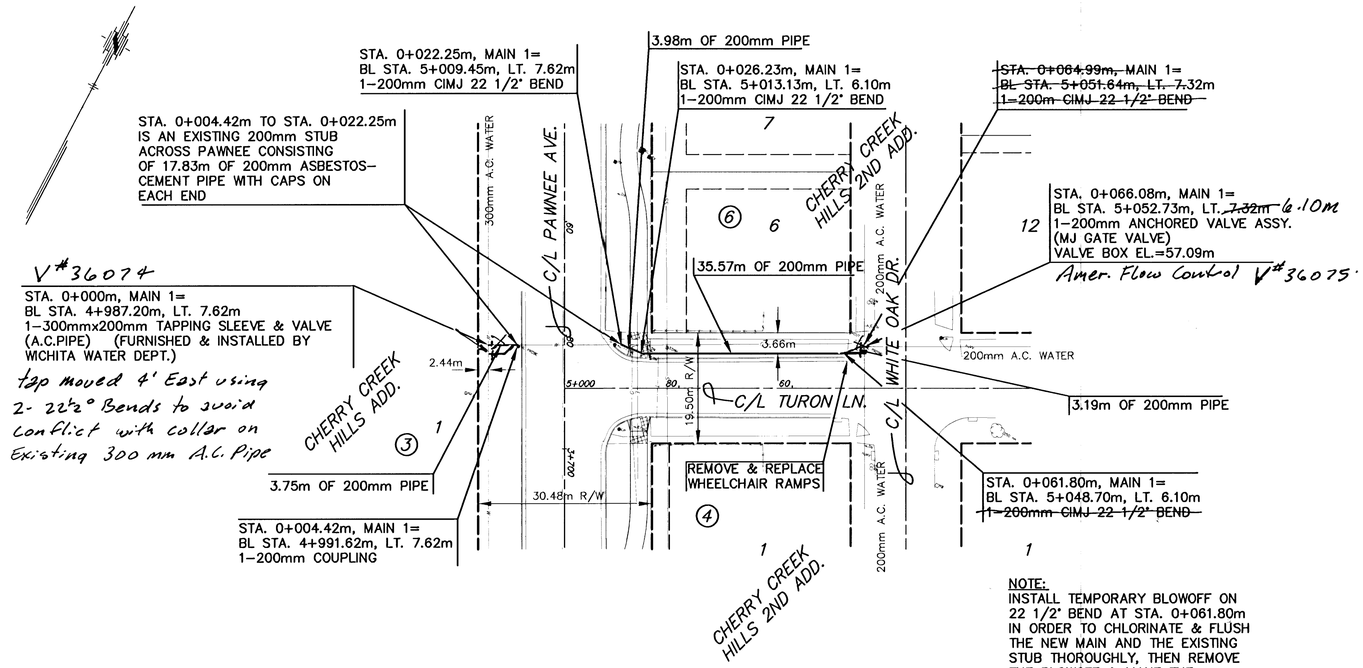


NOTE:
INSTALL TEMPORARY BLOWOFF ON 22 1/2° BEND AT STA. 0+061.80m IN ORDER TO CHLORINATE & FLUSH THE NEW MAIN AND THE EXISTING STUB THOROUGHLY, THEN REMOVE THE BLOWOFF & MAKE THE CONNECTION TO THE EXISTING 200mm MAIN IN WHITE OAK.

PLAN – MAIN 1
SCALE: 1 : 500

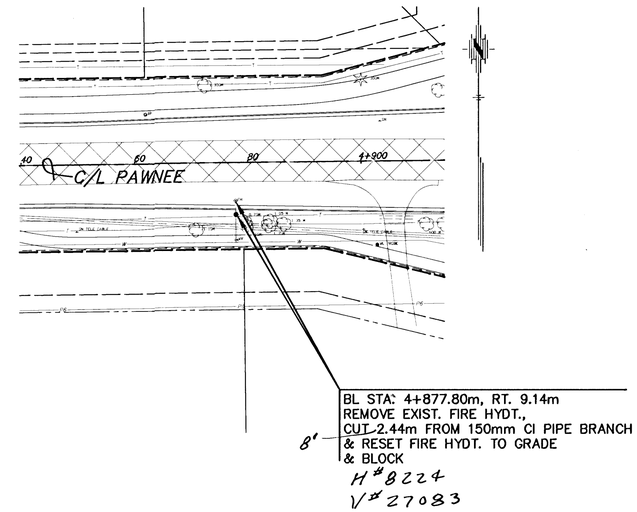


FIRE HYDRANT RELOCATION
SCALE: 1 : 500

PROFILE – MAIN 1
HORIZONTAL SCALE: 1 : 500
VERTICAL SCALE: 1 : 50

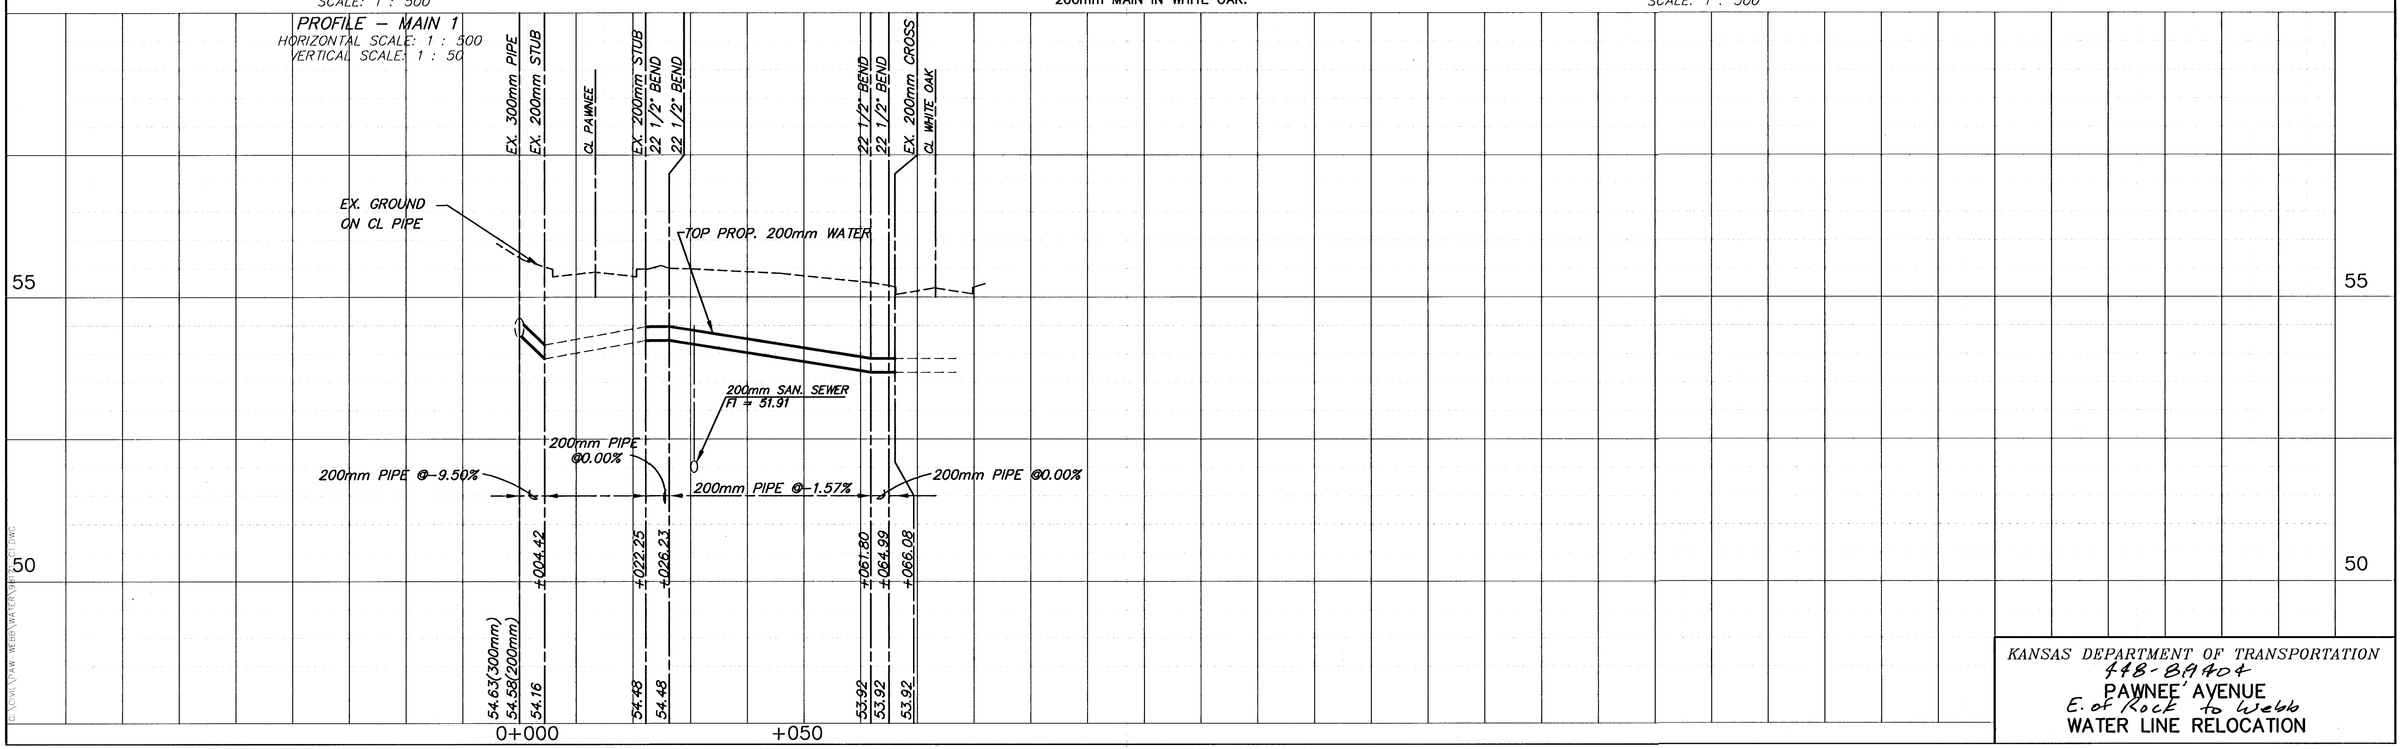


KANSAS DEPARTMENT OF TRANSPORTATION
448-89404
PAWNEE AVENUE
E. of Rock to Webb
WATER LINE RELOCATION

G:\CIVIL\PAW-WEBB\WATER\98171-C1.DWG Thu Sep 14 09:47:36 2000