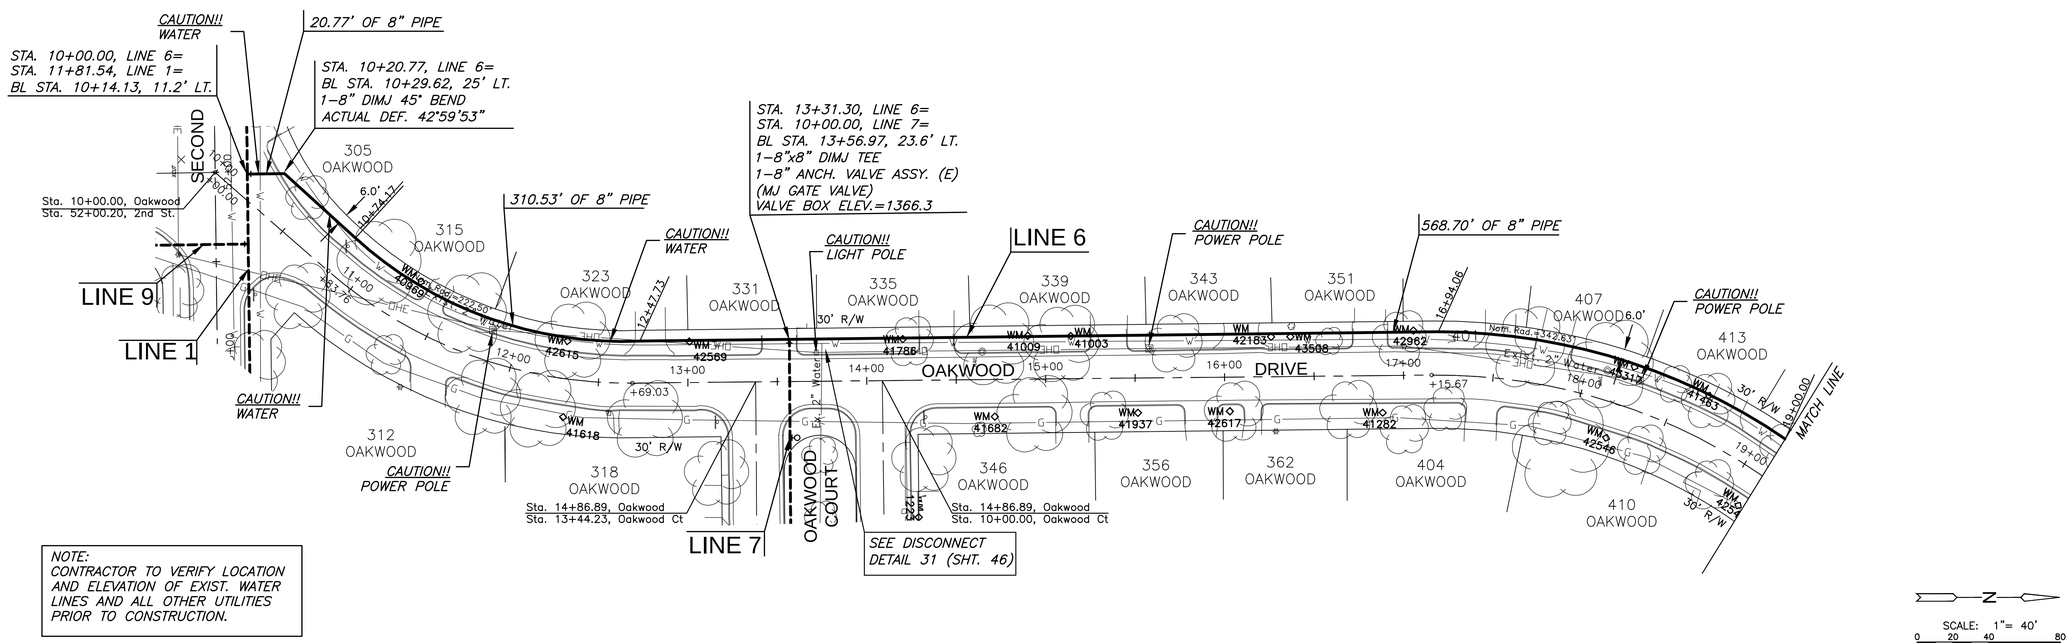

NOTE:
CONTRACTOR TO VERIFY LOCATION AND ELEVATION OF EXIST. WATER LINES AND ALL OTHER UTILITIES PRIOR TO CONSTRUCTION.

PLAN LINE 6

PROFILE LINE 6

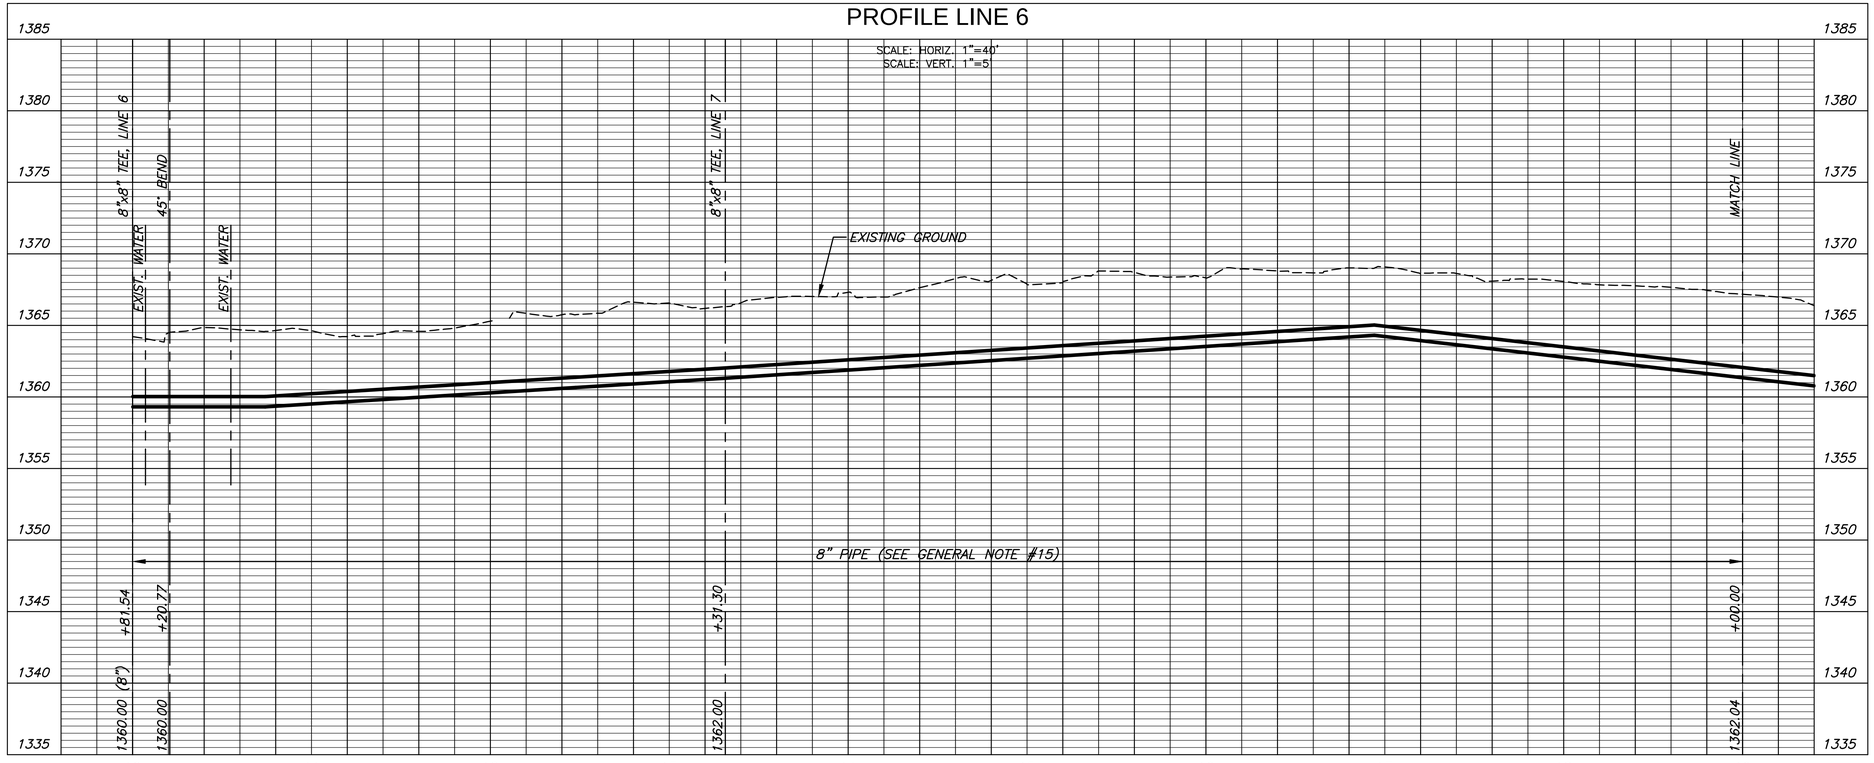

MKEC
Wichita, KS • 316-684-9600

WATER LINE REPLACEMENT PLANS

EASTBOROUGH NORTH

DESIGN

©2013
MKEC Engineering
All Rights Reserved
www.mkec.com
These drawings and their contents, including, but not limited to, all concepts, designs, & ideas are the exclusive property of MKEC Engineering (MKEC), and may not be used or reproduced in any way without the express consent of MKEC.

LINE 6

PROJECT NO.	448-90610
DATE	SEPT. 2017
SCALE	AS SHOWN

DESIGNED	DRAWN	CHECKED
JTC	DM	JRA

NO.	REVISION	DATE

SHEET NO.

31 OF 77

J:\PROJECTS\2013\130\10713_COW EASTBOROUGH NORTH WATER REPLACES-CIV\LCAD\WTR\13713_C14.DWG

PLOTTED: Friday, September 29, 2017 @ 11:39AM