
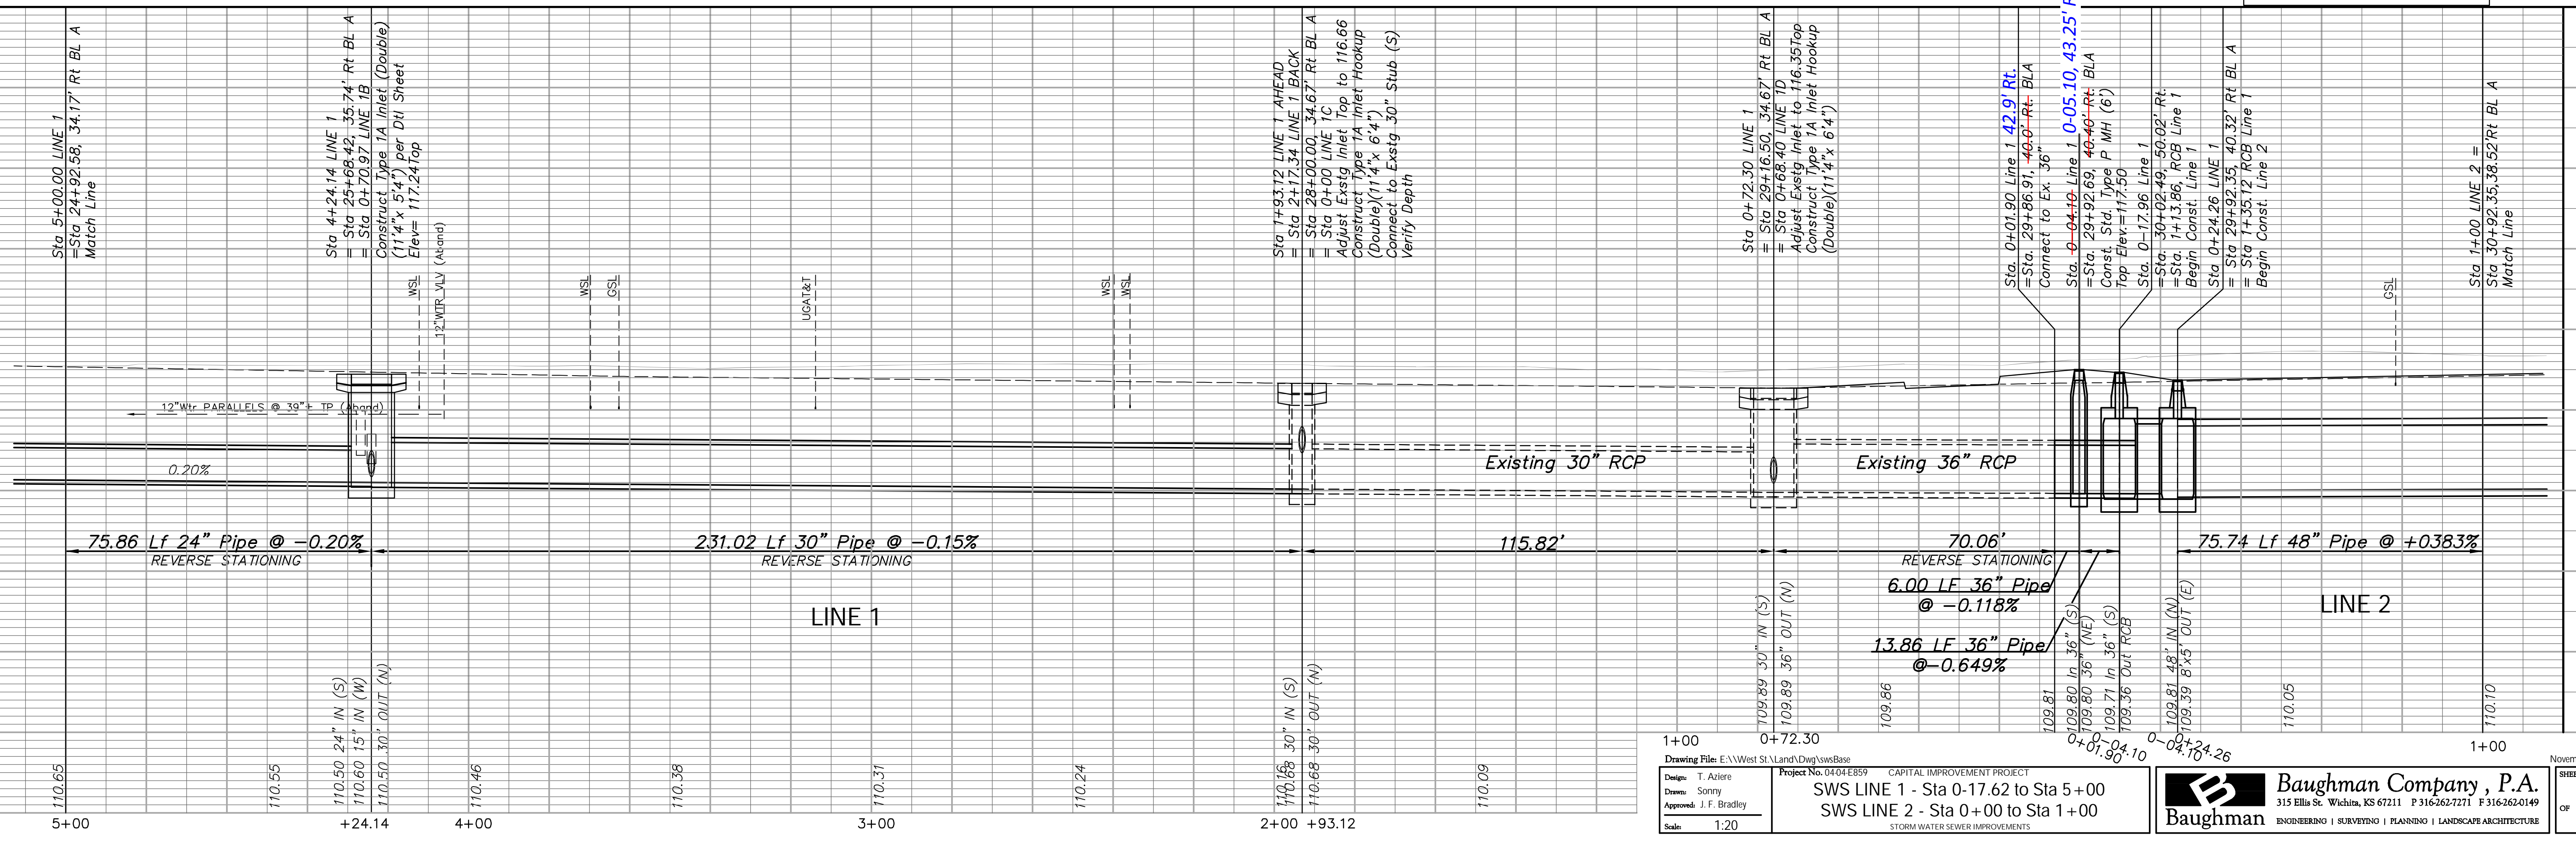


SCALE:
1" = 20' HORIZONTAL
1" = 5' VERTICAL

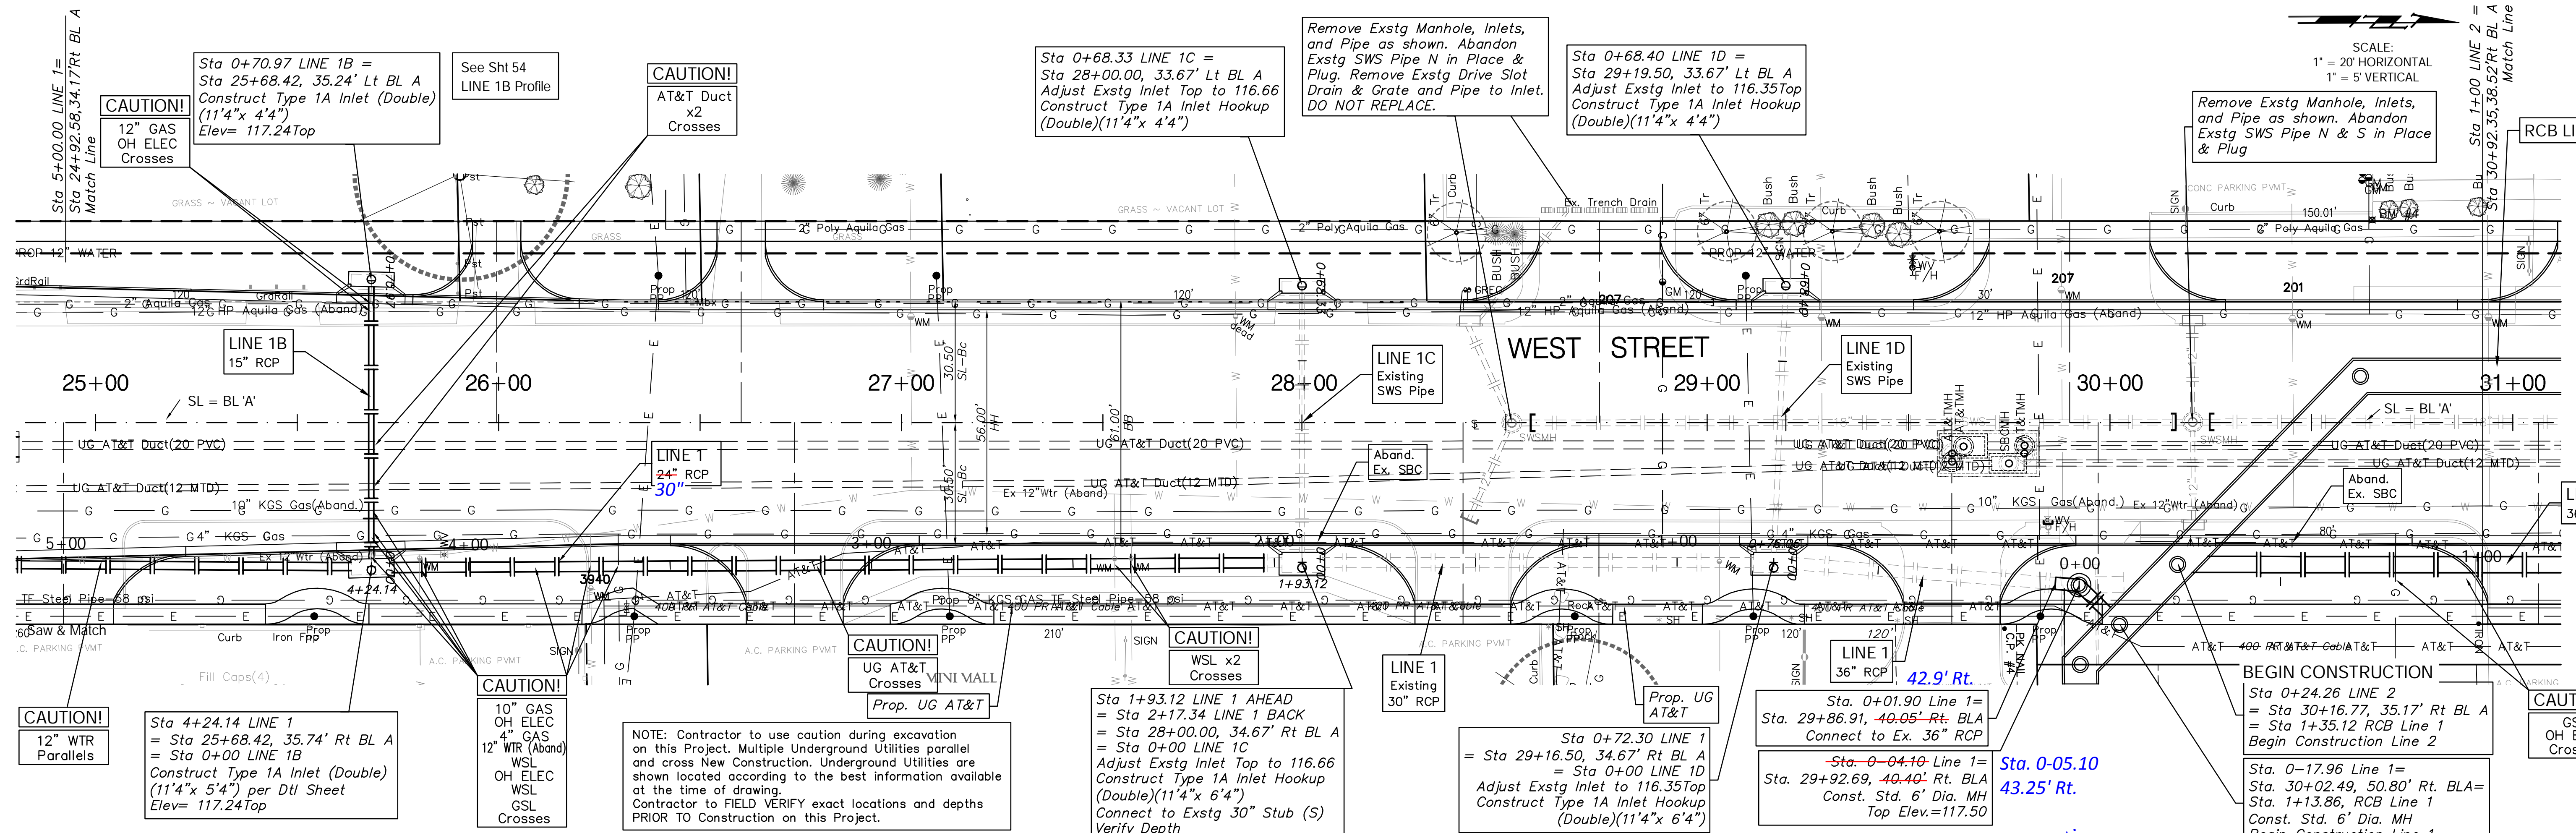

Drawing File: E:\West St Land\Drawings\Bases
 Design: T. Azire
 Drawn: Sonny
 Approved: J. F. Bradley
 Scale: 1:20

Project No. 0404E859
 CAPITAL IMPROVEMENT PROJECT
 SWS LINE 1 - Sta 0-17.62 to Sta 5+00
 SWS LINE 2 - Sta 0+00 to Sta 1+00
 STORM WATER SEWER IMPROVEMENTS

November 2008
 SHEET
38
 OF
131

Baughman Company, P.A.
 315 Ellis St. Wichita, KS 67211 P 316-262-7271 F 316-262-0149
 ENGINEERING | SURVEYING | PLANNING | LANDSCAPE ARCHITECTURE