Danco Enterprises - Contractor
J. Wagner - City of Wichita, Field Project Engineer
D. Hicks - City of Wichita, Inspector
As-built
Completion Date: 2/5/2018

SWS #711 - WEST BRANCH DRY CREEK OF GYPSUM CREEK SWS IMPROVEMENTS
5119 E KELLOGG DR., DOPPS CHIROPRACTIC PARKING LOT

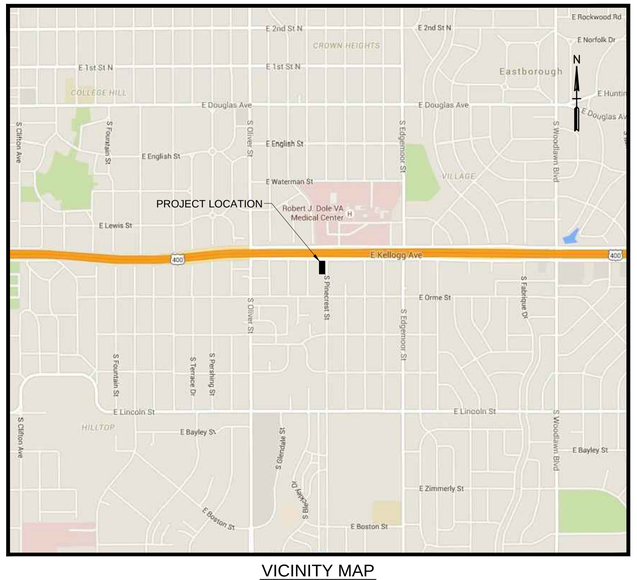

VICINITY MAP
NOT TO SCALE

OCTOBER 31, 2016

amec foster wheeler

Amec Foster Wheeler
Environment and Infrastructure, Inc.
245 North Waco Avenue, Suite 110
Wichita, Kansas 67202
Phone: 316-337-5550

DRAWING INDEX

NO.	TITLE
1	COVER SHEET
2	NOTES
3	PLAN - EXISTING CONDITIONS
4	PLAN - DEMOLITION
5	PLAN - PROPOSED
6	TYPICAL SECTIONS
7	TYPICAL SECTION AT BUILDING
8	DETAILS
9	DETAILS
10	DETAILS
11	DETAILS

NATHAN LONG LICENSED 20846 KANSAS PROFESSIONAL ENGINEER 4/5/17

MARK	DESCRIPTION	DATE	APPR.
1	ADDENDUM 1	04/05/2017	NL

DESIGNED BY: MAG
DWN BY: JAR
CK'D BY: NL
DATE: OCTOBER 31, 2016
PROJECT NO.: 6-2150-00252
SUBMITTED BY: Amec Foster Wheeler Environment & Infrastructure, Inc.
PLOT SCALE: N/A
SIZE: ANSI D
FILE NAME: Dopps Chiropractic Design.dwg

amec foster wheeler
Environment & Infrastructure, Inc.
245 North Waco Avenue, Suite 110
Wichita, Kansas 67202
Phone: 316-337-5550

CITY OF WICHITA

100% DESIGN

SWS #711 - WEST BRANCH DRY CREEK OF GYPSUM CREEK SWS IMPROVEMENTS
5119 E KELLOGG DR., DOPPS CHIROPRACTIC PARKING LOT

COVER SHEET

SHEET IDENTIFICATION
1
SHEET 1 OF 11