
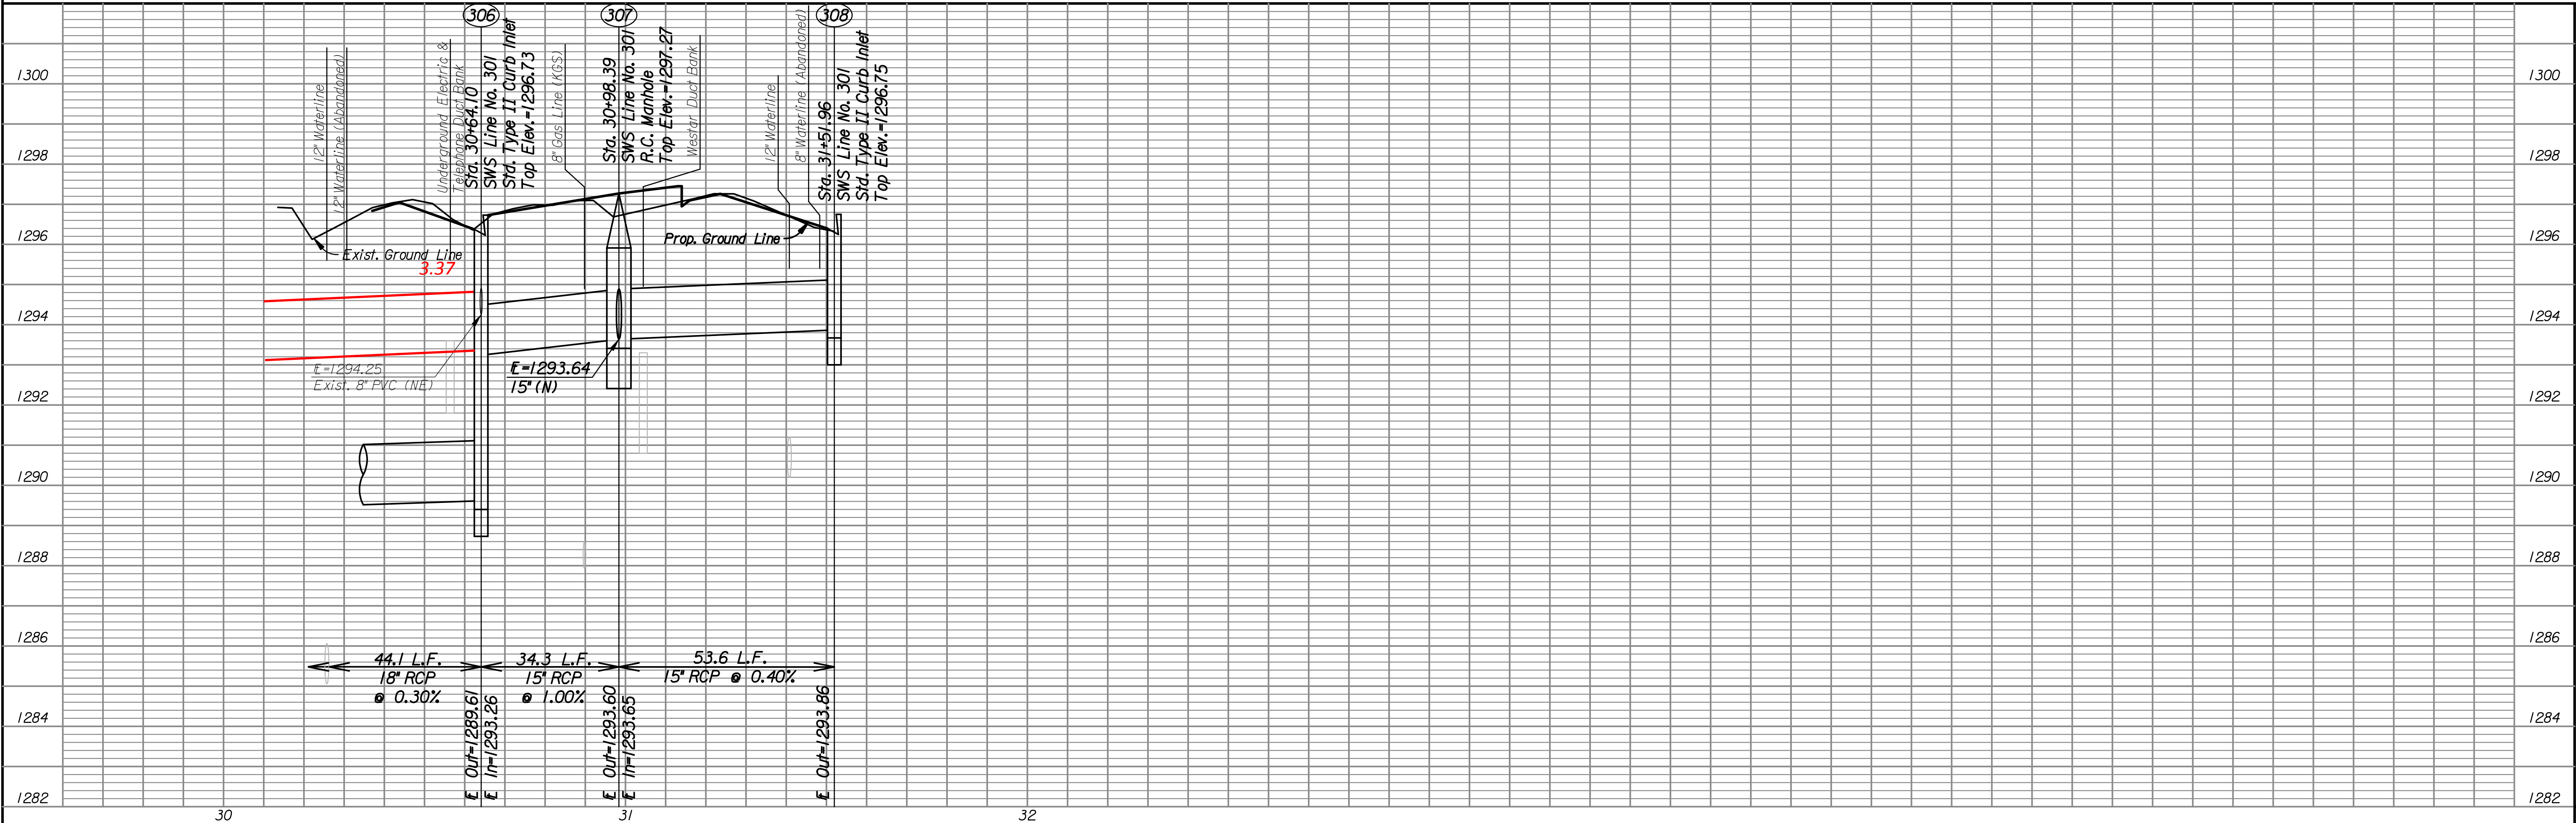


Plotted By: Jps Date: 4/3/2009 3:43:49 PM
 FILE: H:\2008\08456\Profile\08456-swspp301-2nd.dgn

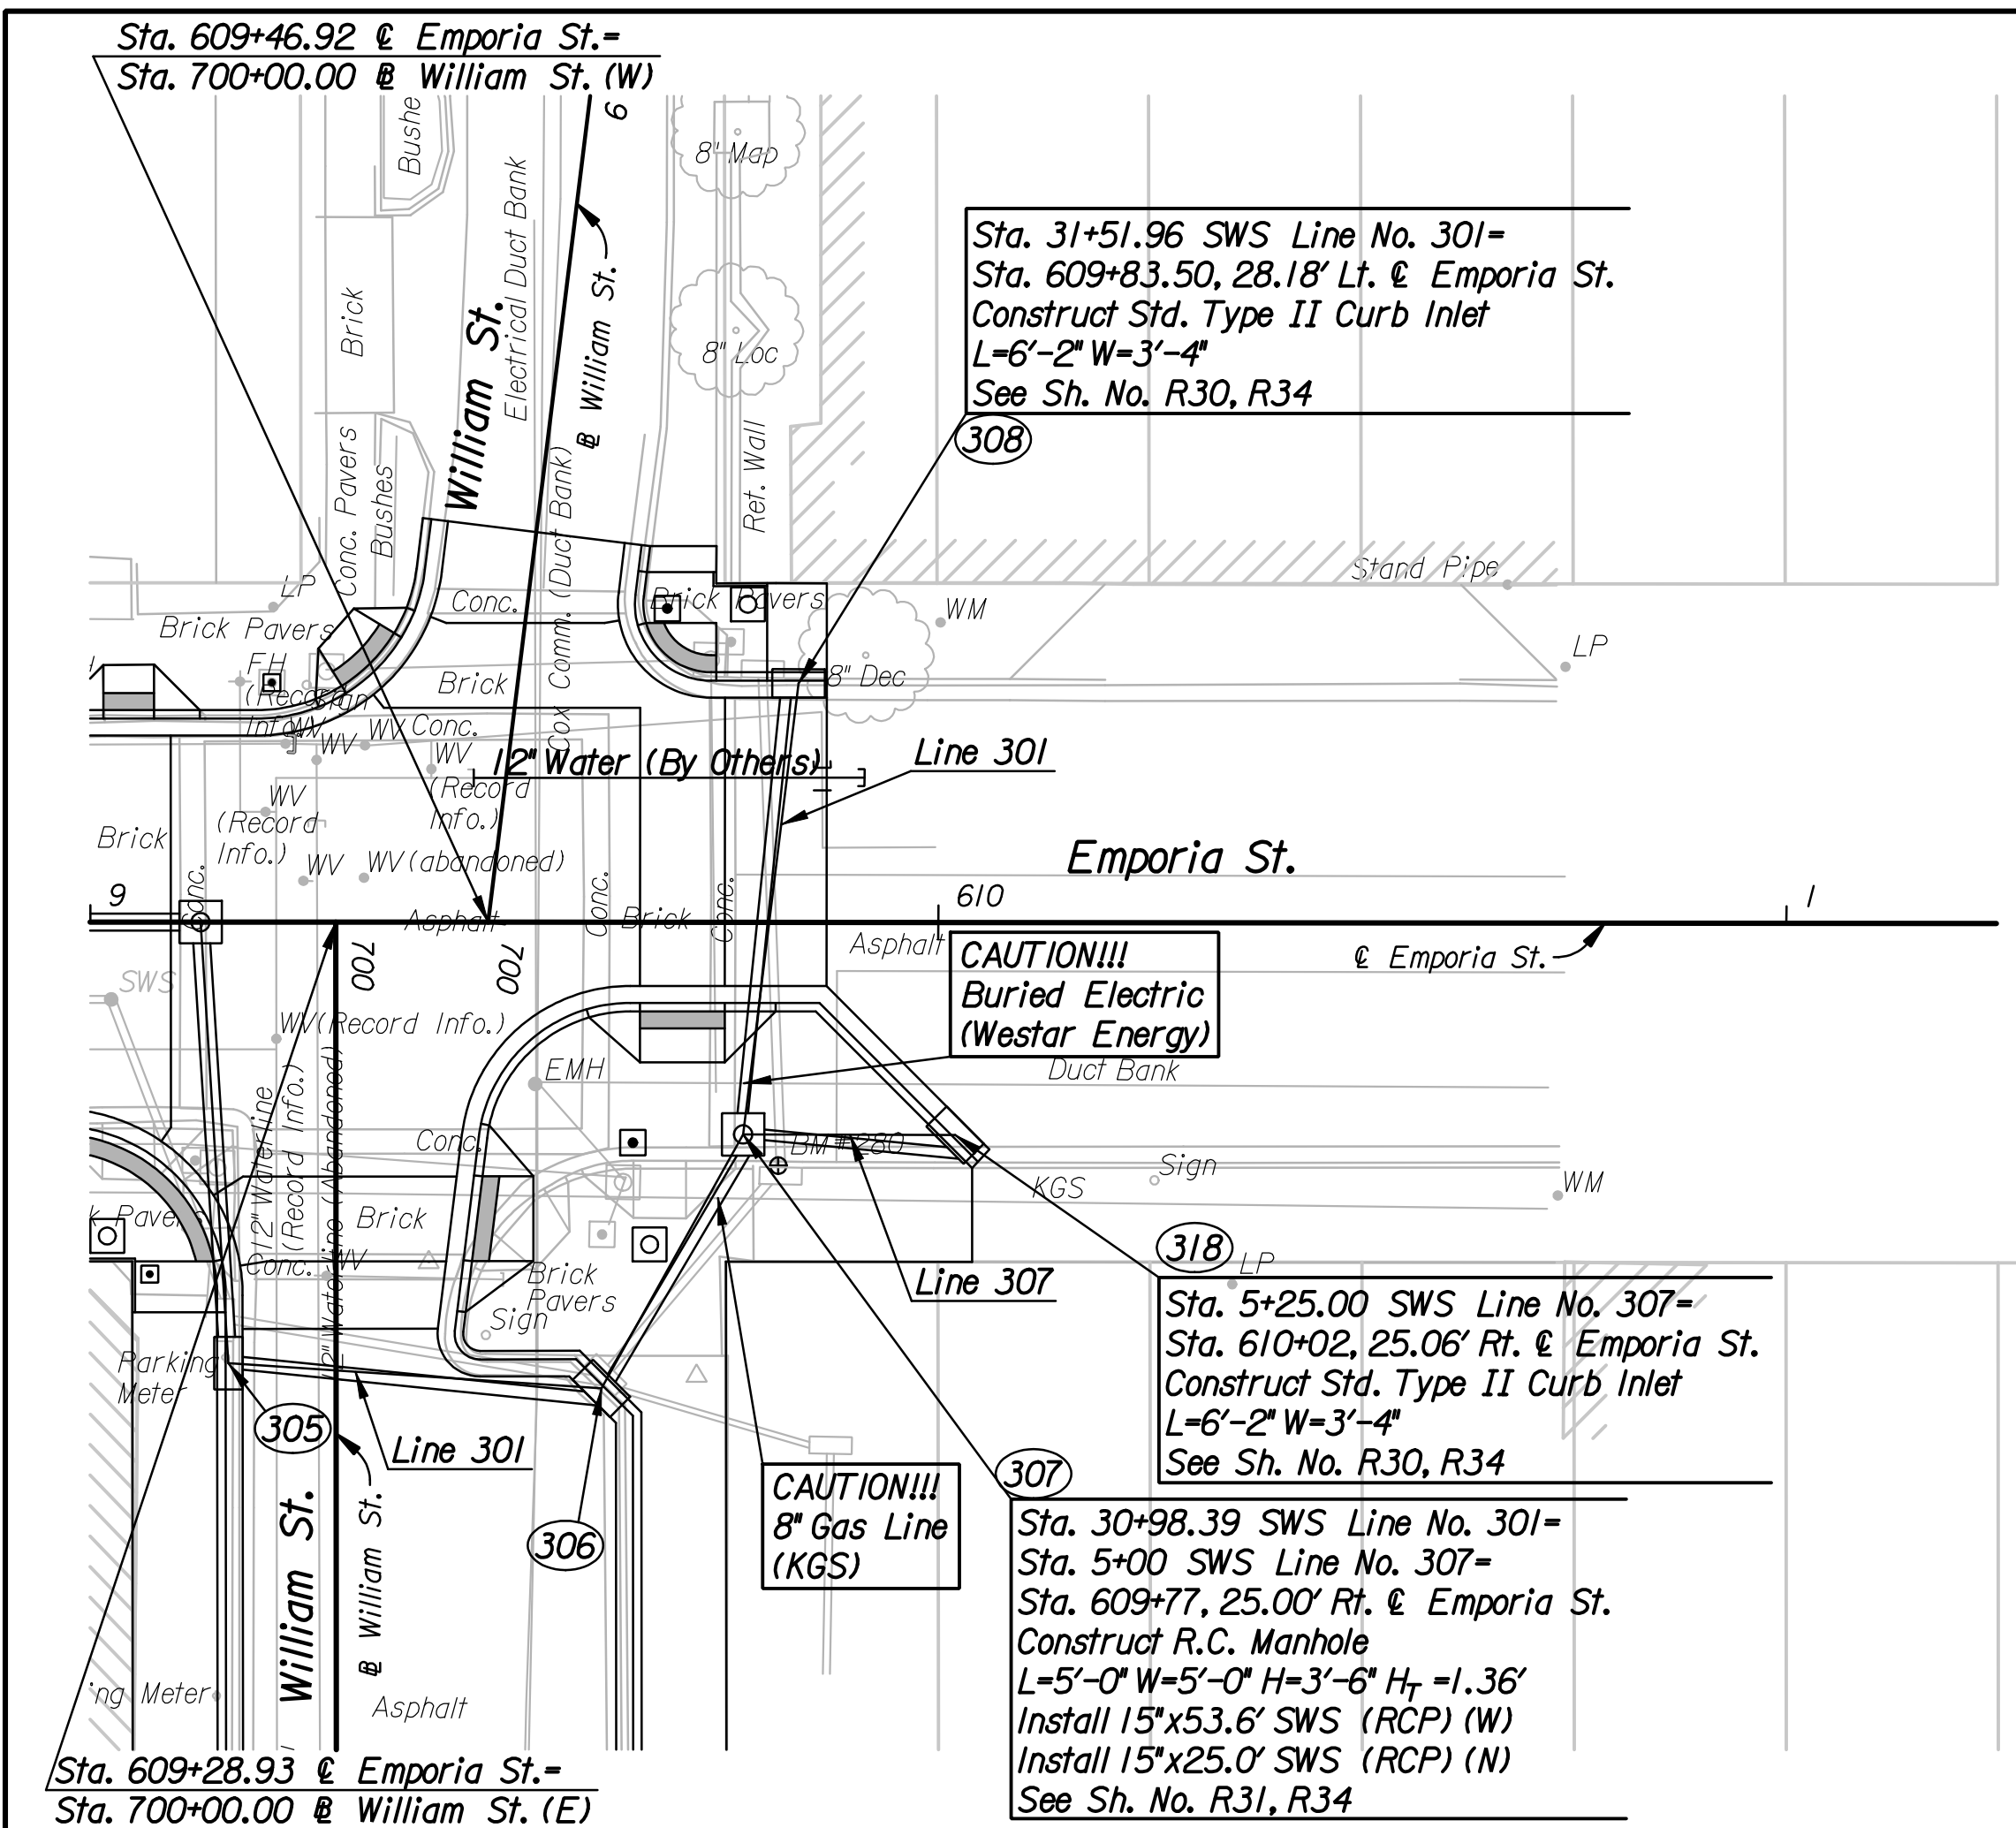

EMPORIA STREET
STORM SEWER PLAN
 LINE NO. 301

Professional Engineering Consultants, P.A.

Job No. 08456 Date Feb., 2009
 Designed by JPS
 Drawn by DRP

C.O.W. PROJ. NO. 472-84744