


PROJECT NO.	STATE	PROJECT NO.	YEAR	SHEET NO.	TOTAL SHEETS
7	KANSAS	87-U-1362-01	1993	120	149

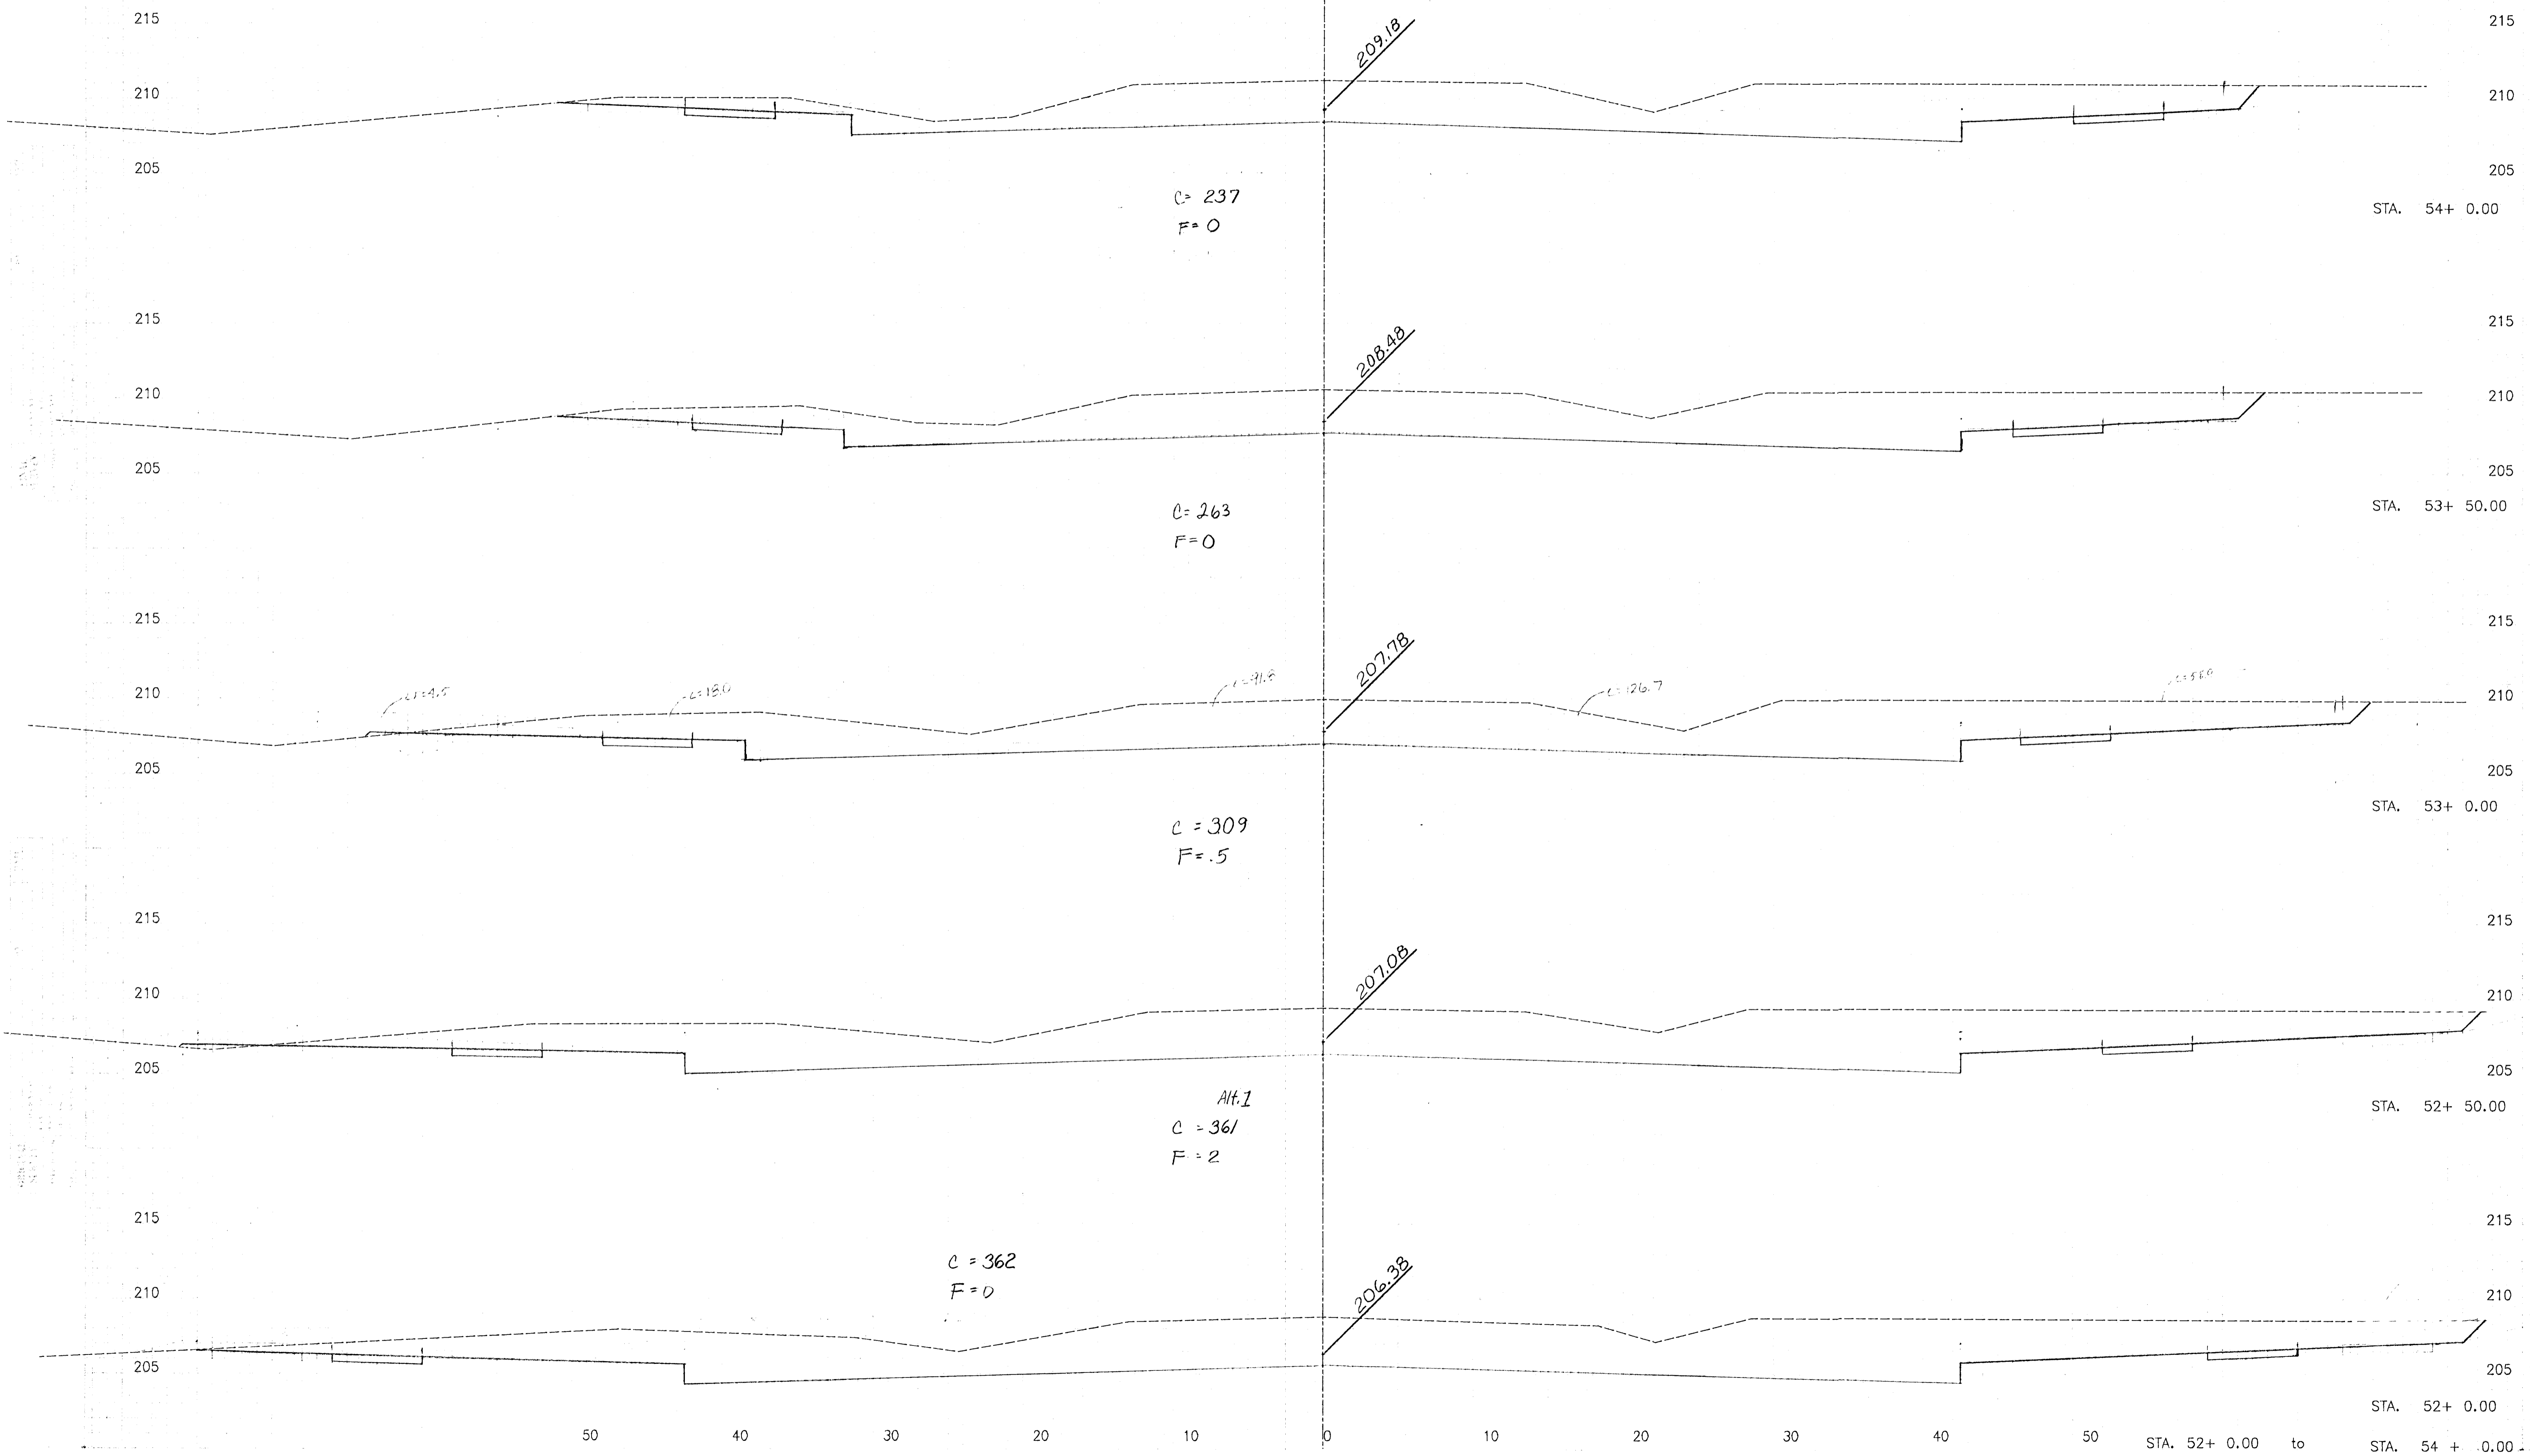

120
149

STA. 52+ 0.00
to
STA. 54+ 0.00
WEBB ROAD