
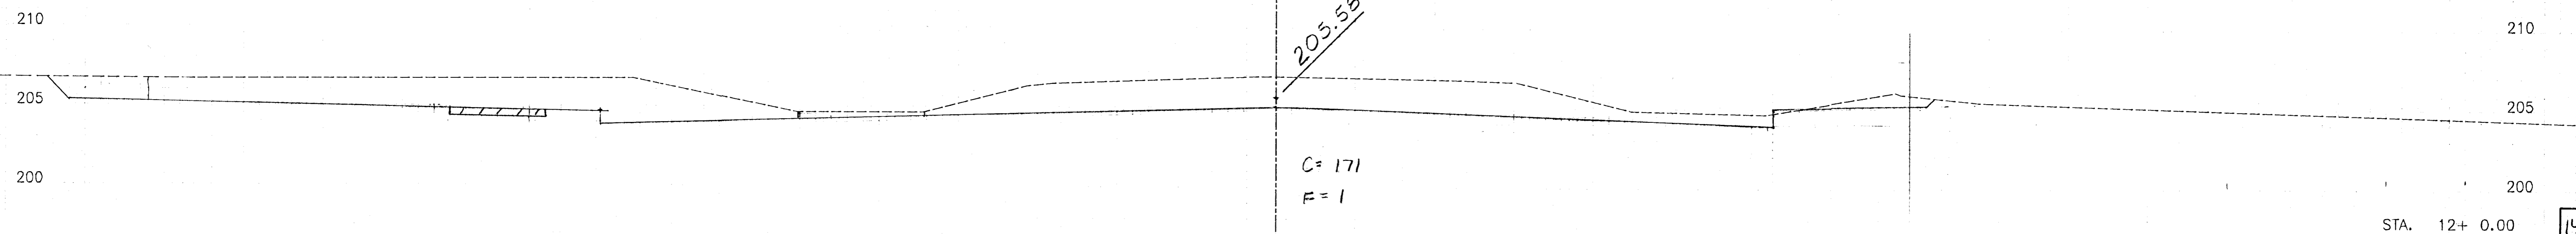
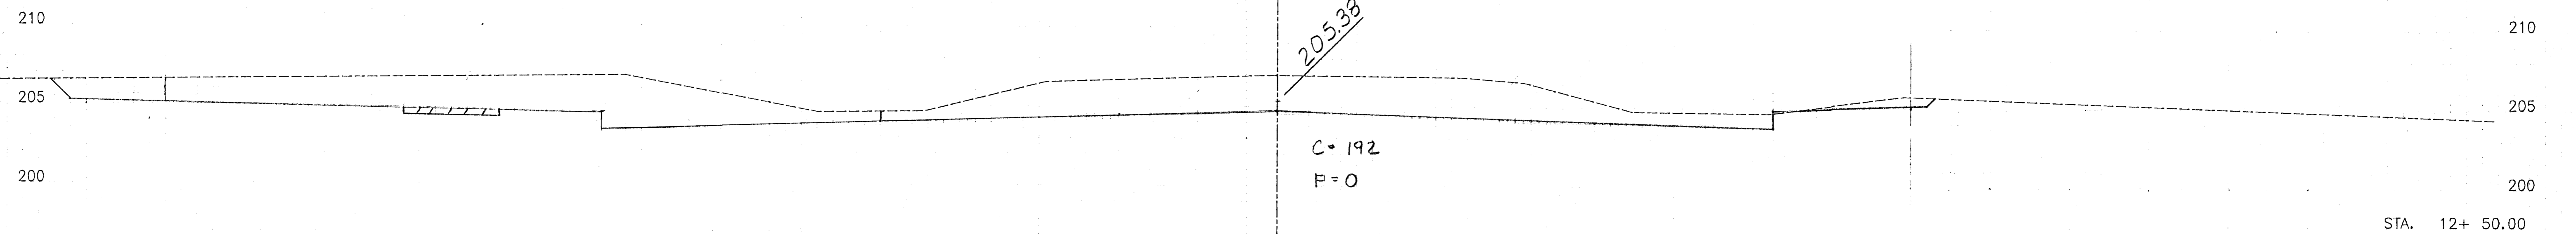
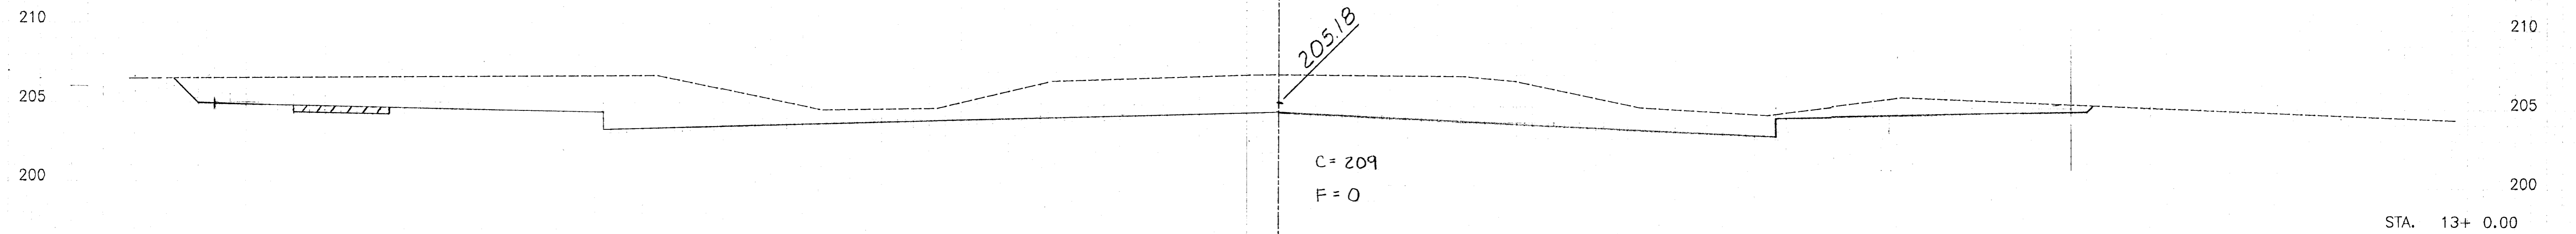
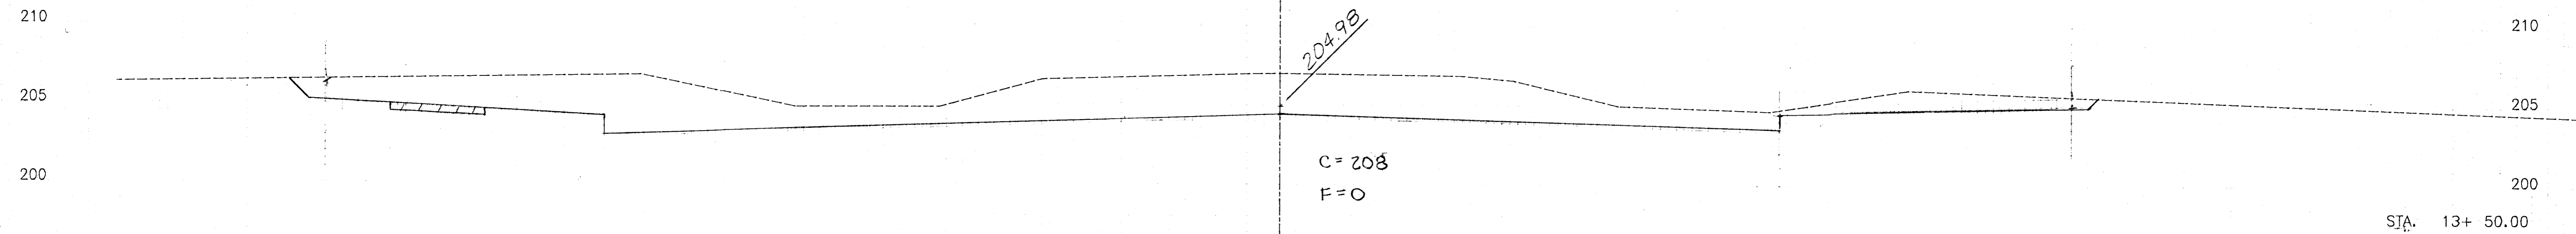


YEAR	STATE	PROJECT NO.	YEAR	SHEET NO.	TOTAL SHEETS
1	KANSAS	87-U-1362-01	1993	141	149

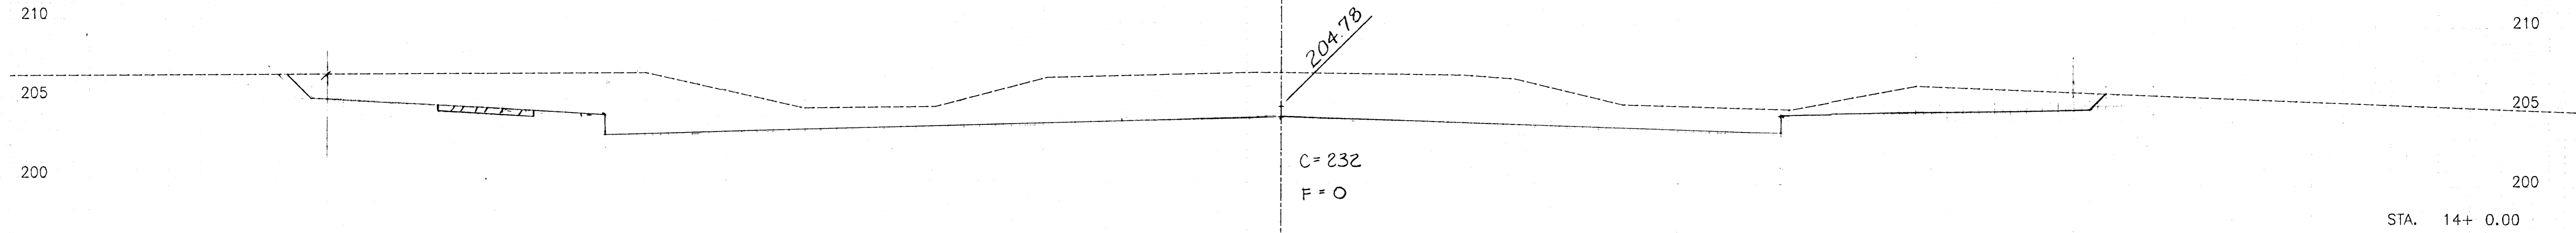

STA. 12+ 0.00 to STA. 14 + 0.00

141/149

21 ST STREET