
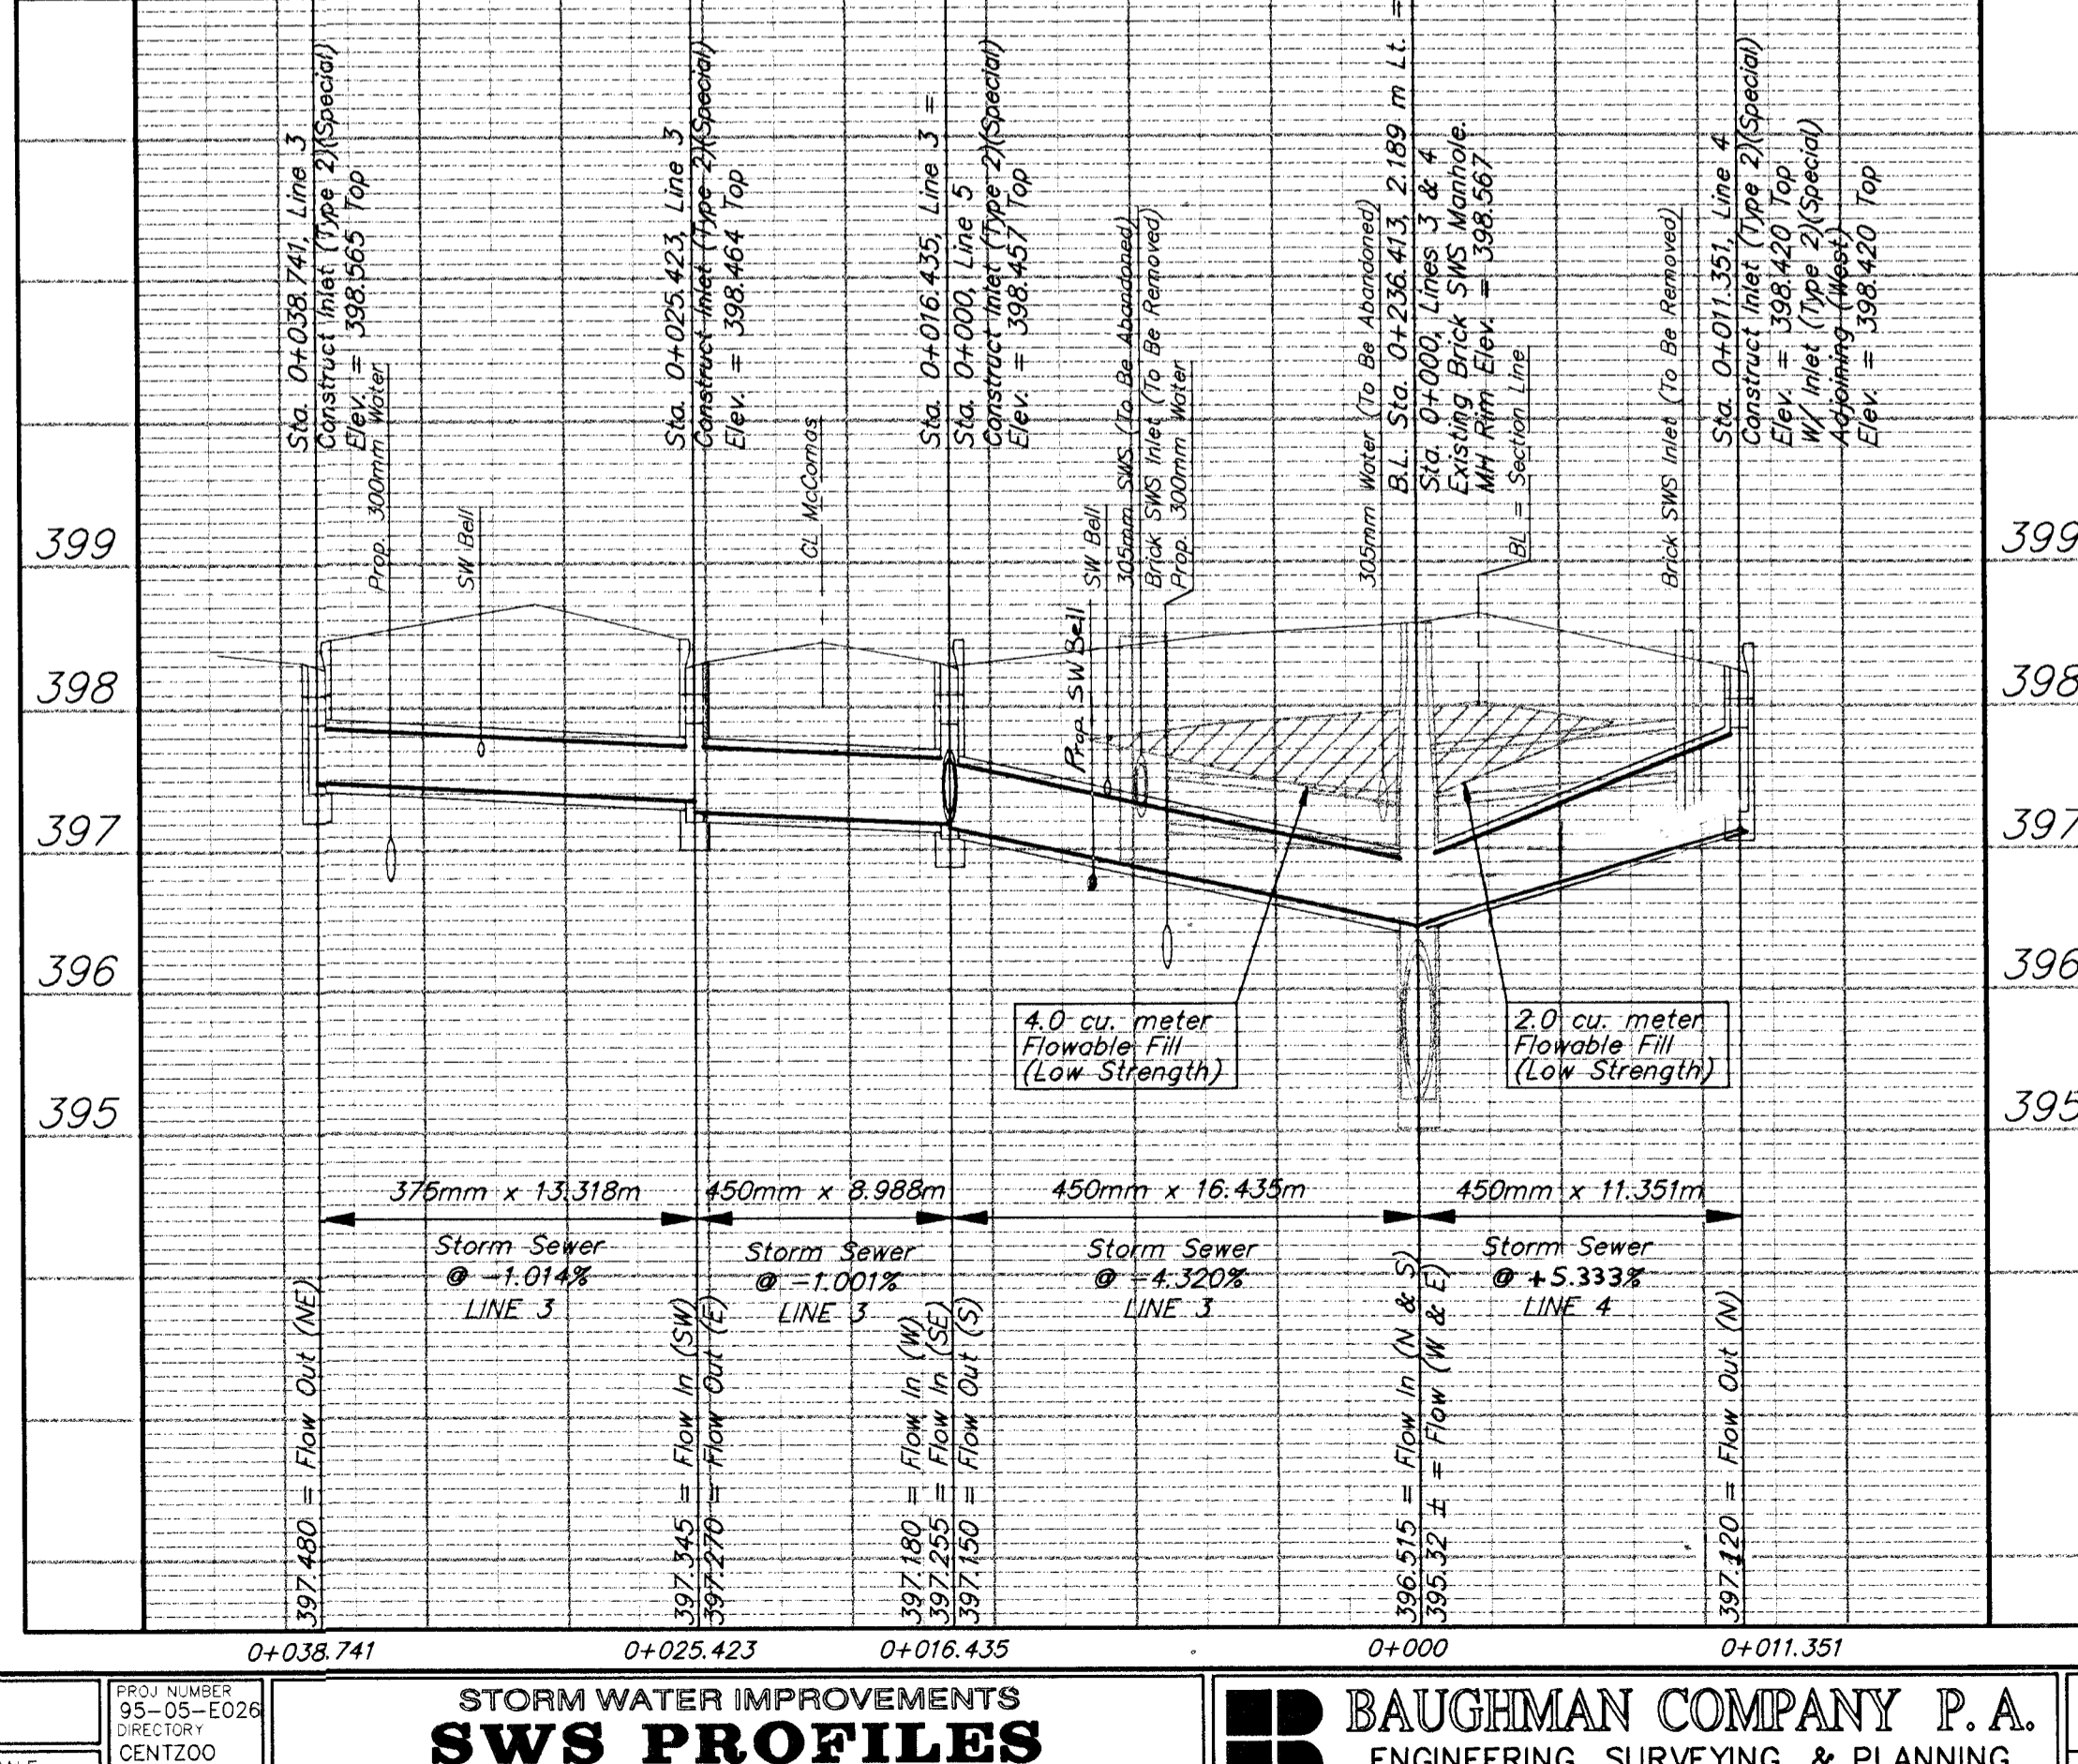
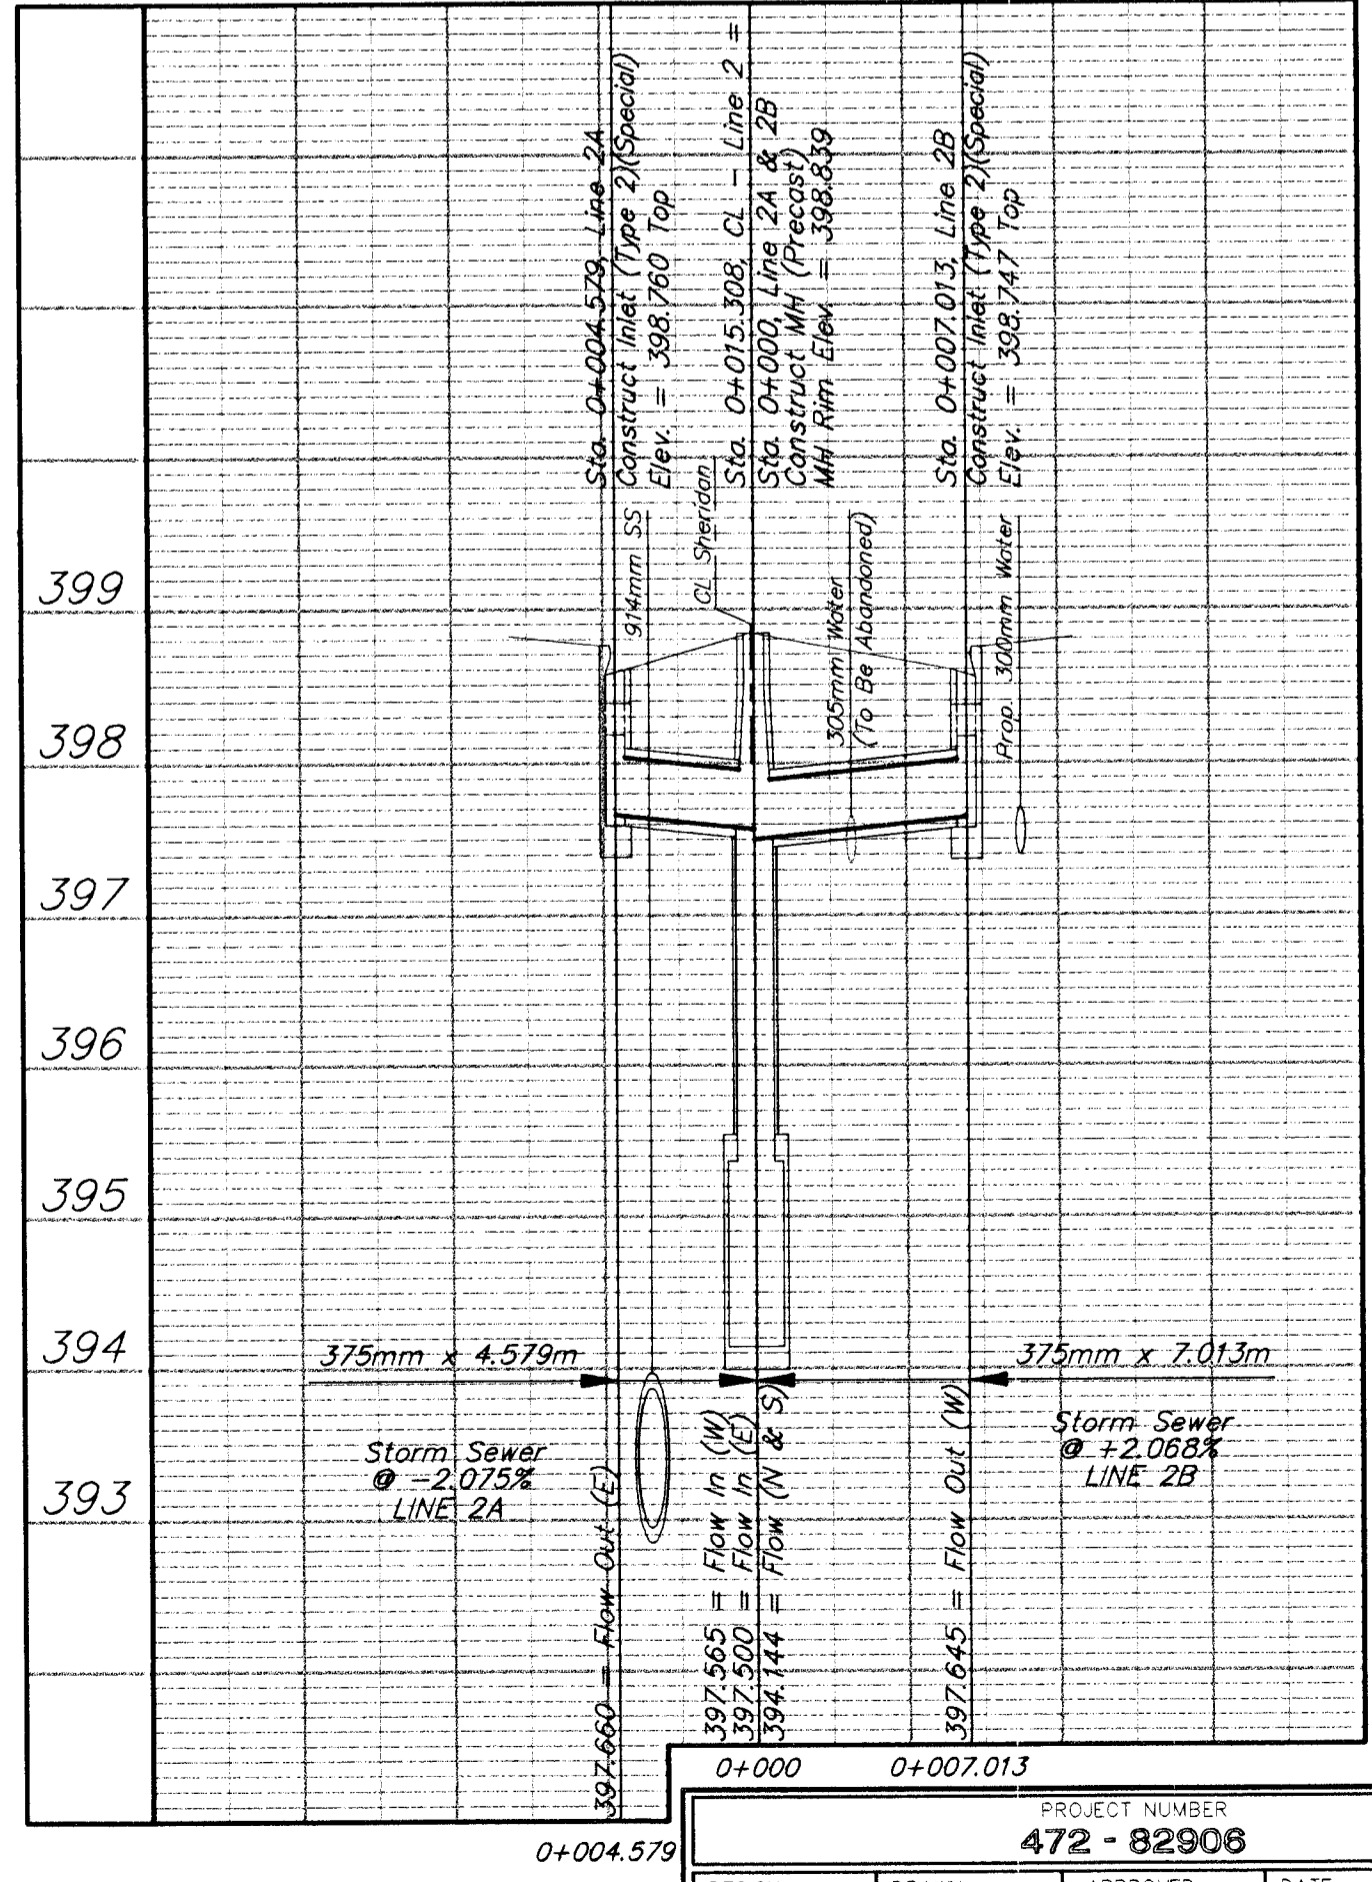
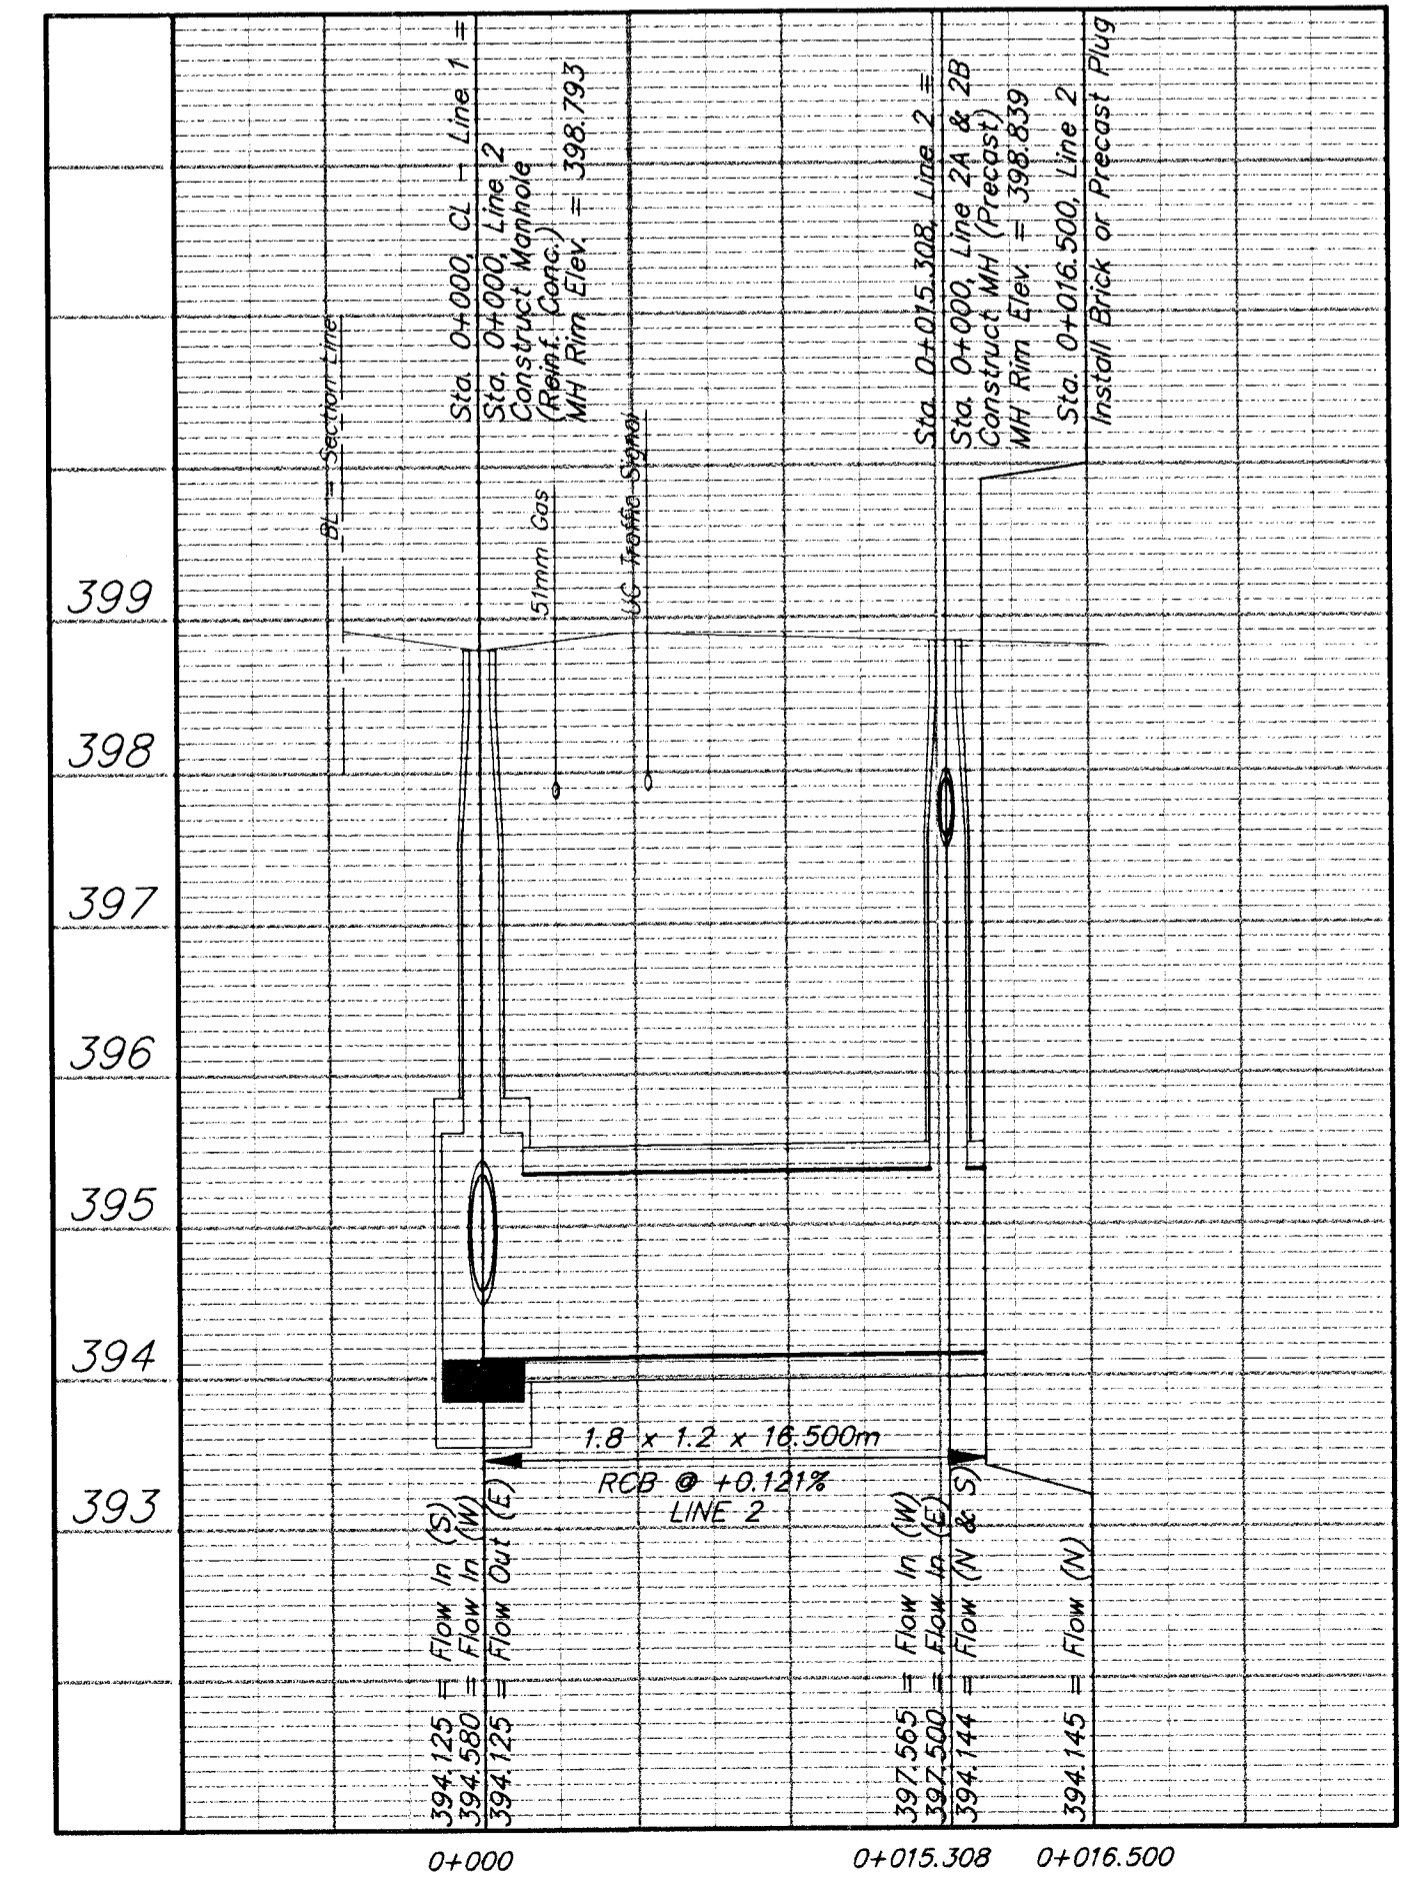


FHWA REGION NO.	STATE	PROJECT NUMBER	FISCAL YEAR	SHEET NUMBER	TOTAL SHEETS
7	KANSAS	B7N-0094-01	1998	67	202

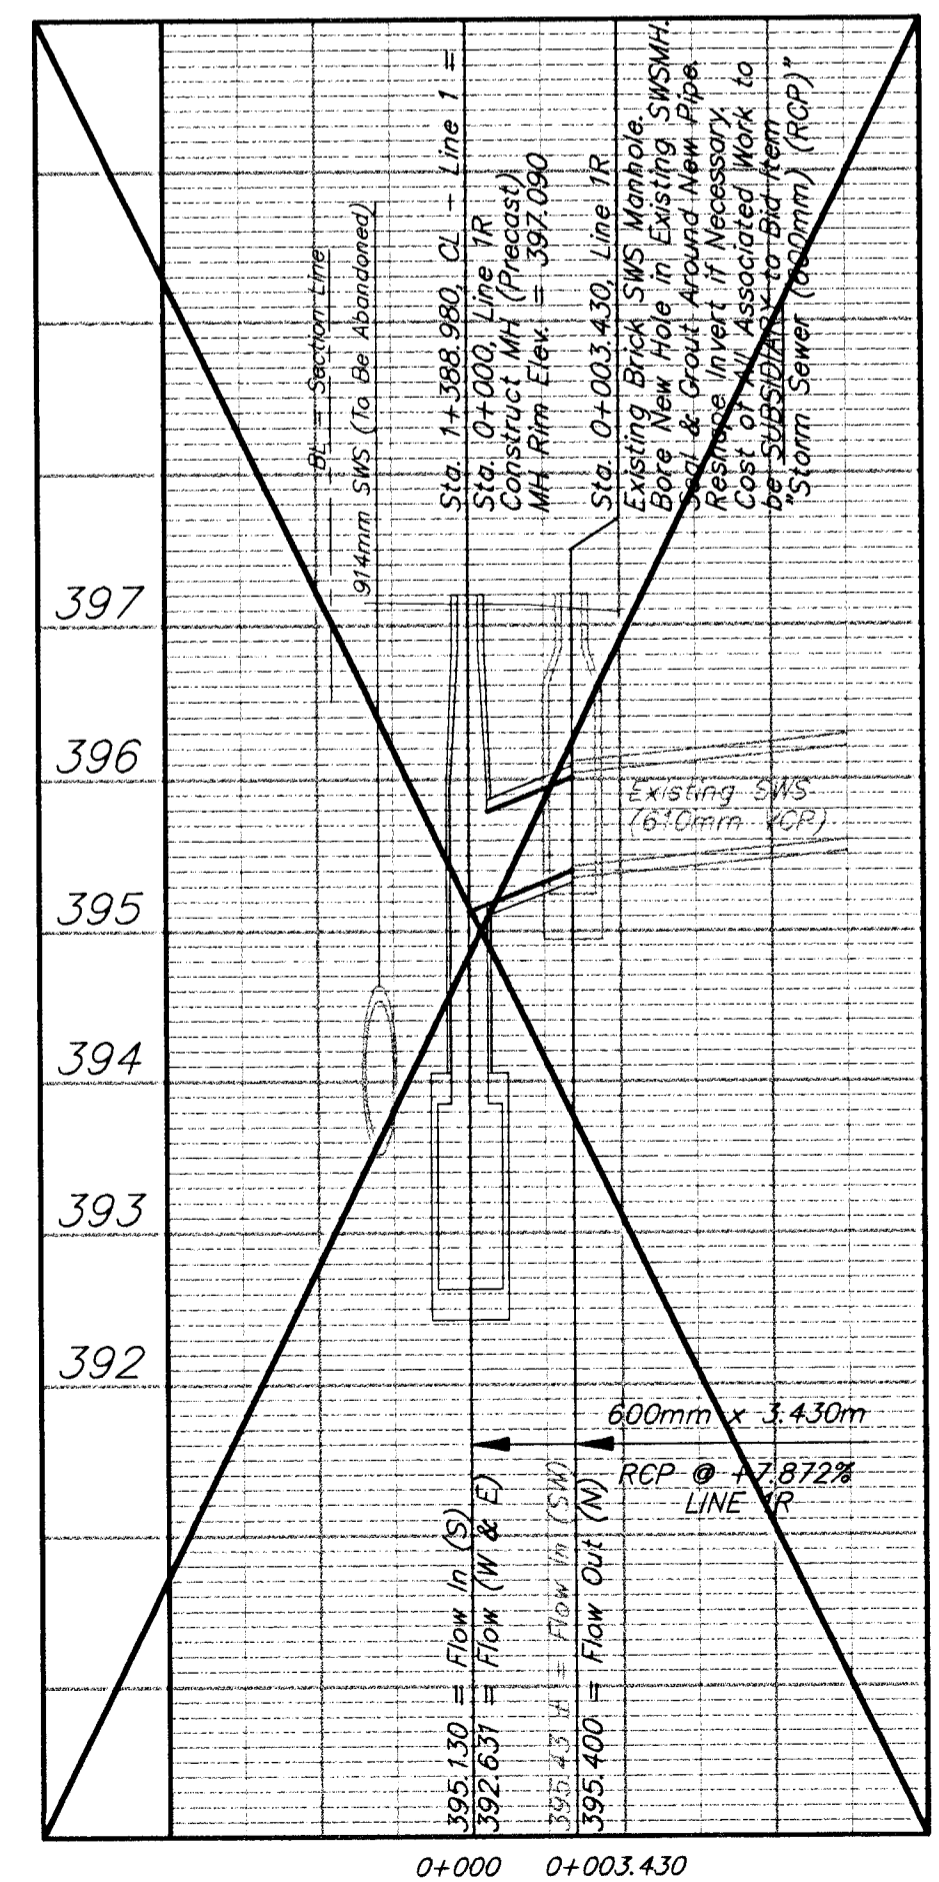

PROJECT NUMBER	472-82906
DESIGN STAFF	STAFF
DRAWN STAFF	STAFF
APPROVED	JFB
DATE	NOV 98
SCALE	NOTED

STORM WATER IMPROVEMENTS
SWS PROFILES
 CENTRAL AVENUE - PHASE 1 - WEST ST TO MCLEAN

BAUGHMAN COMPANY P.A.
 ENGINEERING, SURVEYING, & PLANNING
 316-282-7271 • 315 ELLIS • WICHITA, KANSAS 67211