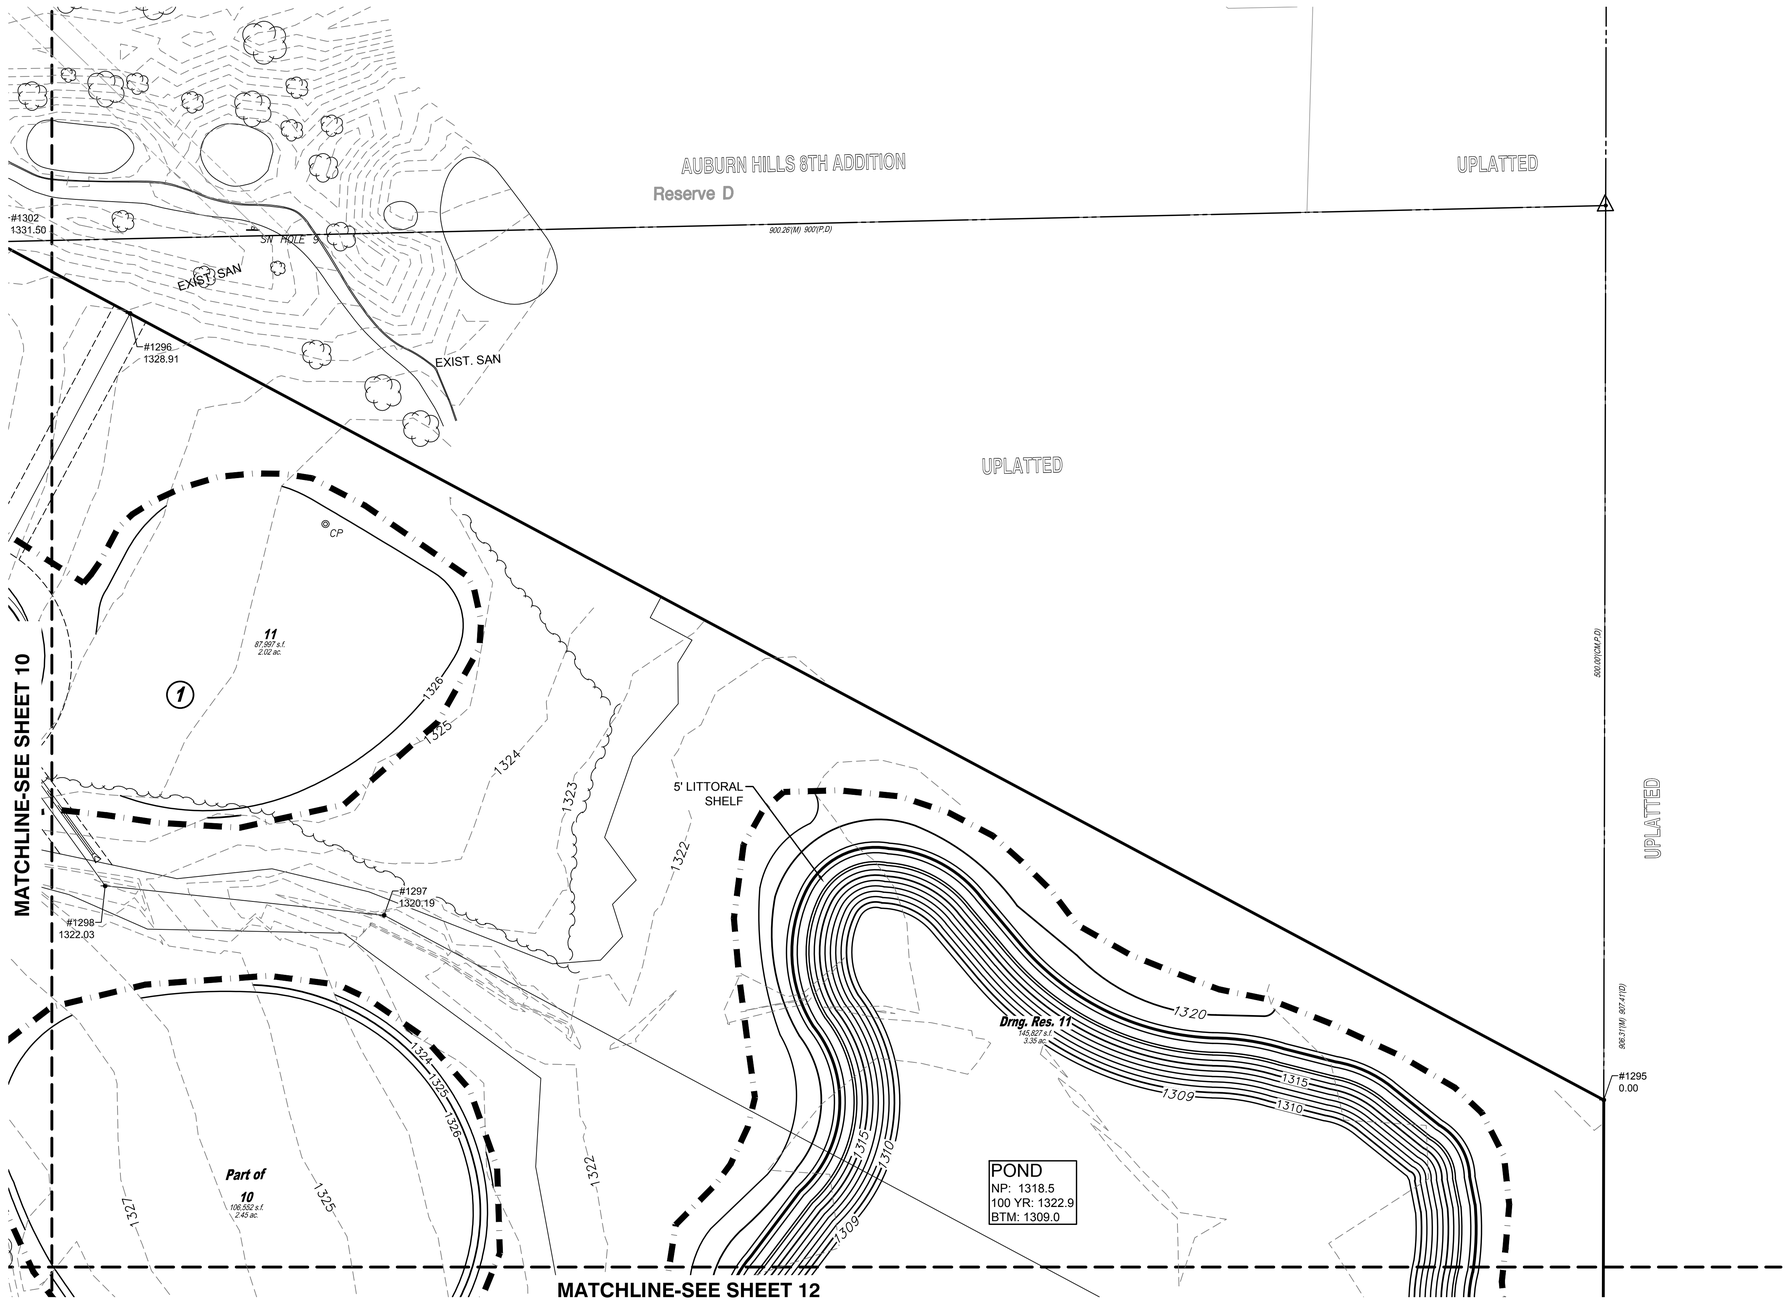

LEGEND

1250	EXISTING CONTOUR
1250	PROPOSED CONTOUR
W	WATER LINE
	PROP. STORMWATER SEWER
	EXISTING SANITARY SEWER
	EXISTING STORMWATER SEWER
UGT	EXISTING UNDERGROUND TELEPHONE
UGE	EXISTING UNDERGROUND ELECTRICAL
OHE	EXISTING OVERHEAD ELECTRICAL
	LIMITS OF GRADING
1329.86	SPOT ELEVATIONS
	TREE PROTECTION

N

1"=40'

NOTES:
VERTICAL DATUM USED IS NAVD88.

ALL STREET GRADES SHOWN ARE TO TOP OF PAVEMENT. CONTRACTOR SHALL OVER EXCAVATE ROADS TO TOP OF SUBGRADE. REFER TO ROAD CROSS SECTION DETAIL, SEE SHEET 03.

1 GRADING CHANGES DUE TO GROUNDWATER ELEVATION

MKEC
Wichita, KS • 316-684-9600

GRADING PLANS FOR
AUBURN LAKES ADDITION
PART A

©2018
MKEC Engineering
All Rights Reserved
www.mkec.com
These drawings and their contents, including, but not limited to, all concepts, designs, & ideas are the exclusive property of MKEC Engineering (MKEC), and may not be used or reproduced in any way without the express consent of MKEC.

GRADING PLAN

PROJECT NO.	468-85308
DATE	MAY 2018
SCALE	1"=40'

DESIGNED	DRAWN	CHECKED
DFL	ABW	DFL

NO.	REVISION	DATE
1	GRADING CHANGES	06-22-18

SHEET NO.
11 OF 28

PLOTTED: Friday, June 15, 2018 @ 10:05AM

J:\PROJECTS\2016\160101221_PERFECTION_AUBURN_LAKES_16221 CAD\SHTS\05 CIVIL\GRD\16221-05-1200.DWG