
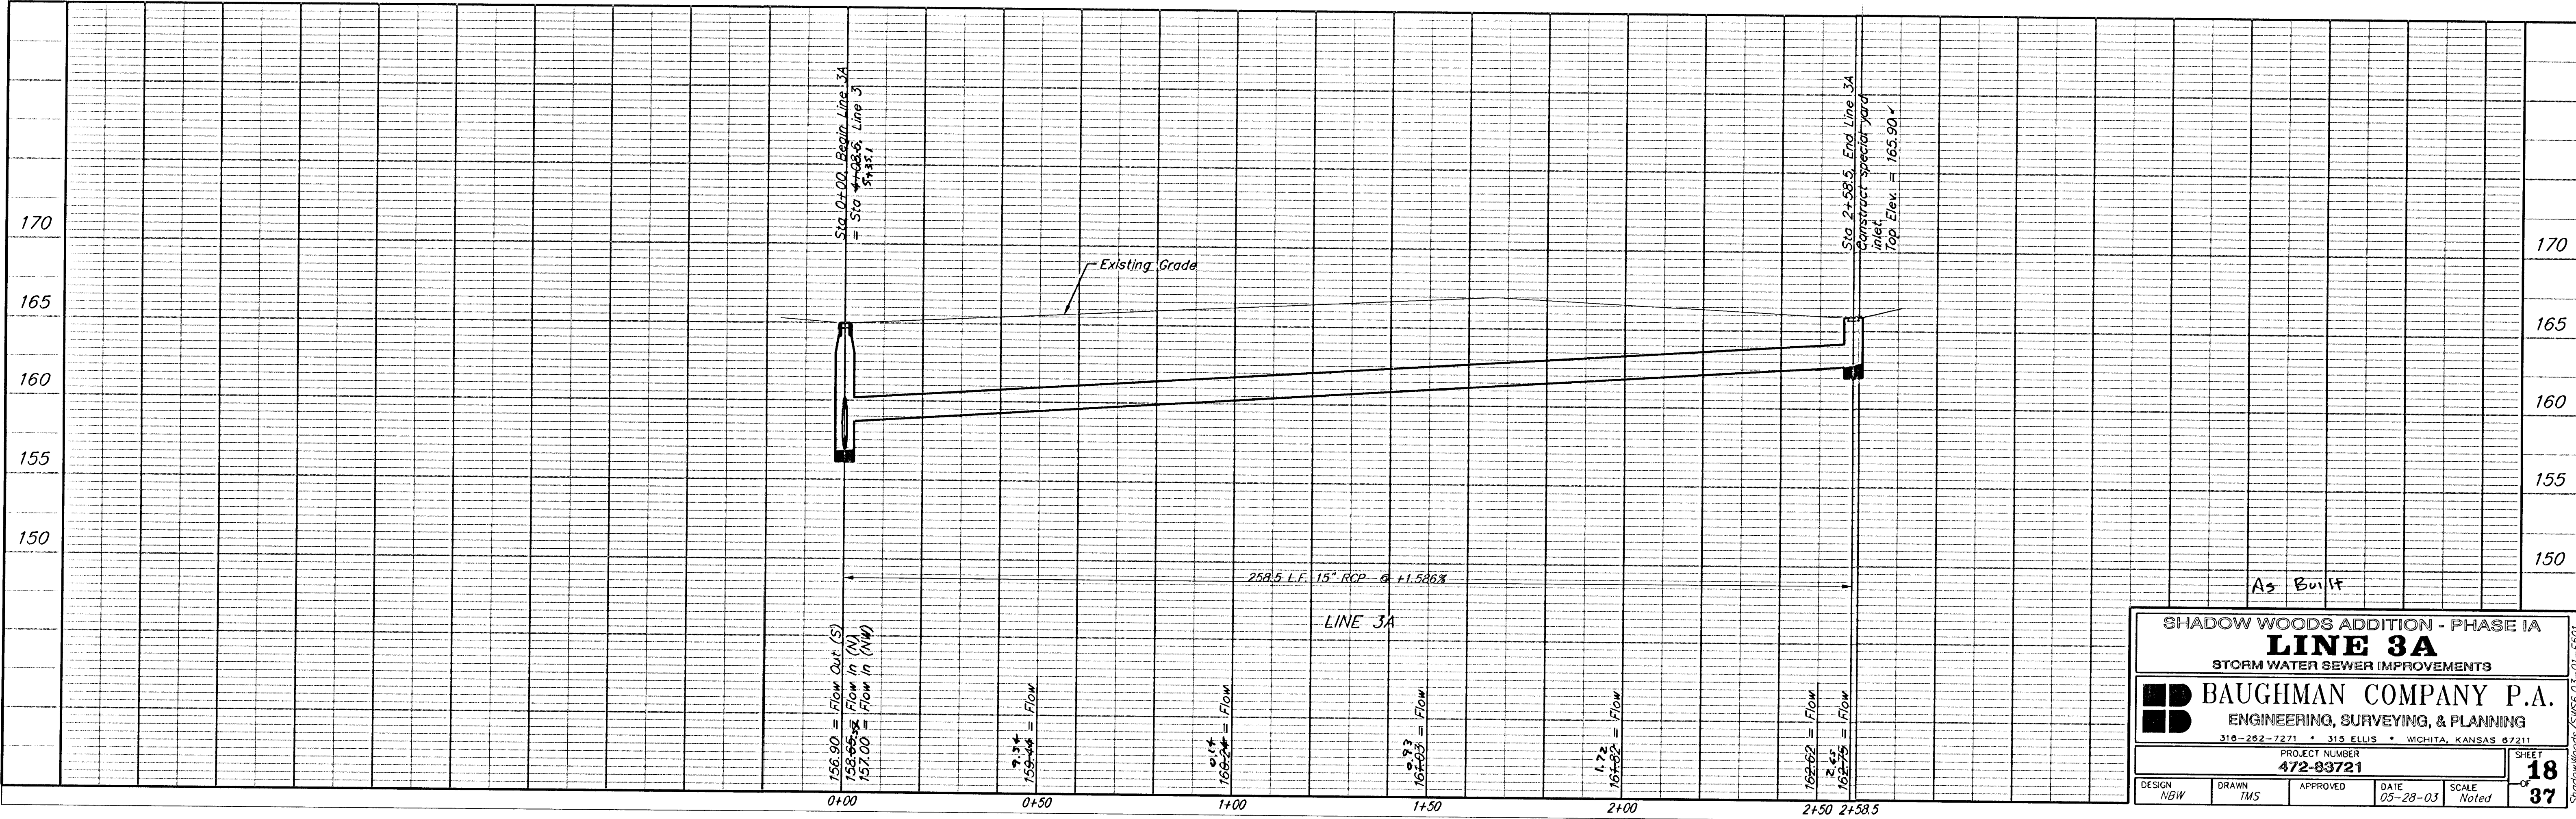


RR Spike in N. Face of PP in
N. R/W of Maple N. of Nineiron.
Elev. = 177.01 (City Datum)

"□" Cut center of north
Headwall of RCBC in N. R/W of
Maple 570' East of centerline
of City View.
Elev. = 187.91 (City Datum)

Scale: 1" = 20' Horizontal
1" = 5' Vertical
• = Iron

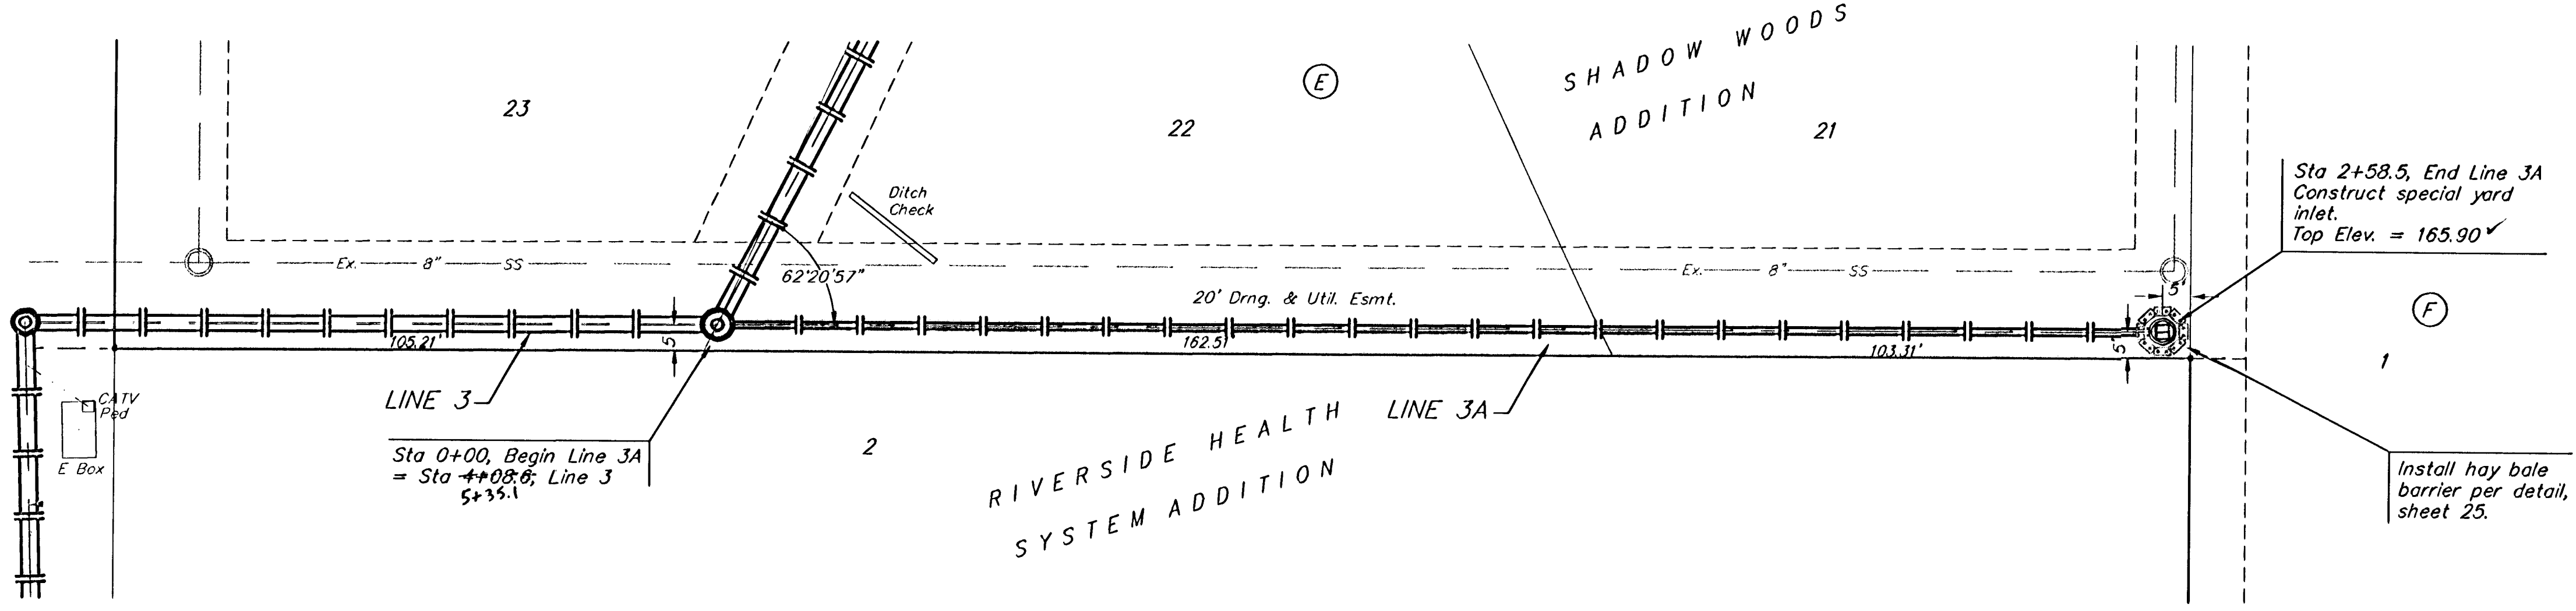

SHADOW WOODS ADDITION - PHASE 1A
LINE 3A
STORM WATER SEWER IMPROVEMENTS

BAUGHMAN COMPANY P.A.
ENGINEERING, SURVEYING, & PLANNING
310-262-7271 • 315 ELLIS • WICHITA, KANSAS 67211

PROJECT NUMBER
472-83721

DESIGN NBW DRAWN TMS APPROVED DATE 05-28-03 SCALE Noted

SHEET
OF
18
OF
37