
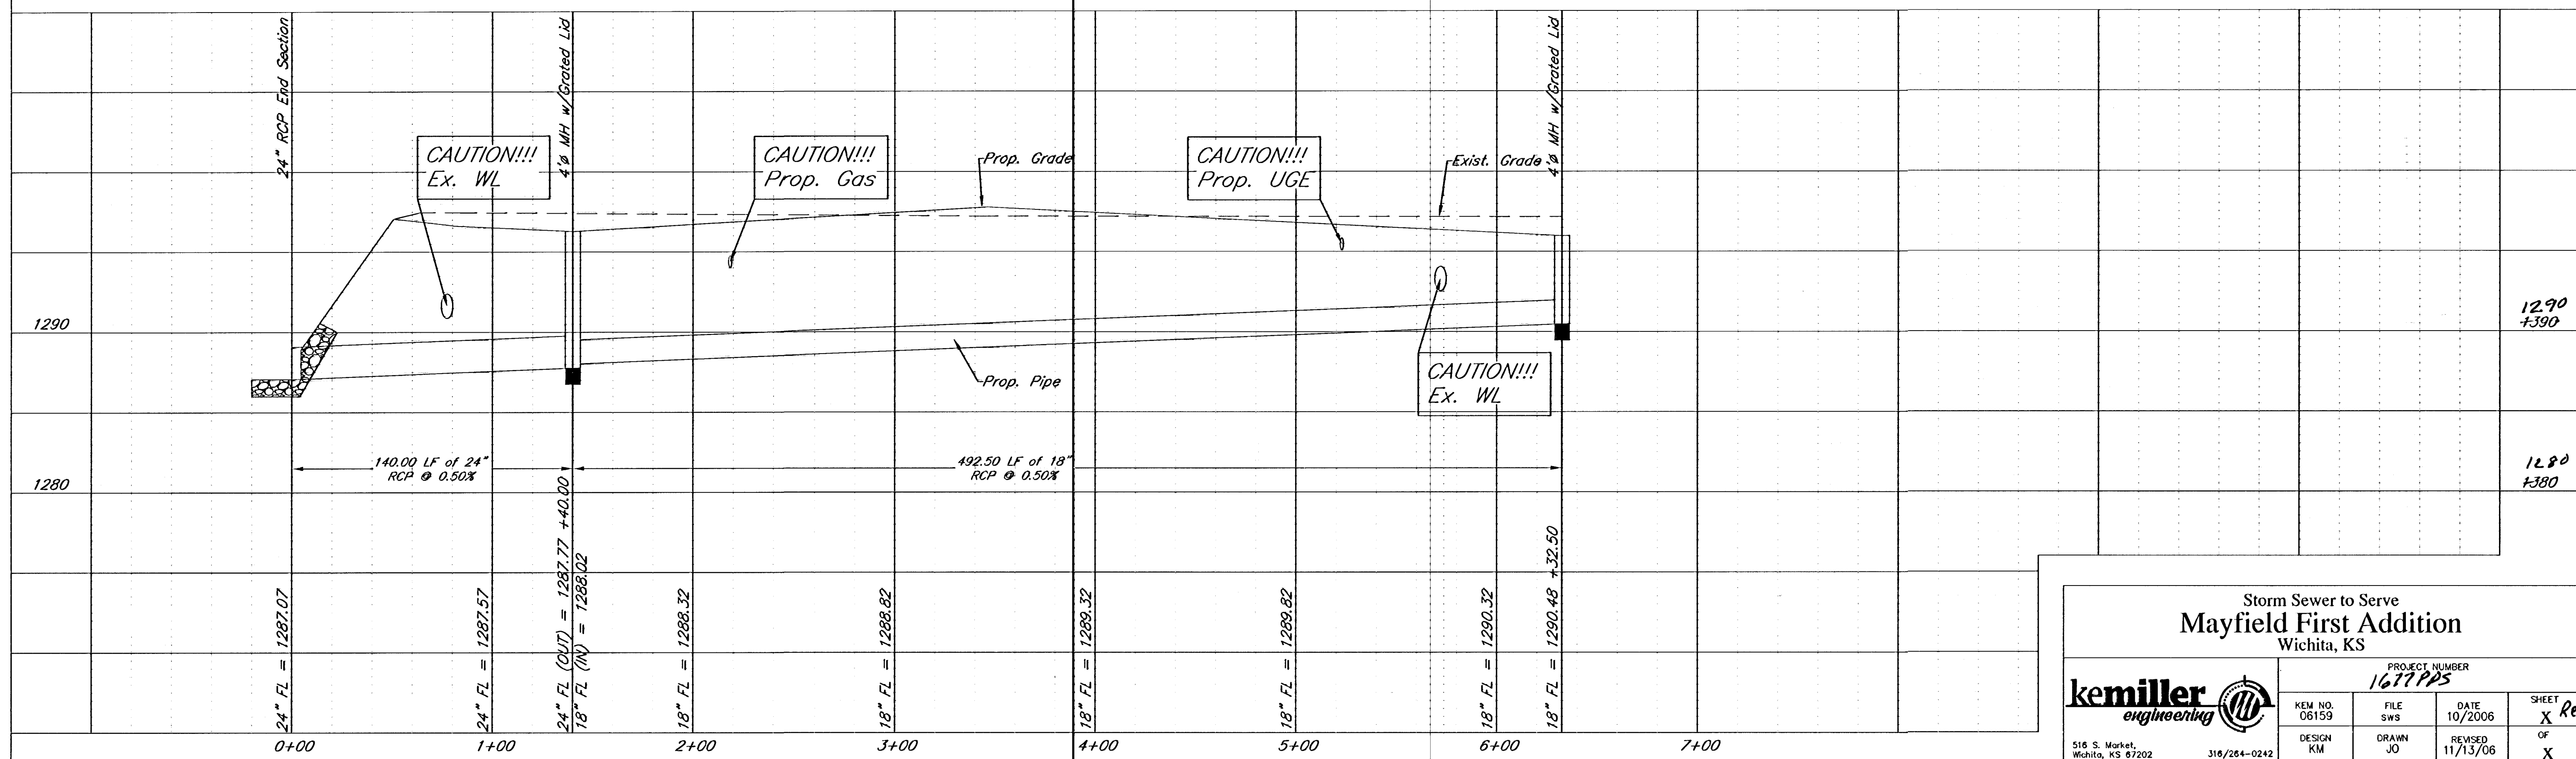


2441701
202

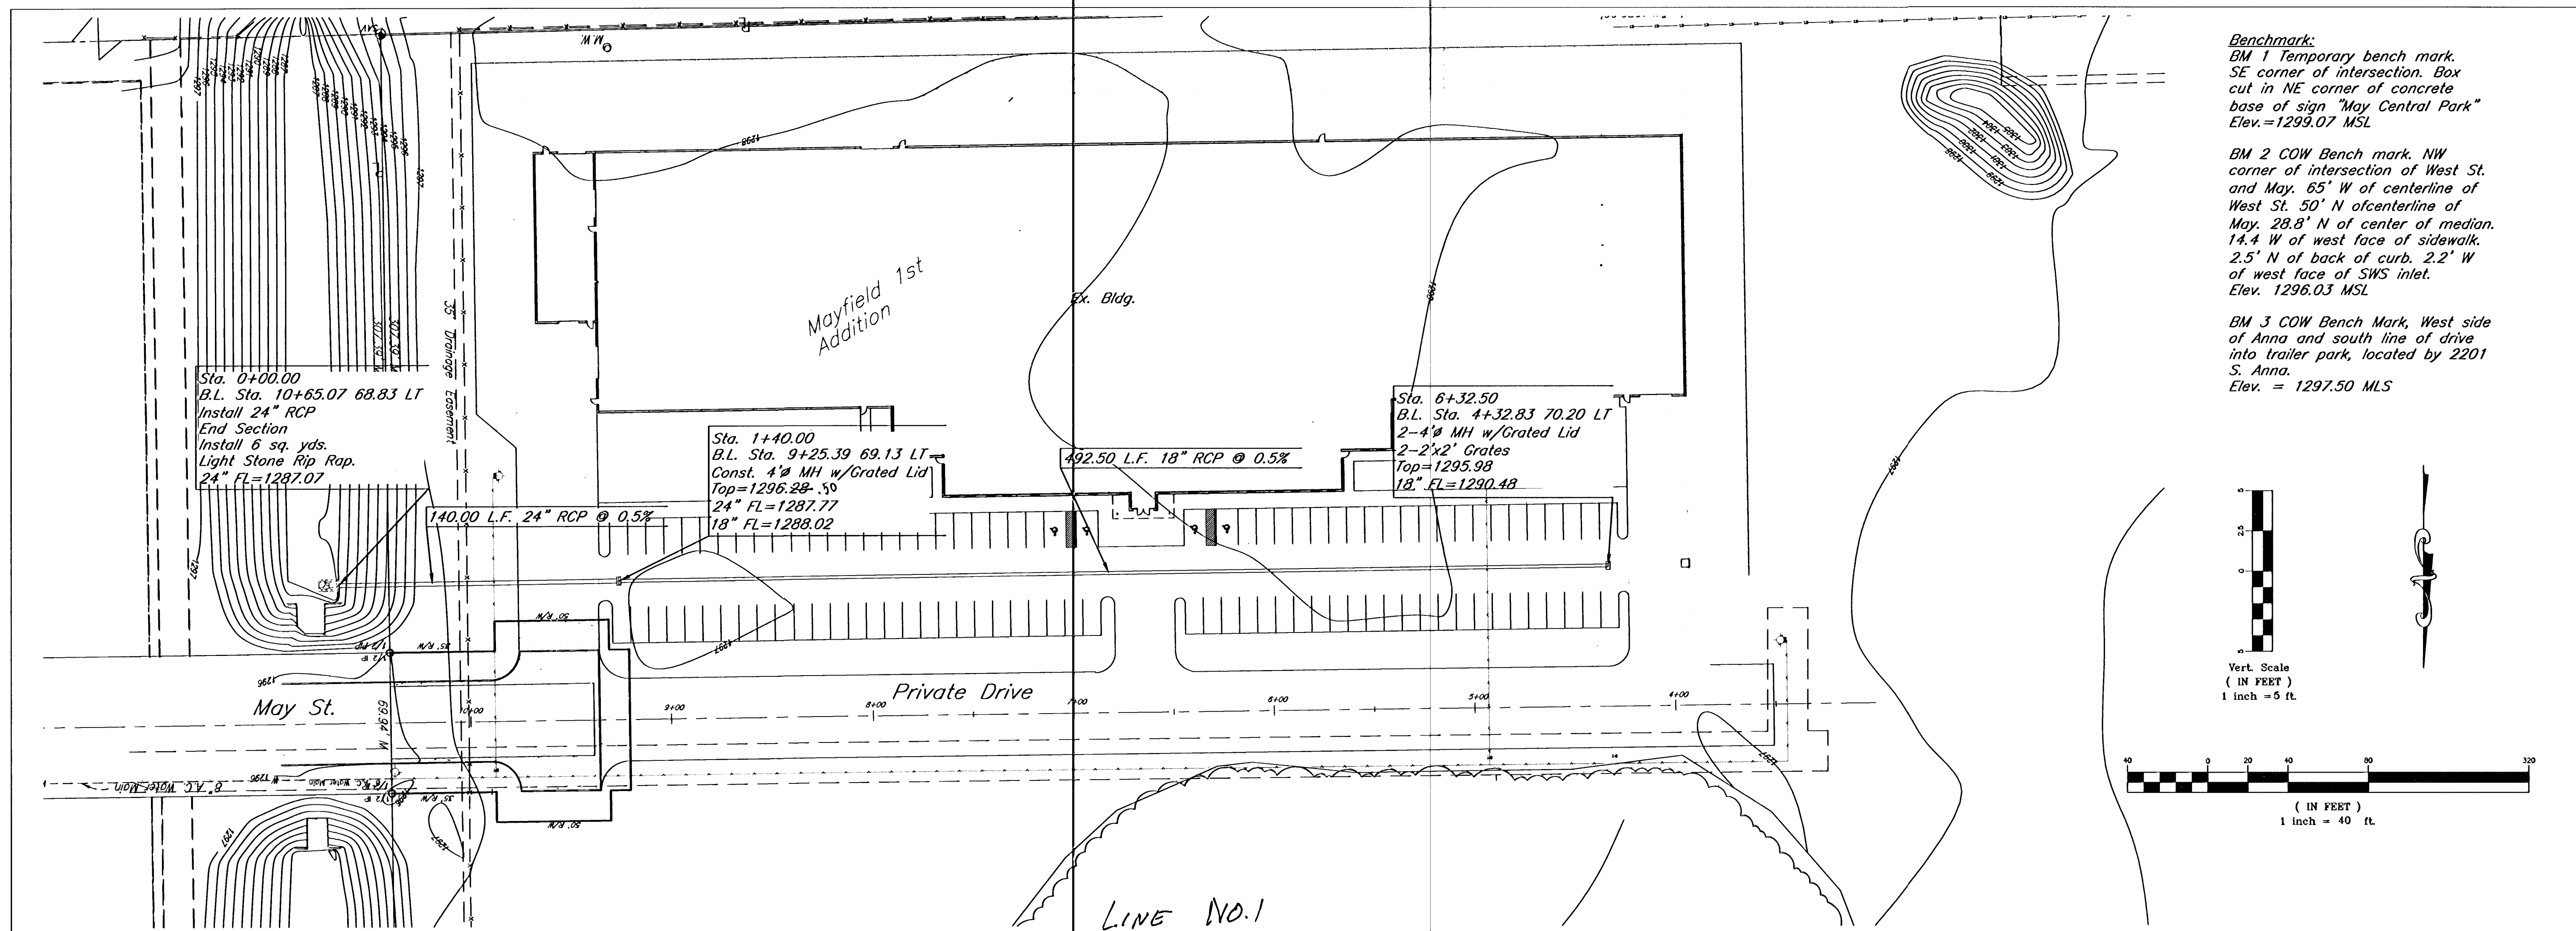

Storm Sewer to Serve Mayfield First Addition Wichita, KS				
kemiller engineering		PROJECT NUMBER 1677PPS		
KEM NO. 06159	FILE SWS	DATE 10/2006	SHEET X	
DESIGN KM	DRAWN JO	REVISED 11/13/06	OF X	

Revised sheet
2
of 8