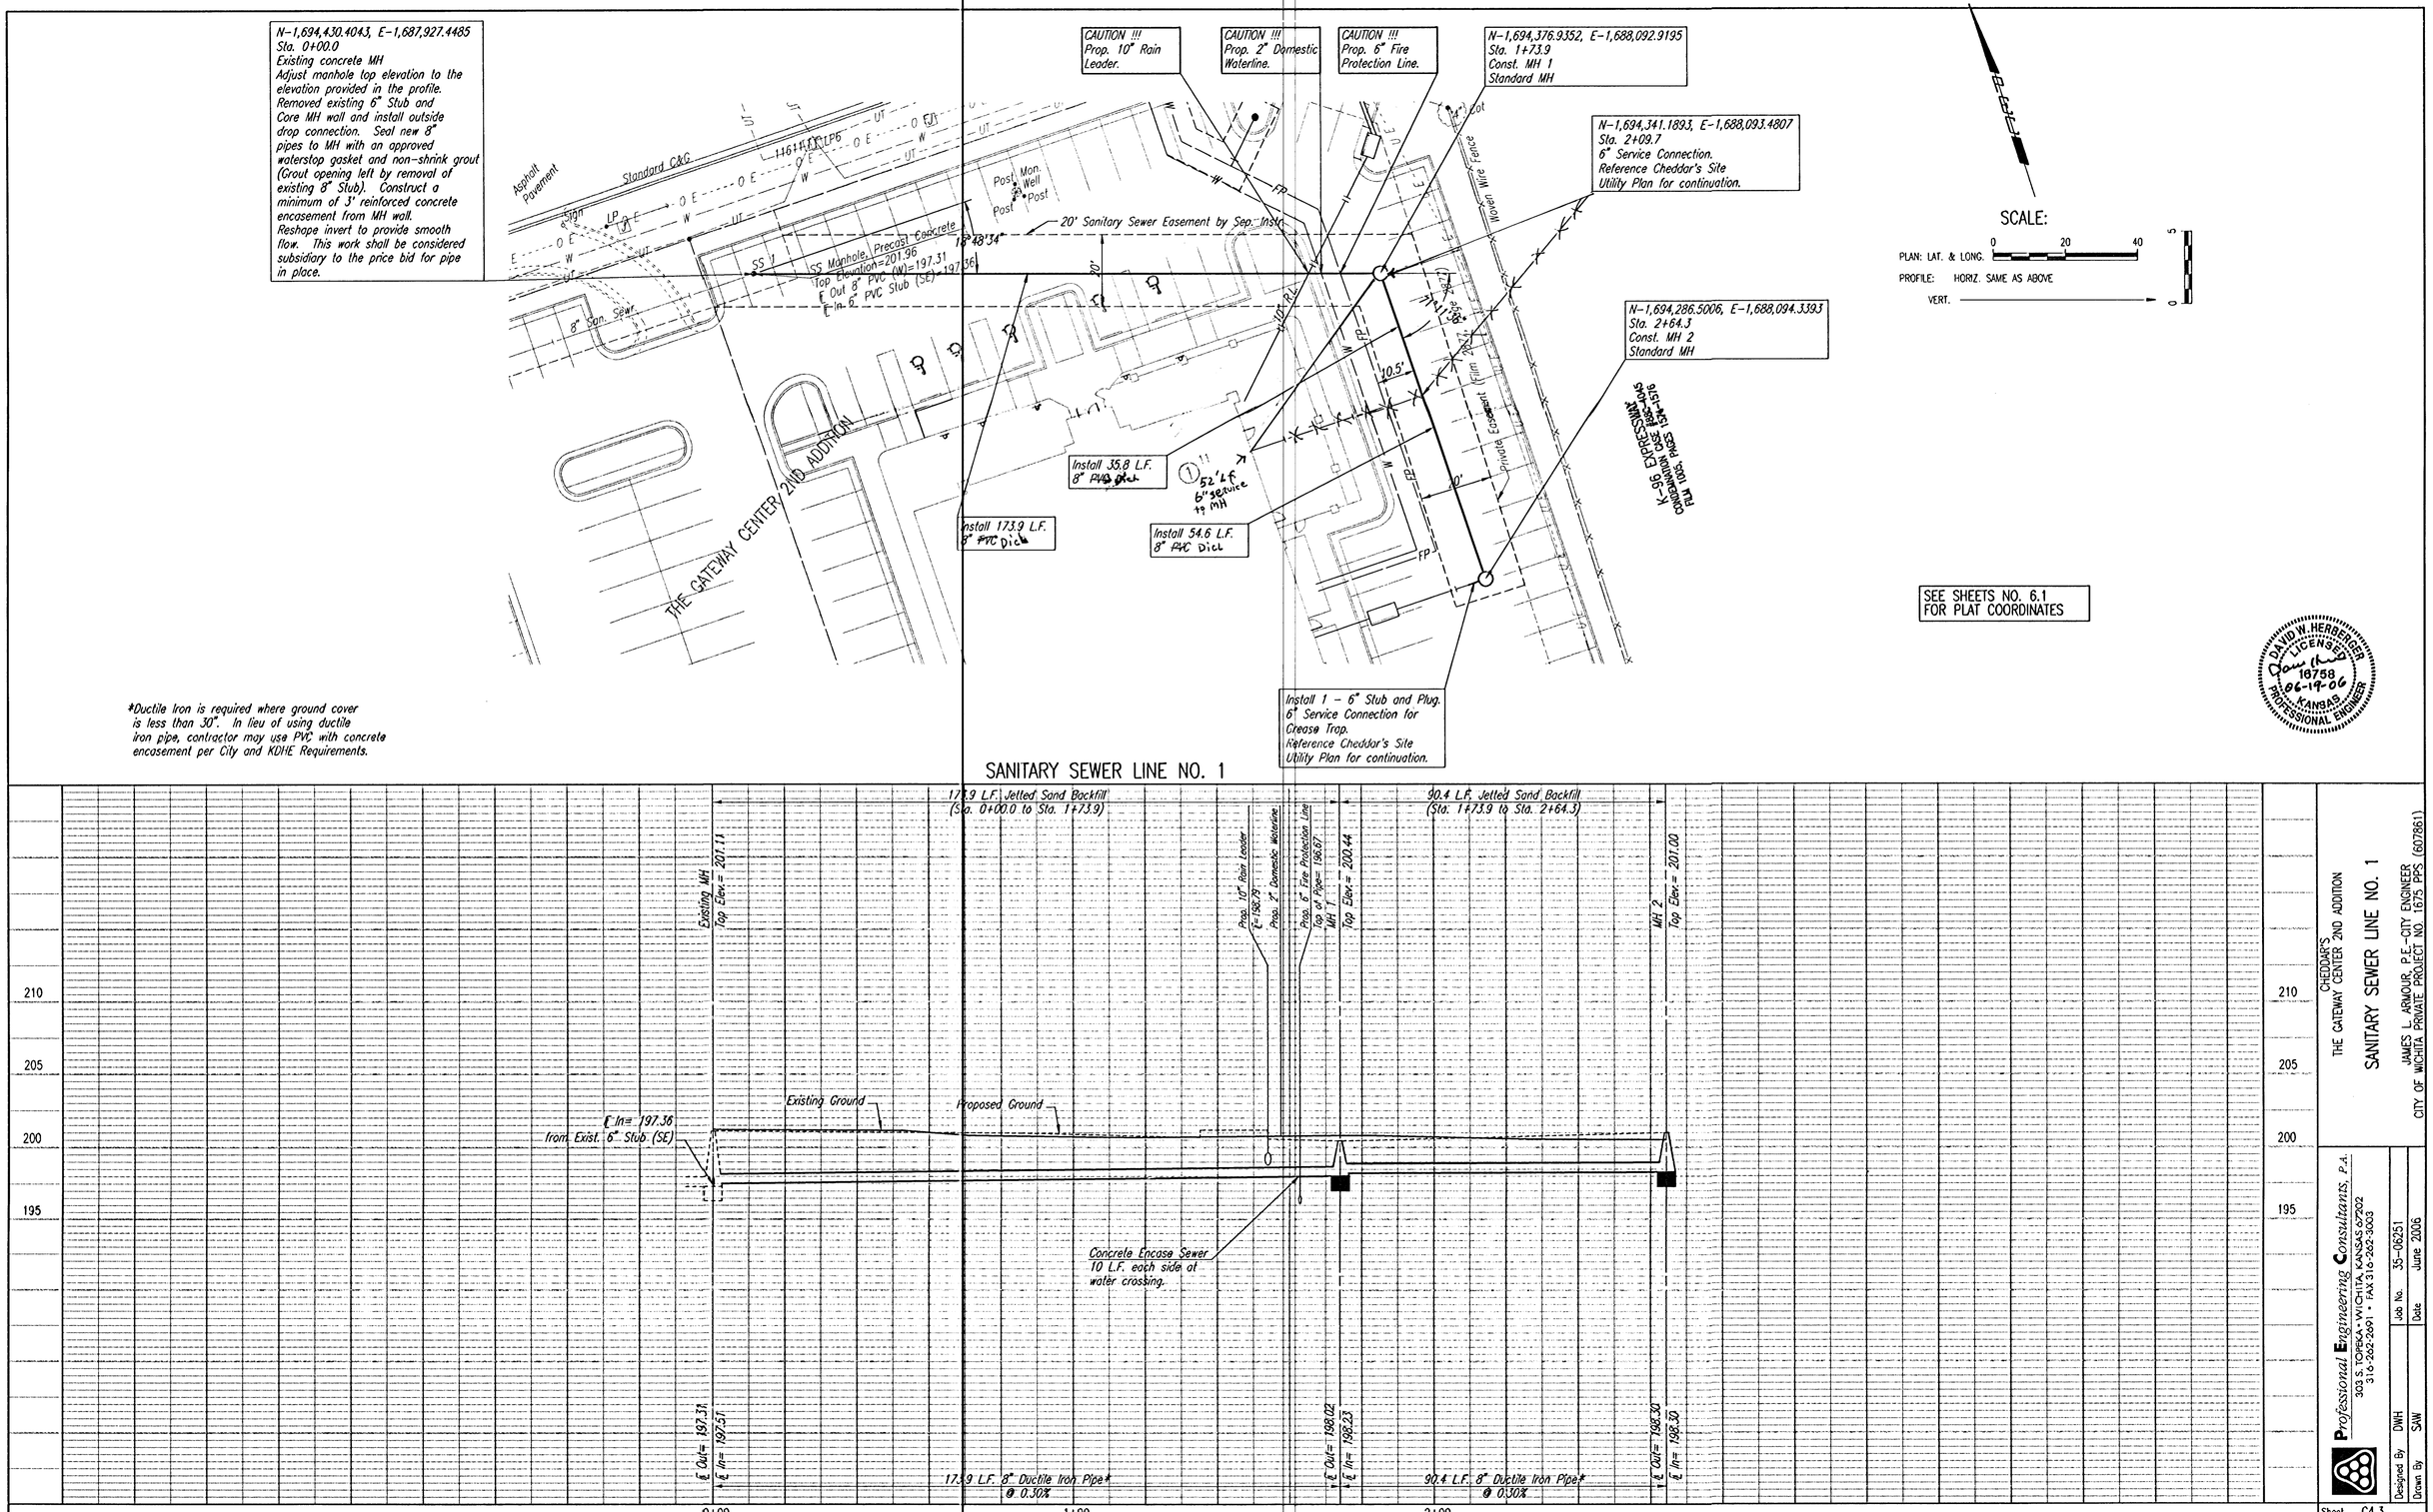

PLAN | CHECKED | CHECKED | BY | DATE

PROFILE | CHECKED | CHECKED | BY | DATE

CHEDDAR'S
THE GATEWAY CENTER 2ND ADDITION
SANITARY SEWER LINE NO. 1
JAMES L. ARMOUR, P.E.-CITY ENGINEER
CITY OF WICHITA PRIVATE PROJECT NO. 1675 PPS (607861)

Professional Engineering Consultants, P.A.
303 S. TOPEKA • WICHITA, KANSAS 67202
316-262-2691 • FAX 316-262-3003

Designed By DWH | Job No. 35-06251
Drawn By SAW | Date June 2006

Sheet C4.3

Saved 06-22-2006 1:26:08 PM by SAW
Plot Scale 1:20 06-22-2006 1:32:54 PM by SAW
Q:\2006\06251\Site Civil\Private Plans\SS\06251-C-SSPP1