


BENCHMARKS:
 BM #1: "□" Cut on top of SE Cor. of utility pad, adjacent to the SW Cor. Lot 40, Block A, Northgate Addition.
 Elev. = 1340.12 NGVD29

BM #2: "□" Cut on top of NE Cor. of water vault, 437± E. & 54± N. of S1/4 Cor., Sec. 13, TWP 26-S, R-1-W.
 Elev. = 1334.81 NGVD29

BM #3: "□" Cut on top of curb, adjacent to the SW Cor. Lot 17, Block D, Northgate Addition.
 Elev. = 1338.47 NGVD29

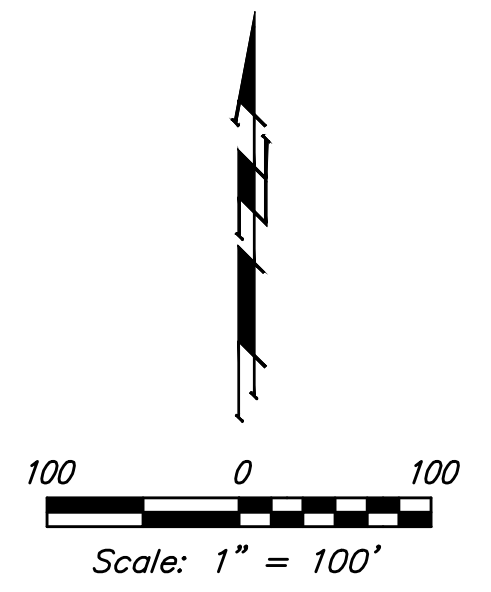

IRONS			IRONS			IRONS			IRONS						
Point #	Northing	Easting	Description	Point #	Northing	Easting	Description	Point #	Northing	Easting	Description	Point #	Northing	Easting	Description
1	8045.07	4940.01	iron	56	6904.15	4339.75	iron	111	8192.54	2869.38	iron	166	7765.27	3766.42	iron

WATER LINE POINTS			
Point #	Northing	Easting	Description
6001	8342.23	3631.87	0+00
6002	8344.42	3611.99	PC
6003	8404.31	3481.21	PT
6004	8431.55	3452.24	TEE
6005	8623.23	3248.17	PC
6006	8671.01	3130.97	PT
6007	8671.53	3097.43	VLV
6008	8671.84	3077.44	FH
6009	8476.71	3494.72	FH
6010	8500.27	3516.88	BEND
6011	8539.14	3532.64	BEND
6012	8628.59	3534.02	BEND
6013	8645.06	3551.00	BEND
6014	8677.96	3551.51	BEND
6015	8701.59	3528.61	BEND
6016	8702.10	3495.70	BEND
6017	8679.19	3472.07	BEND
6018	8658.49	3471.75	BO



Baughman Northgate Addition - Phase 2A
COORDINATES
 Water Distribution System

Baughman Company, P.A. 315 Ellis St. Wichita, KS 67211 P 316-262-7271 F 316-262-0149
 ENGINEERING | SURVEYING | PLANNING | LANDSCAPE ARCHITECTURE

PROJECT NUMBER 448-90243	DESIGN DMV	DRAWN JAK
REVISIONS:	APPROVED	DATE 8/20/18
	SCALE Noted	SHEET 12 OF 13

C:\Projects\Northgate\Phase 2A\WTR 18-04-9711\WTR PLANS.dwg