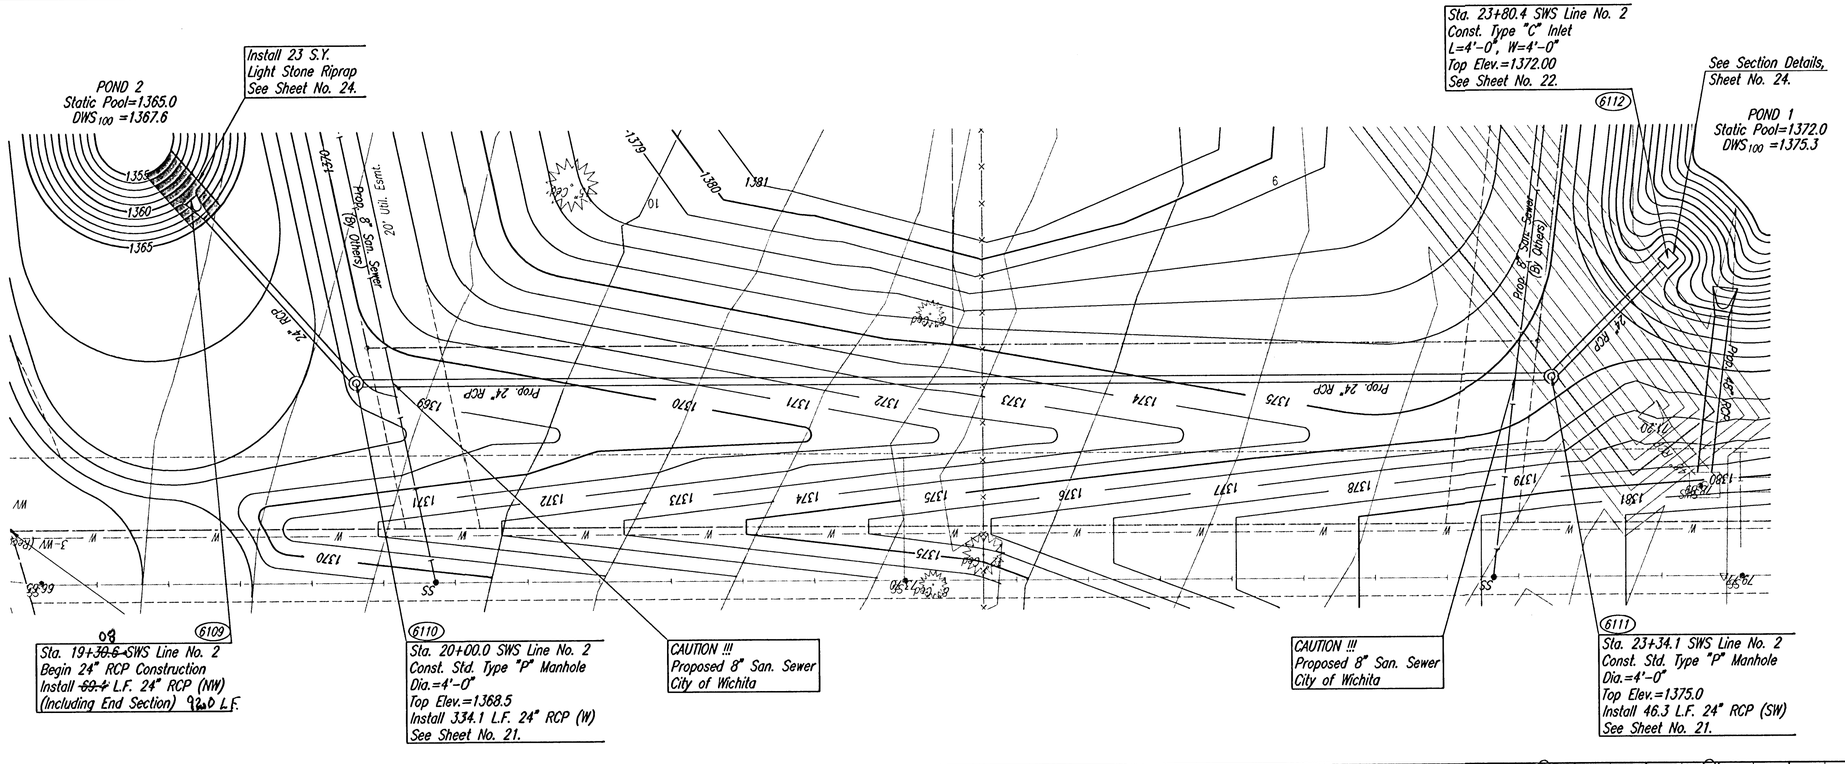

Scale 1"=20'

COORDINATE LIST		
POINT	NORTH	EAST
6109	386,526.6233	2,372,990.5439
6110	386,577.8082	2,372,943.7218
6111	386,573.2881	2,372,609.6822
6112	386,539.9989	2,372,577.5096

(6109) = COORDINATE POINT NO.
SEE SHEET NO. 2 FOR PLAT COORDINATES

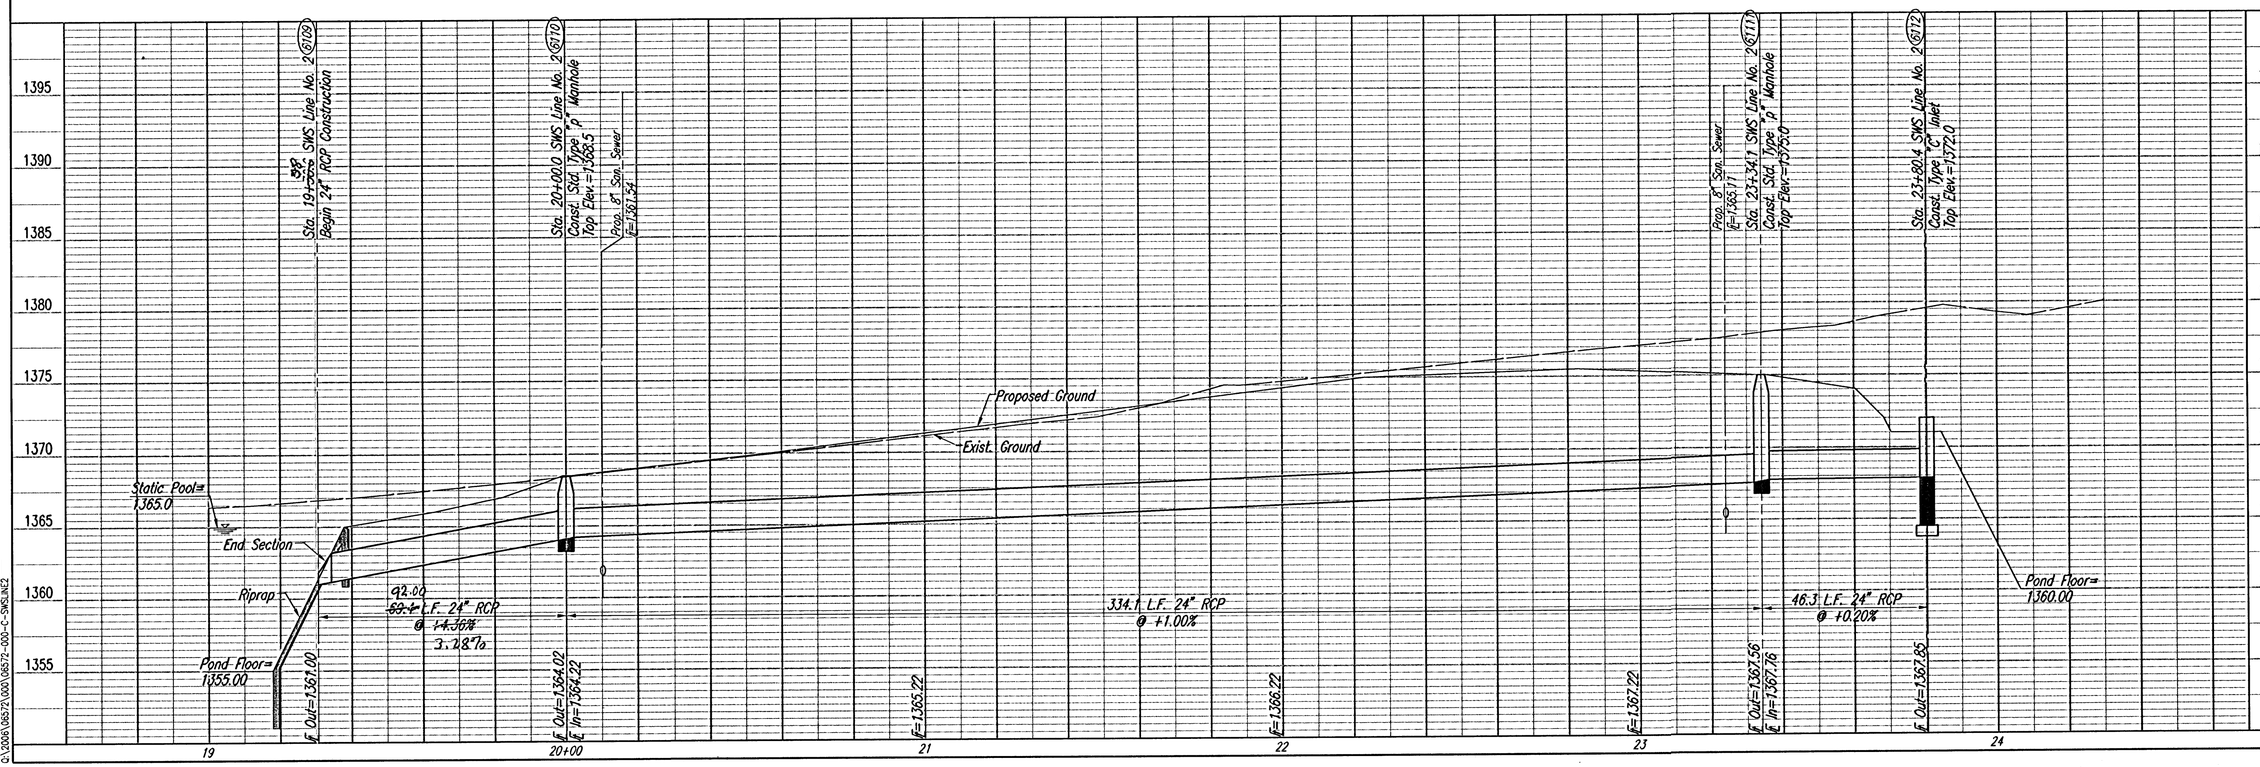

PLAN CHECKED CHECKED BY DATE

PROFILE CHECKED CHECKED BY DATE

OAK CREEK 3RD - PHASE 1

SWS LINE NO. 2

Professional Engineering Consultants, P.A.
303 S. TOPEKA • WICHITA, KANSAS 67202
316-262-2691 • FAX 316-262-3003

Designed By BDB, BMM
Drawn By BJS, TAT
Job No. 35-06572-000
Date February 2006

Saved 10-23-2006 6:58:50 PM by BDB
Plot Scale 1:20 10-31-2006 12:31:49 PM by BJS
Q:\2006\06572\000\06572-000-C-SWSLINE2