
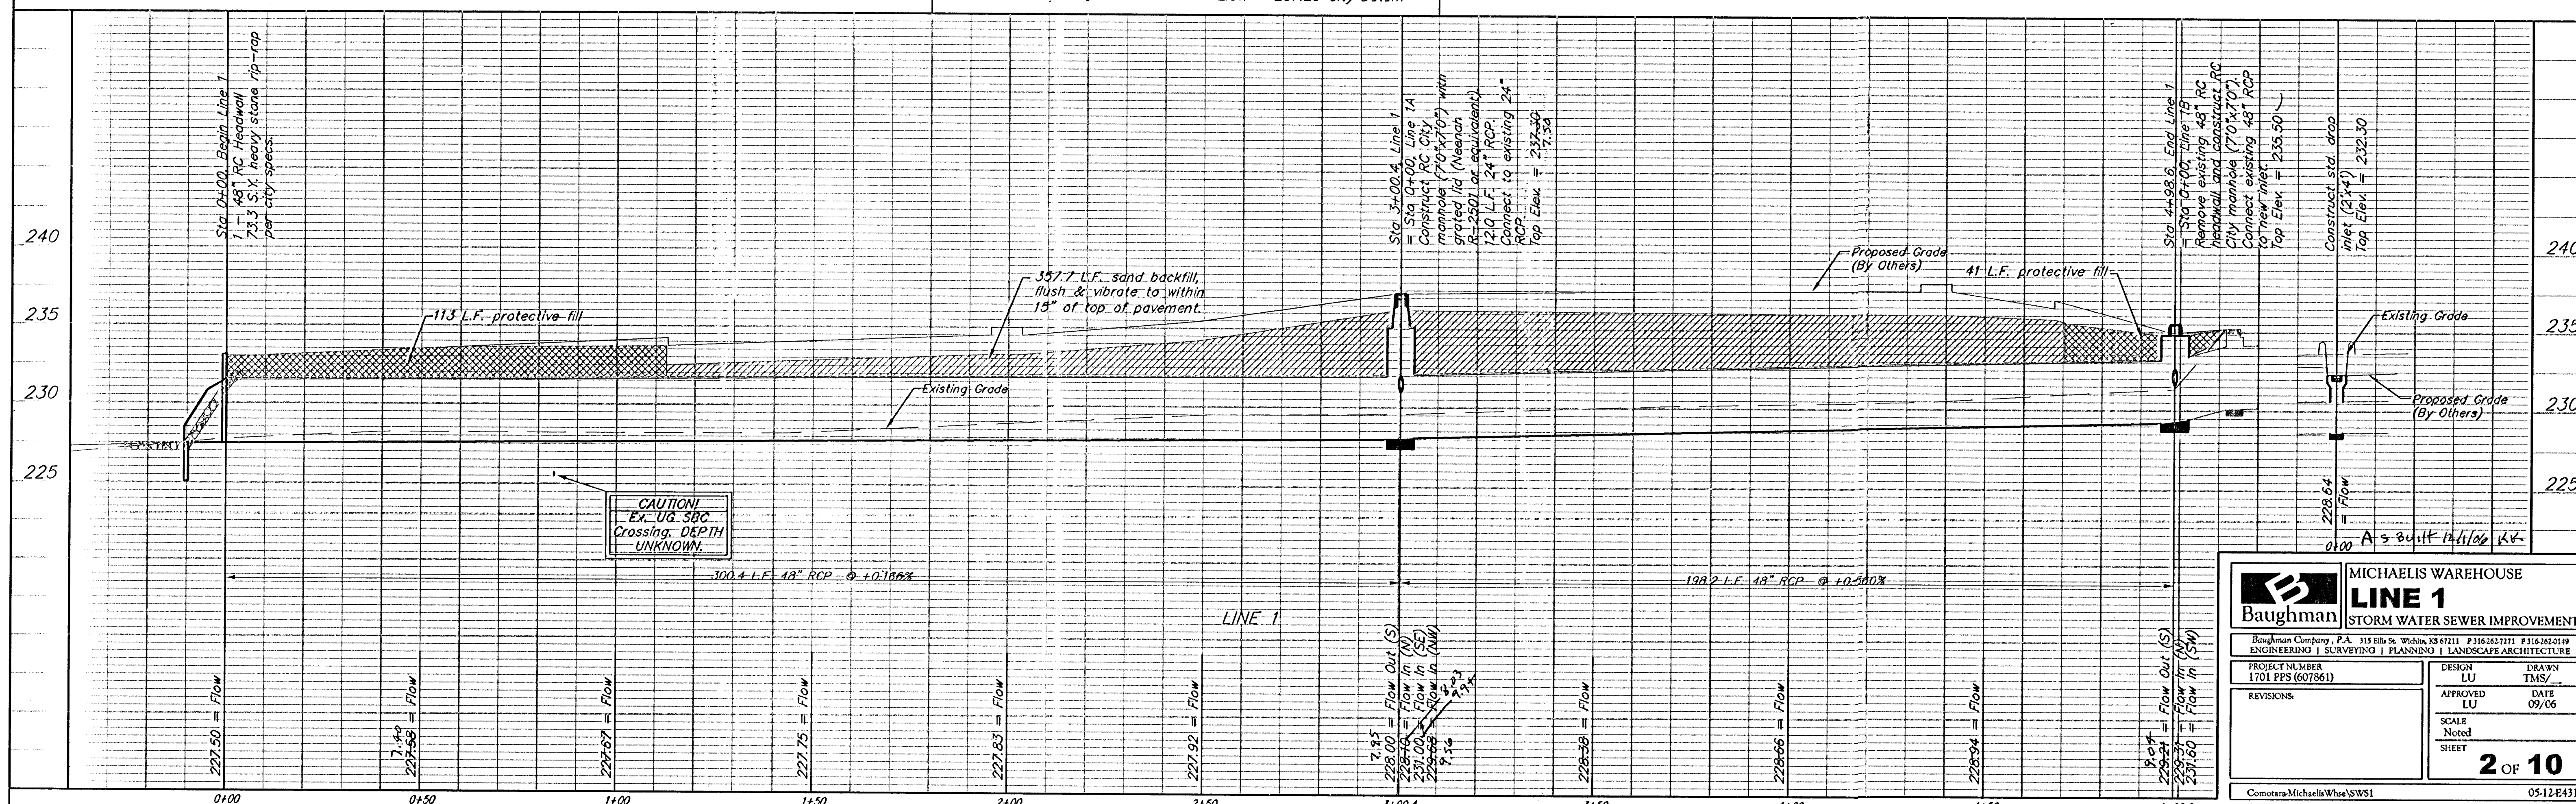


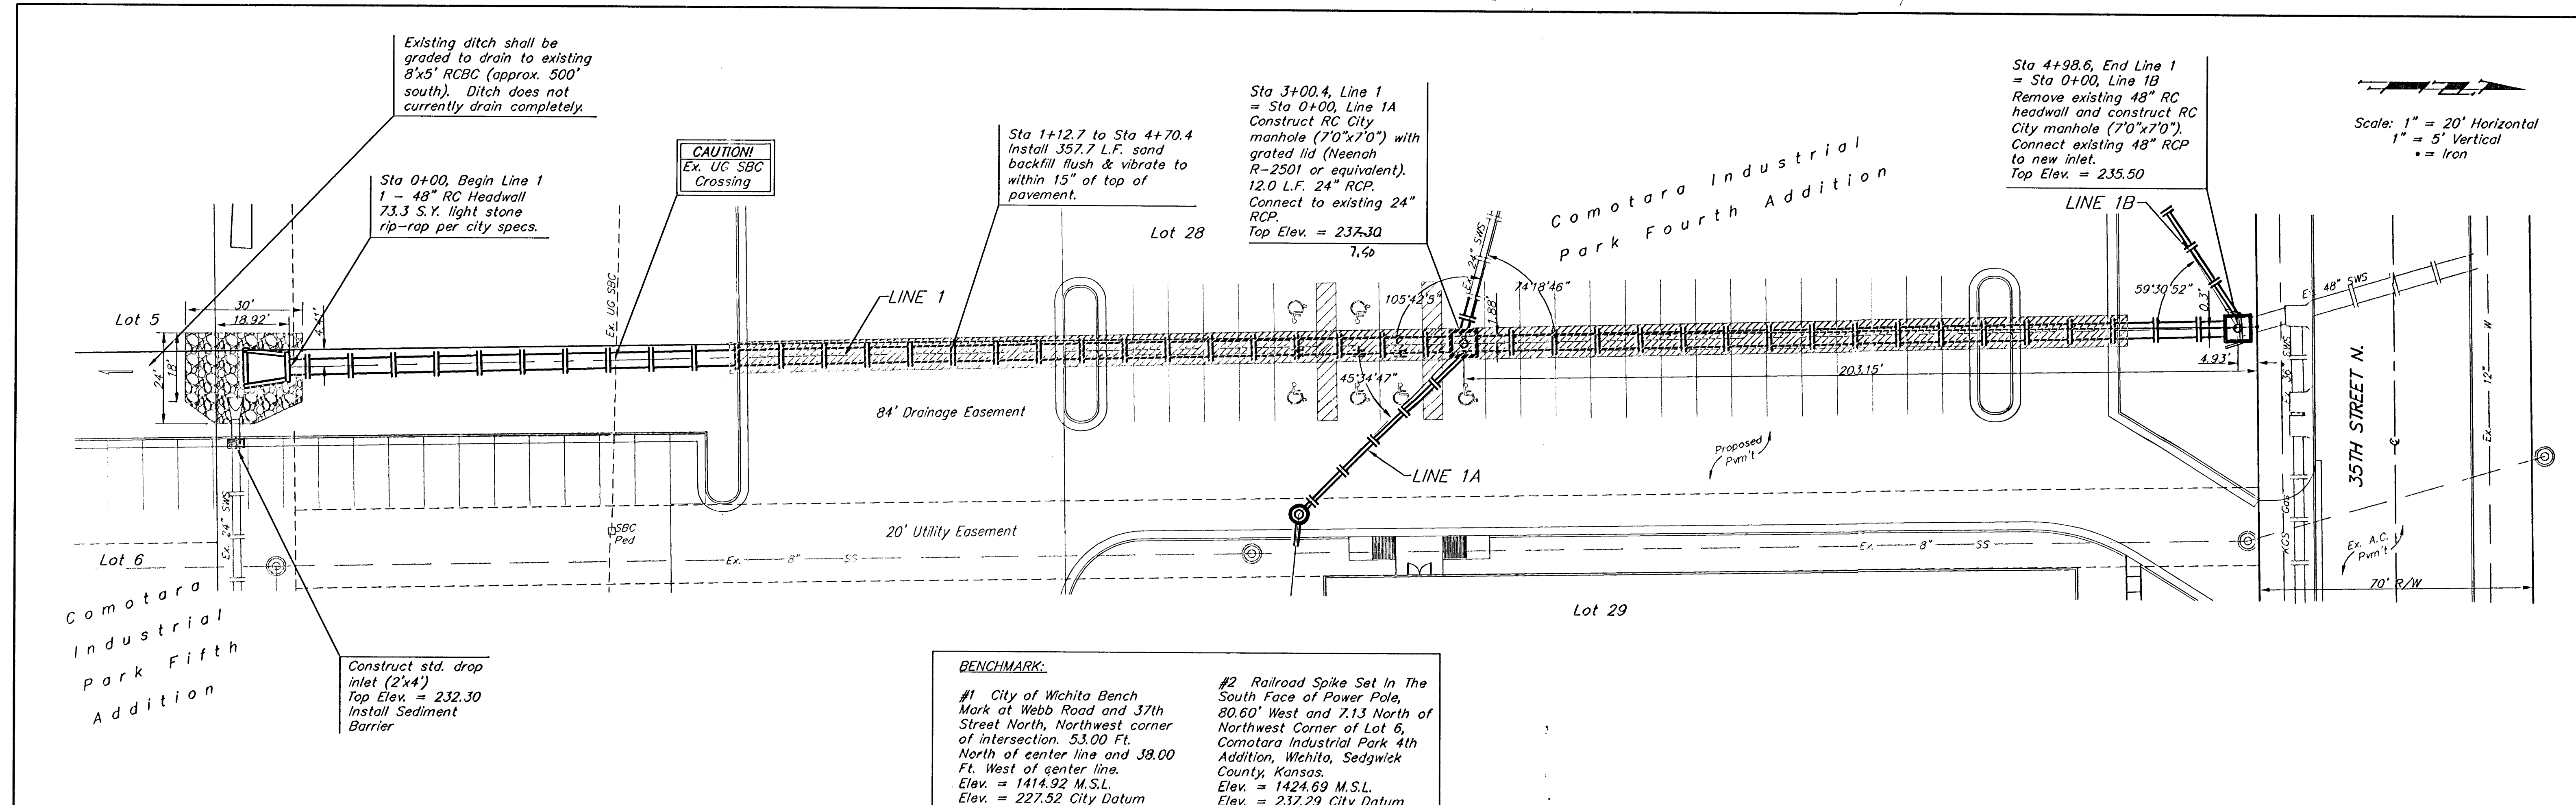

MICHAELIS WAREHOUSE

LINE 1

STORM WATER SEWER IMPROVEMENTS

Baughman Company, P.A. 315 Ellis St. Wichita, KS 67211 P 3162627271 F 3162621049	
ENGINEERING SURVEYING PLANNING LANDSCAPE ARCHITECTURE	
PROJECT NUMBER 1701 FPS (607861)	DRAWN LU
REVISIONS	APPROVED LU
	DATE 09/06
	SCALE Noted
	SHEET
2 OF 10	
Comotara-Michaelis Warehouse SWS1	
05-12-E431	