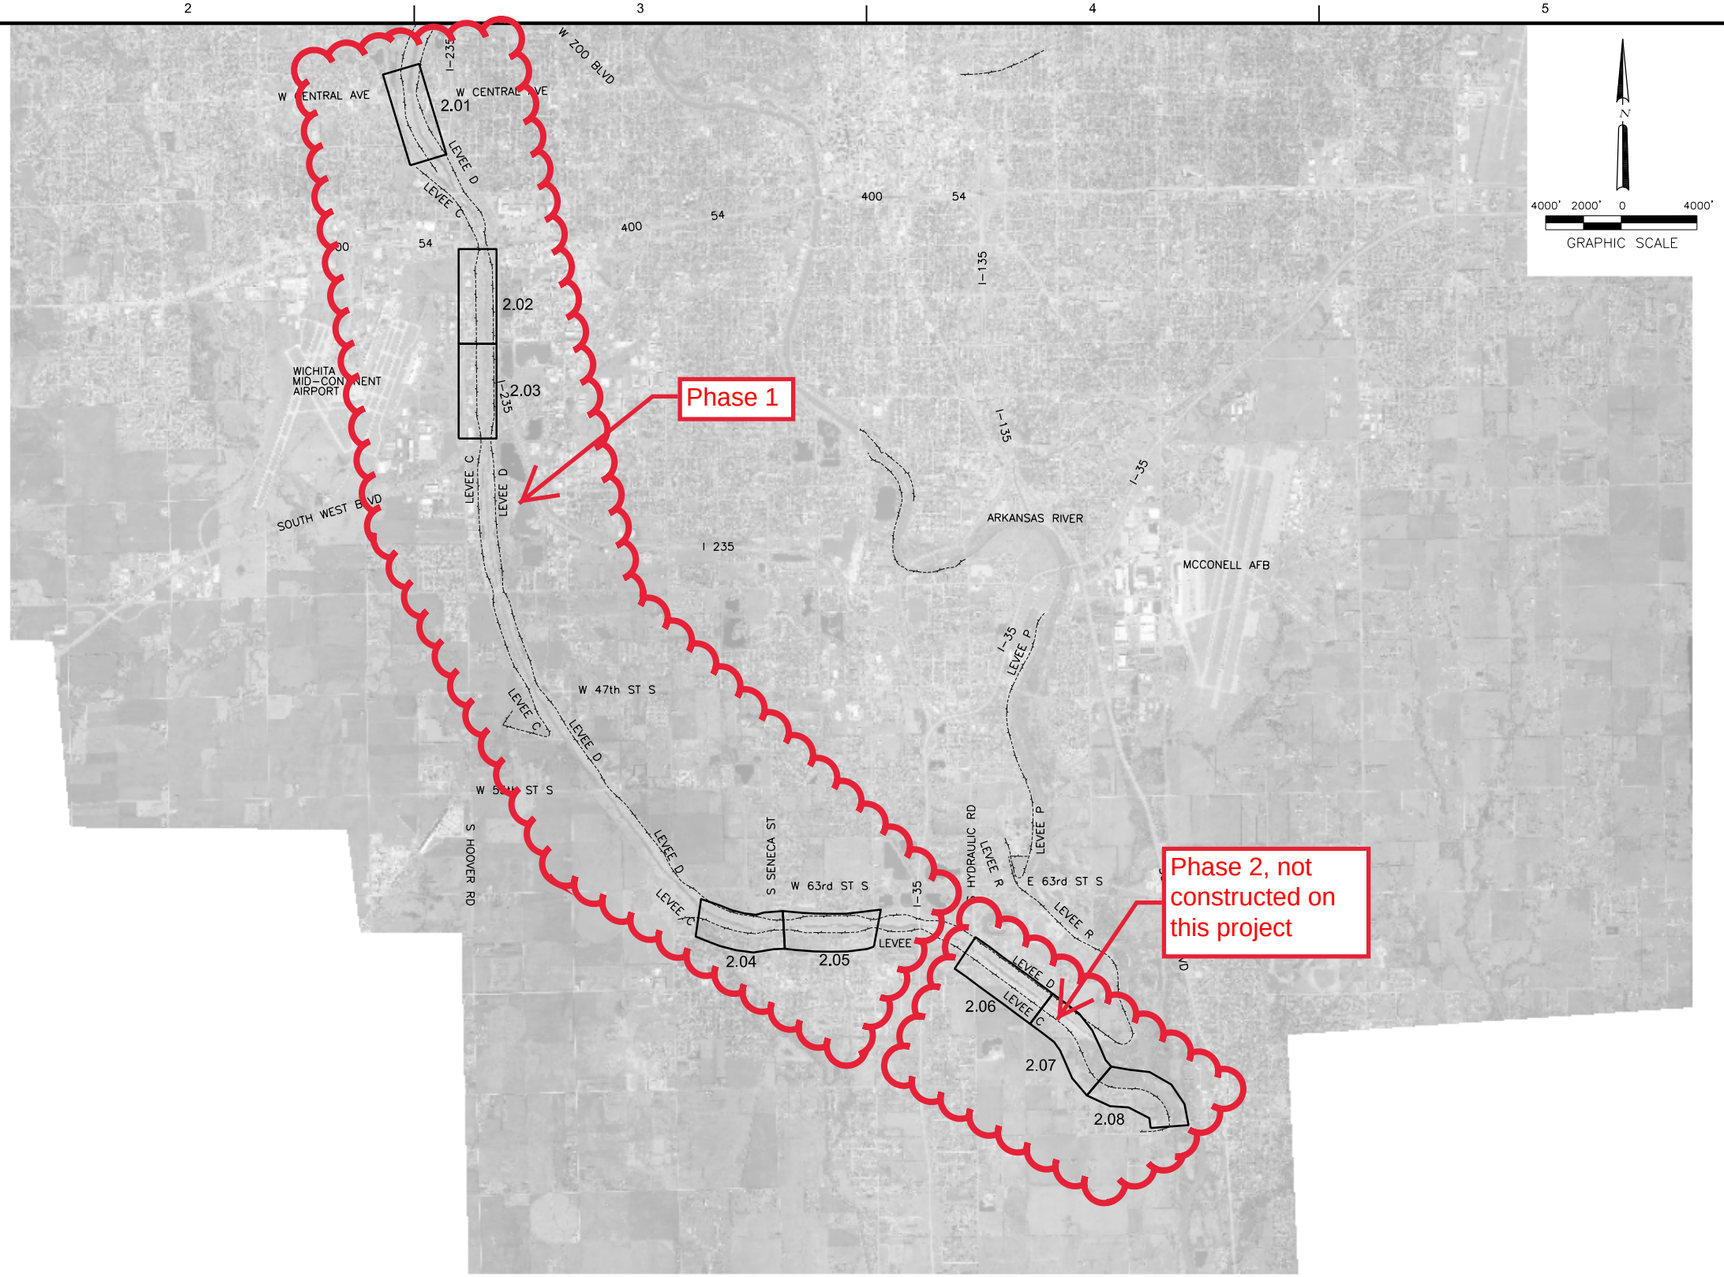

MARK	DESCRIPTION	DATE	APPR.

amec
AMEC Earth & Environmental, Inc.
1129 SW Wanamaker
Topeka, Kansas 66604
Phone: (785) 272-4600
Fax: (785) 272-4678

CITY OF WICHITA

LOWER LEVEE "C" TOE DRAIN REPLACEMENT
WICHITA-VALLEY CENTER LOCAL FLOOD PROTECTION PROJECT
WICHITA, KANSAS

PREPARED FOR
THE CITY OF WICHITA, KANSAS
455 N. Main
Wichita, KS 67202

LAWRENCE J. SAMPLE LICENSED 15855 8/13/12 KANSAS PROFESSIONAL ENGINEER

DESIGNED BY:		DATE:
Larry Sample, PE		08-13-2012
DWN BY: RES	CKD BY: LBK	APP BY: L. SAMPLE
FILE NAME: 08_KEY PLAN.dgn		
AMEC PROJ. NO. 5-6150-0001		

PARTIAL KEY PLAN

C-1.01

SHEET 6 OF 19