PROJECT NO.	SHEET NO.	TOTAL SHEETS
472-83376	29	50

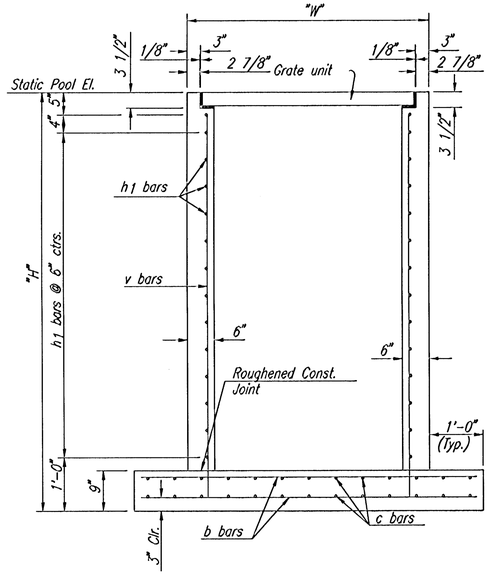

SECTION A-A

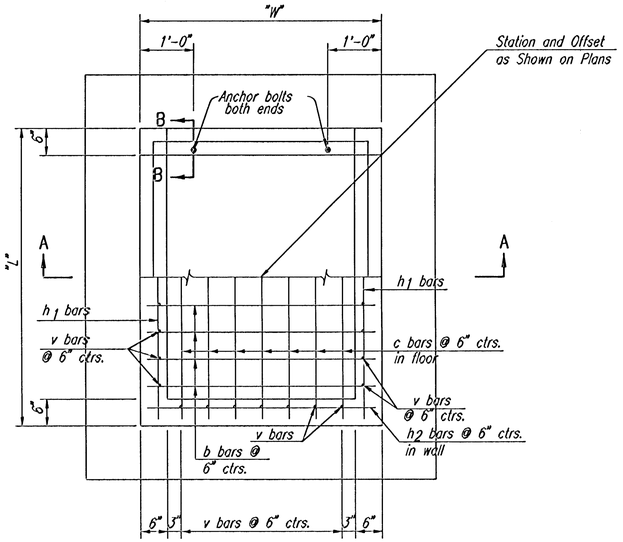

PLAN/SECTION

AREA INLET

See Plan Sheet for Inlet orientation.

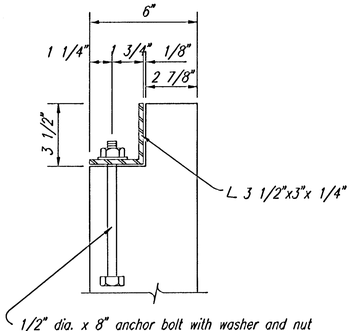

SECTION B-B

Note: Anchor bolts are subsidiary to the bid item "Inlet Type C".

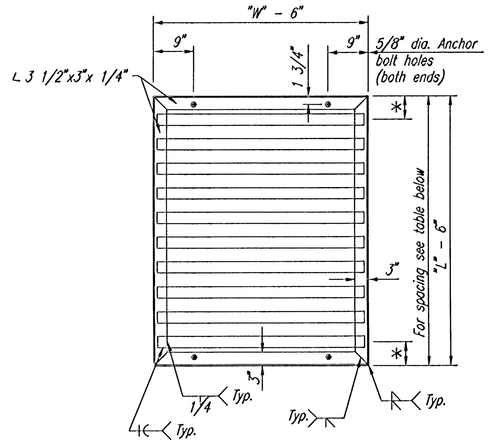

GRATE UNIT DETAILS

BILL OF MATERIALS

"L" 6'-0"	"W" x 5'-0"	"H" x 6'-6"	(117)
Bar	No.	Size	Length
v	36	#4	5'-9"
c	28	#4	7'-9"
b	32	#4	6'-9"
h1	22	#4	5'-9"
h2	22	#4	4'-9"
Class "A" Conc.		3.63	Cu.Yd.
Reinf. steel		582.0	Lbs.
Struct. steel		380.0	Lbs.
Class III Excavation		21.67	Cu.Yd.

Quantities are for information only.

PIPE DIMENSIONS AND SPACING

Location	L x W	No. of Pipes	Dia. x Length x Spacing	*
(117)	6'-0"x5'-0"	11	2 1/2 ϕ x 4'-4 1/4" pipes @ 5 1/2" ctrs.	5 1/2"

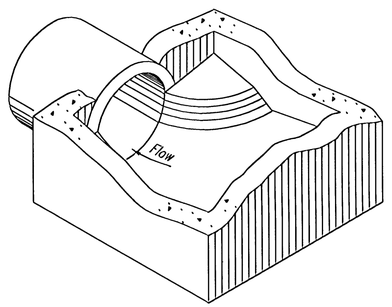

Floor of inlet or manhole shall be shaped as shown to increase hydraulic efficiency.

ISOMETRIC VIEW

GENERAL NOTES

Concrete shall be as per City of Wichita Standard Specifications for Concrete Paving Mix. Except that it shall have a minimum 28 day compressive strength of 4,000 p.s.i. All Pipes shall be flush cut prior to being cast into the Inlet.

All dimensions relative to Reinforcing Steel are to centerline of bar unless otherwise noted. All Reinforcing Steel shall conform to A.S.T.M. Designation A615 Grade 60 and shall be Epoxy Coated.

All exposed edges shall be finished with an edging tool.

All external pipe to inlet joints shall be coated with an asphaltic tar to waterproof the joint interface.

Where possible bend bars around pipes.

Floor of inlet shall be shaped as shown. Concrete used for shaping shall be unreinforced concrete pavement mix. No addition in concrete quantities shall be made for shaping floor of inlet.

No deductions in concrete quantities shall be made for pipe openings.

All bars are #4 @ 6" spacing and shall have a minimum clearance of 1 1/2 " unless otherwise noted on the plans.

The top of the inlet shall be set level.

The grate shall be fabricated from standard or commercial grade structural steel and black steel pipe. The unit shall be hot dipped, galvanized after fabrication, in accordance with ASTM A123 except the weight of coating shall average not less than 2.0 ounces per square foot of actual surface and no individual test shall show less than 1.8 ounces of coating per square foot of actual surface area.

RECORD DRAWING
Darby Eshelman
24 NOV 03

Note: Inlet modified from KDOT Std. No. 648

REMINGTON PLACE - PHASE 2

TYPE C INLET DETAILS

Professional Engineering Consultants, P.A.
303 S. TOPEKA • WICHITA, KANSAS 67202
316-262-2691 • FAX 316-262-3003

Designed by	BER	Checked by		
Drawn by	DEP	Date	DEC., 2002	Job No. 02398

DSNR: SAD OPER: DEP SCALE: 1=1.00
C:\2002\02398\000\AREAINLT 12-03-2002 02:59:23 pm