PROJECT NO.	SHEET NO.	TOTAL SHEETS
472-83376	48	50

NOTE BOOK
TEMPLATE
LABORATORY
NO.
AREAS CHECKED

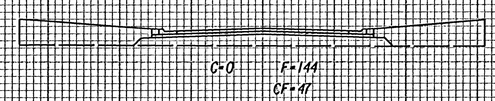

48+66.31

48+66.31

RECORD DRAWING
24 MAR 03

CHURCHILL
STA. 48+66.31

SCALE 1" = 10' VERT.
1" = 10' HORIZ