WOODLAND LAKES ESTATES
THIRD ADD. - ZELTA PHASE
PROJ. NO. 468-83593

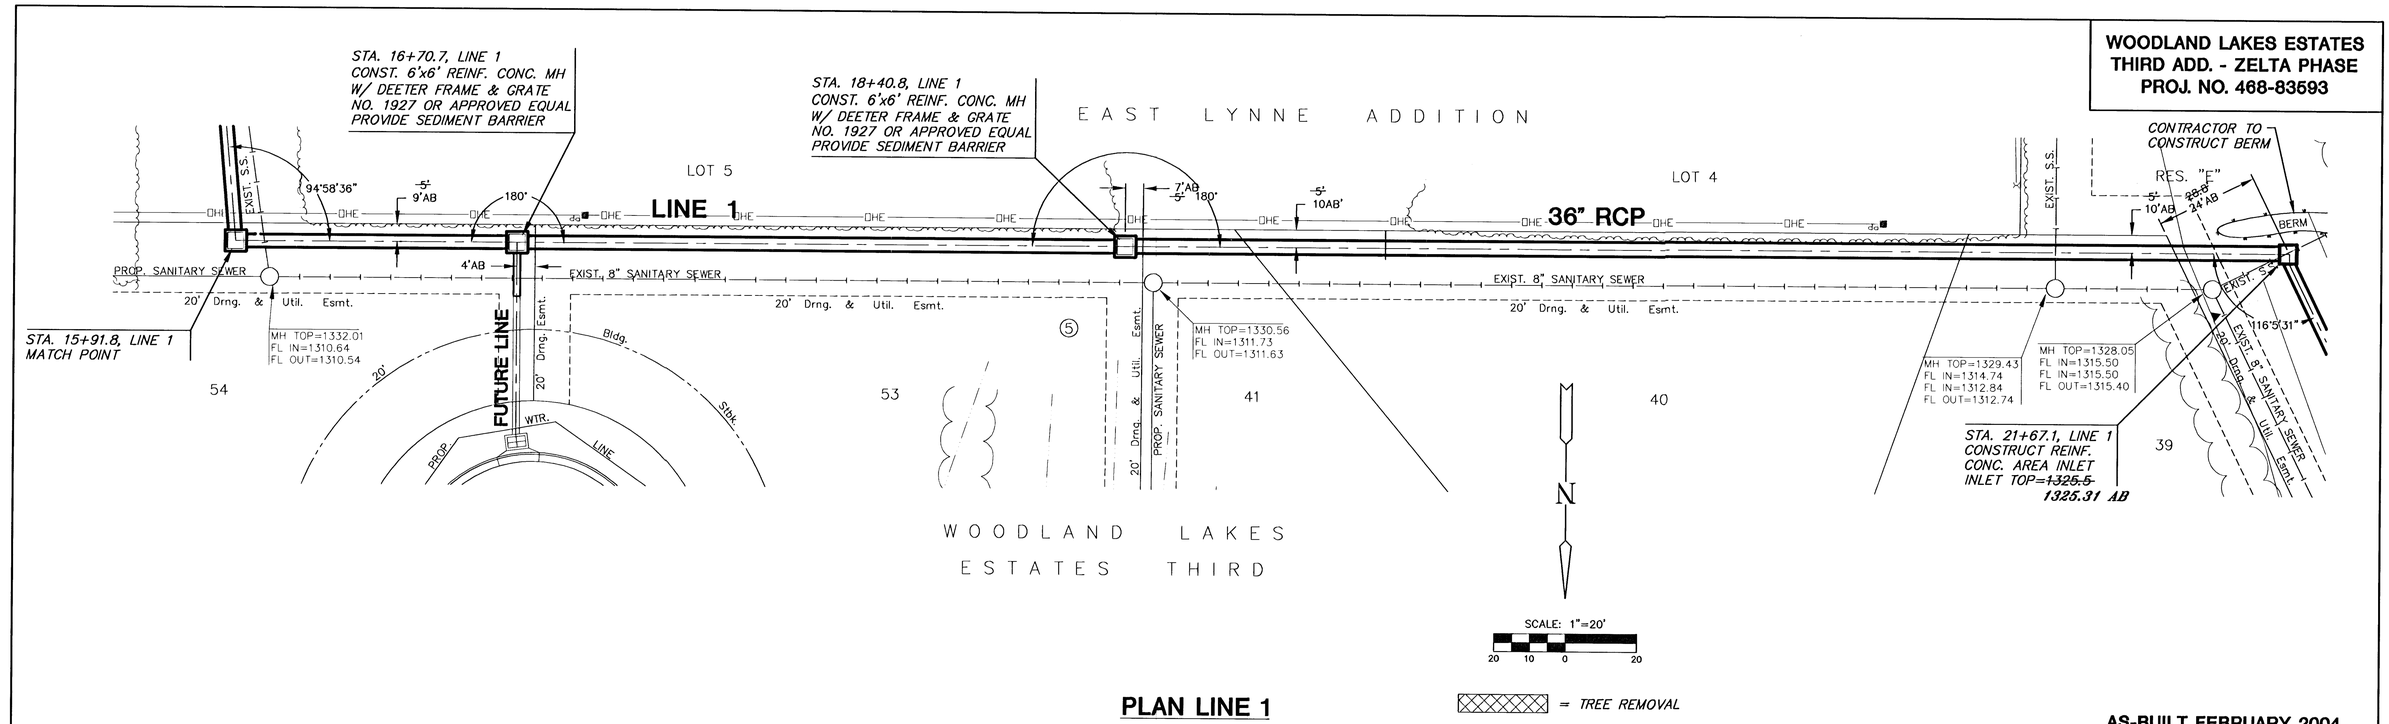

PLAN LINE 1

= TREE REMOVAL

AS-BUILT FEBRUARY 2004

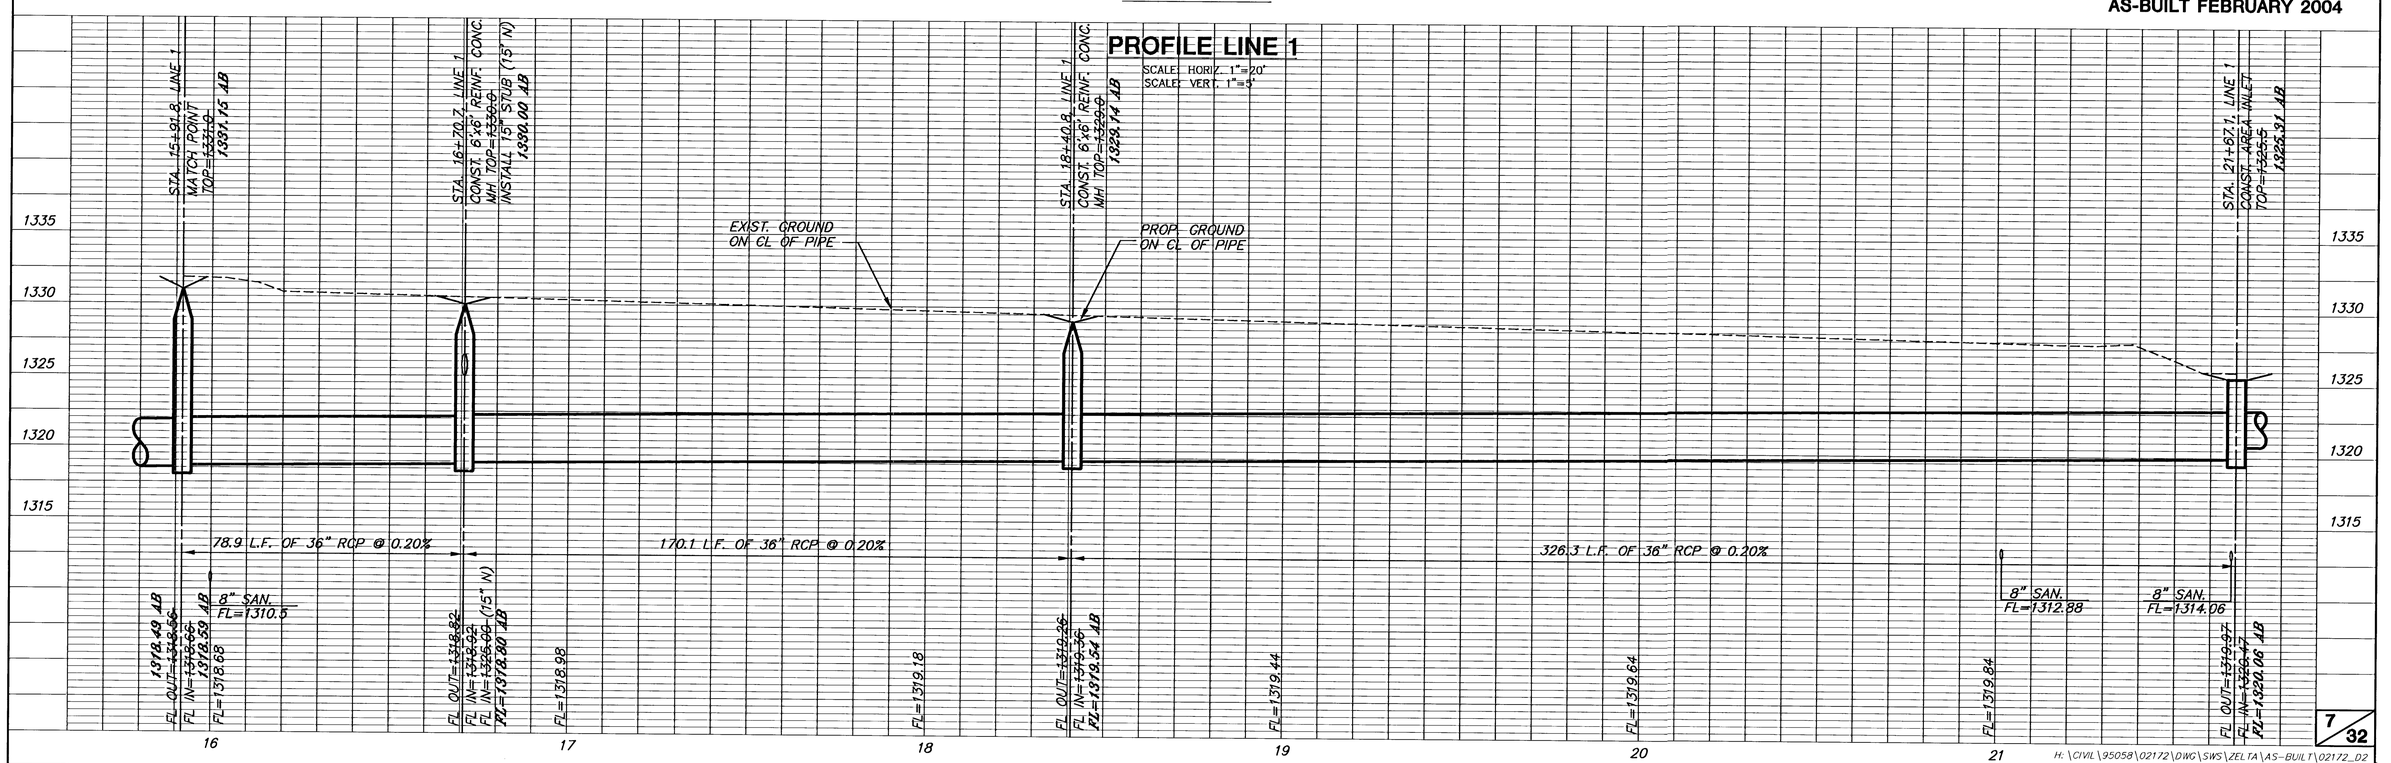

H:\CIVIL\95058\02172\DWG\SWS\ZELTA\AS-BUILT\02172_D2