WOODLAND LAKES ESTATES THIRD ADD. - ZELTA PHASE
PROJ. NO. 468-83593

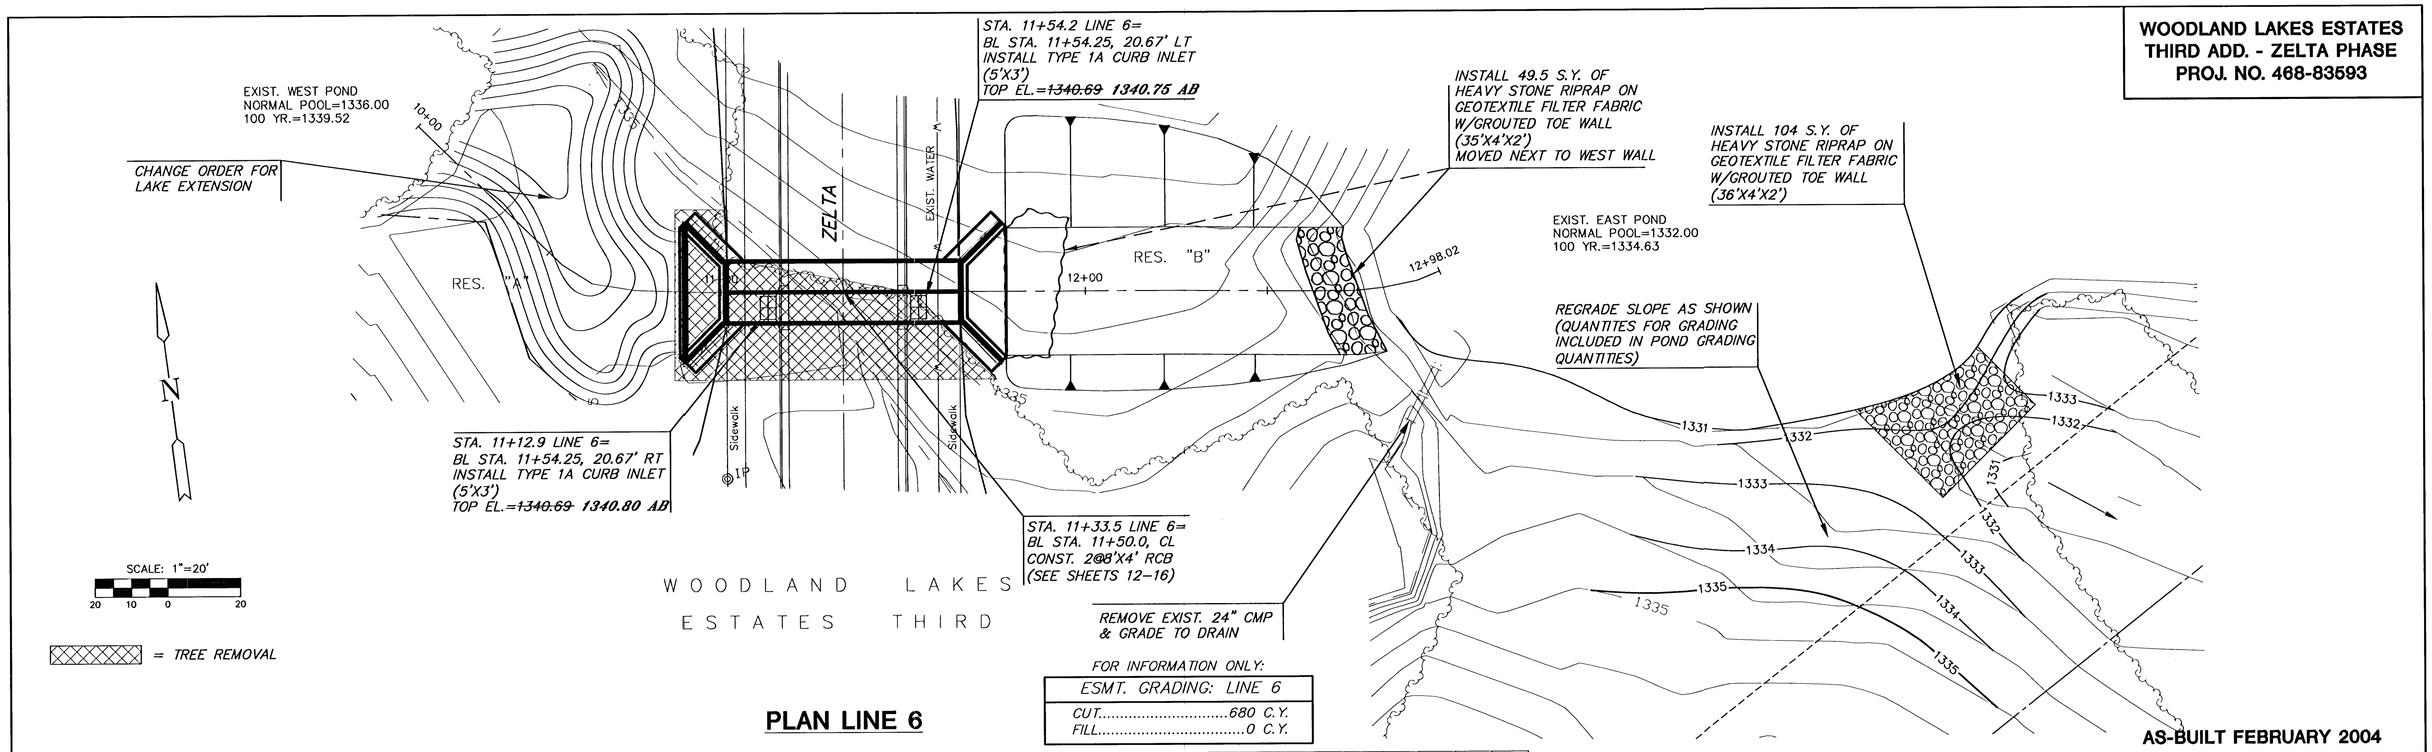

PLAN LINE 6

AS-BUILT FEBRUARY 2004

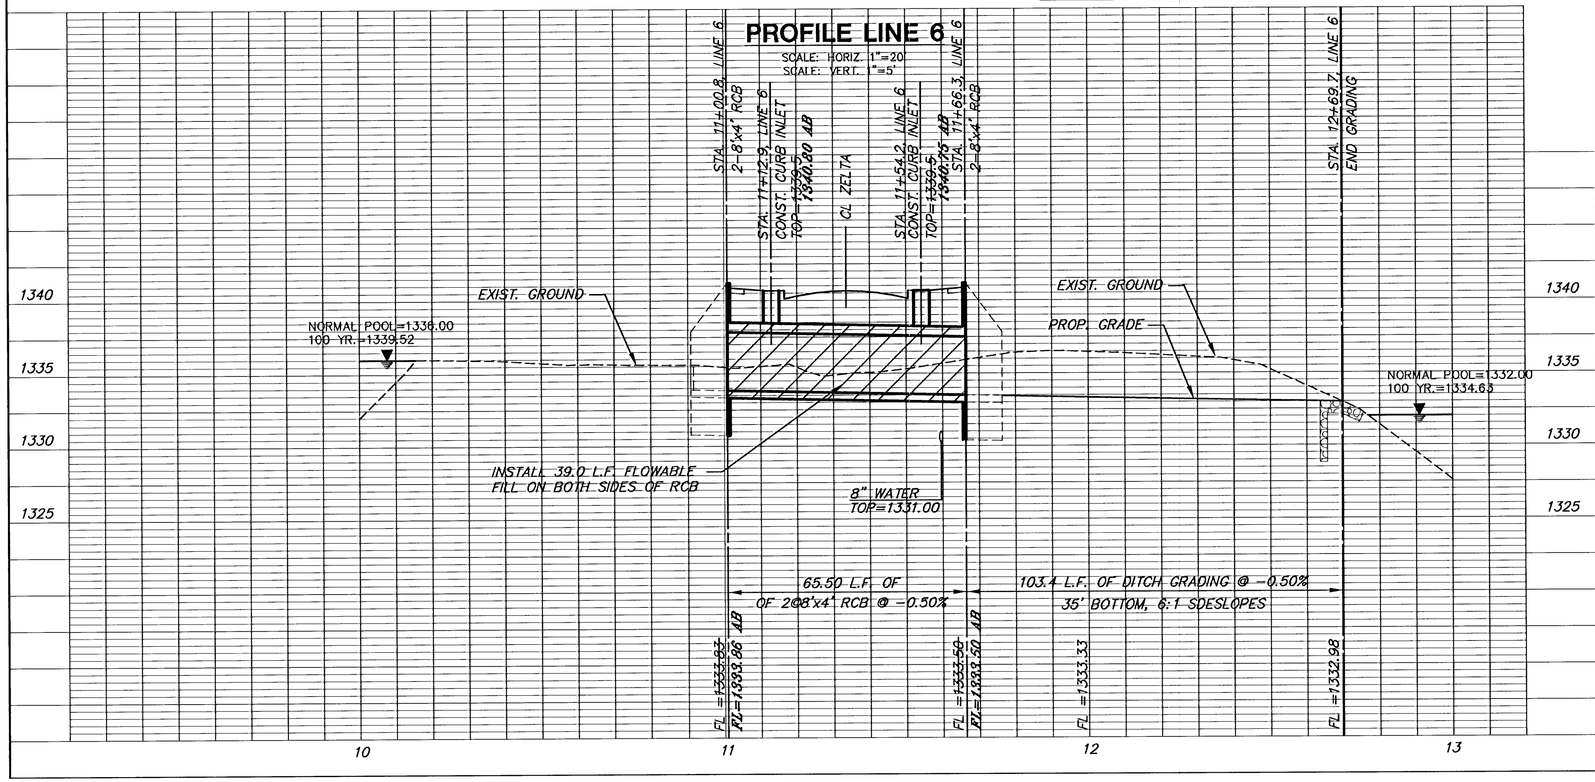

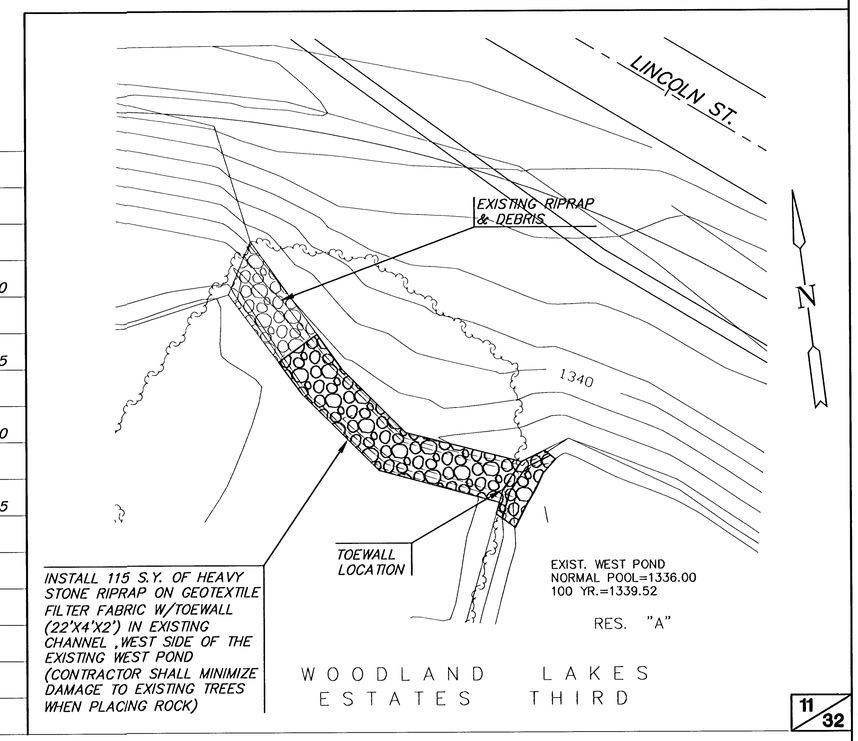

H:\CIVIL\95058\02172\DWG\SWS\ZELTA\AS-BUILT\02172_D6