


PLAN LINE 2

SCALE: 1"=40'


REVIS: 1-12-04
Due to gas line location

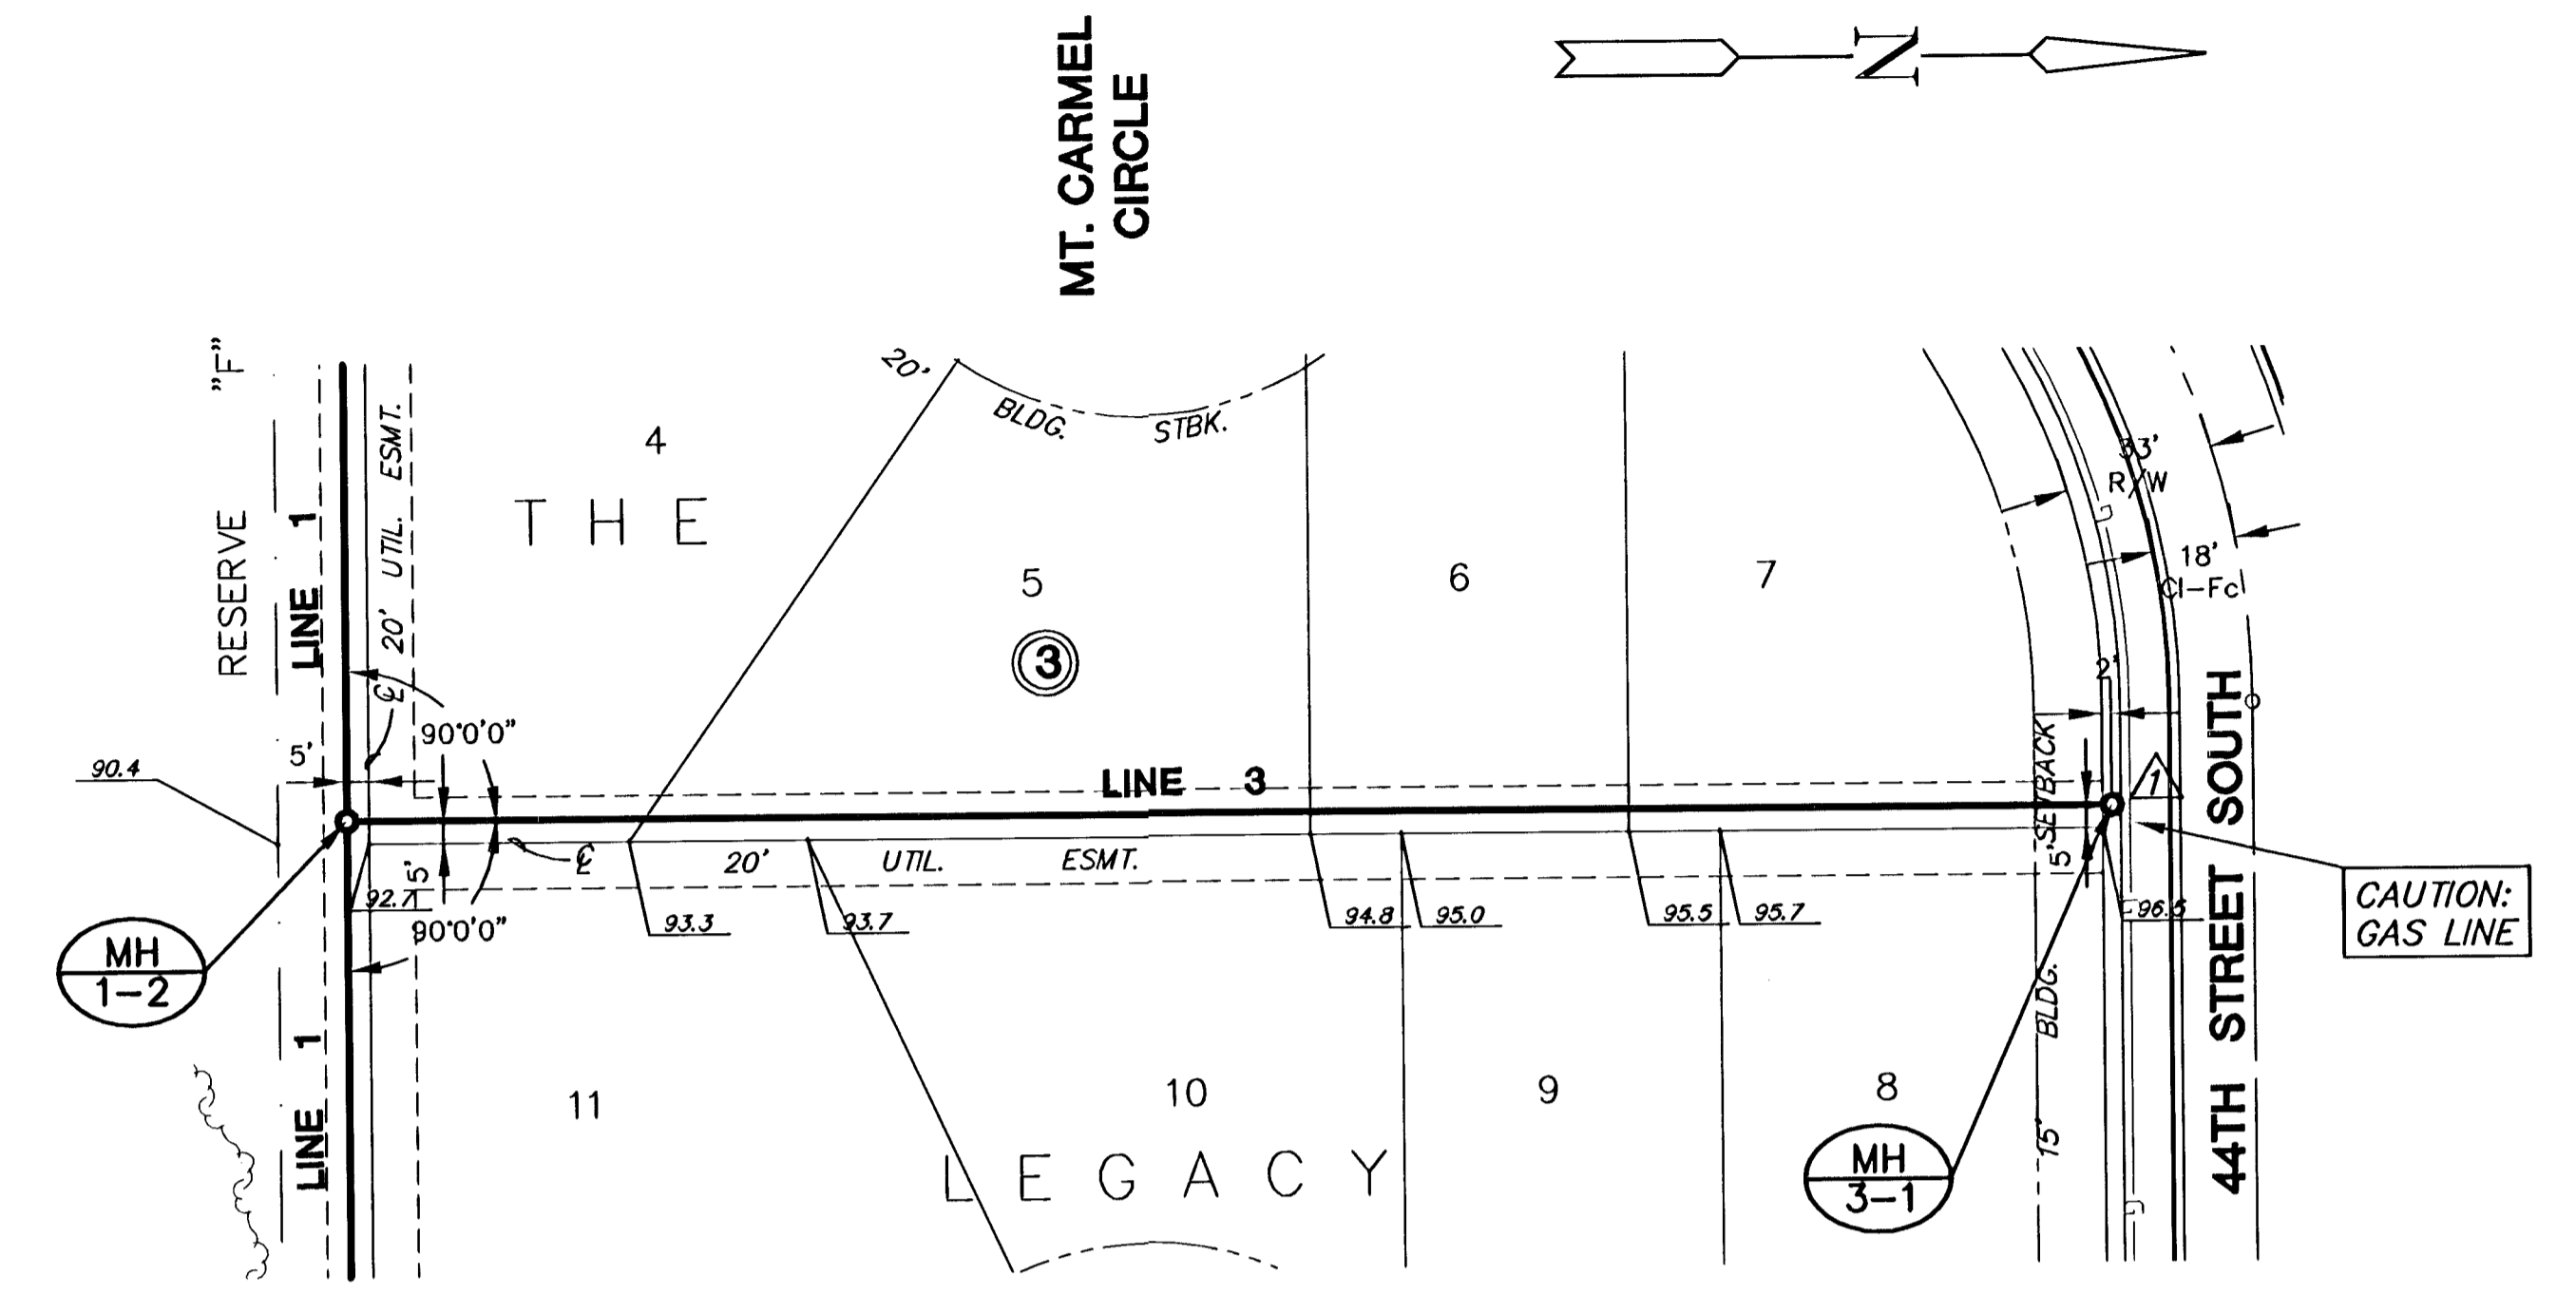

PLAN LINE 3

SCALE: 1"=40'

REVIS: 1-12-04
Due to gas line location

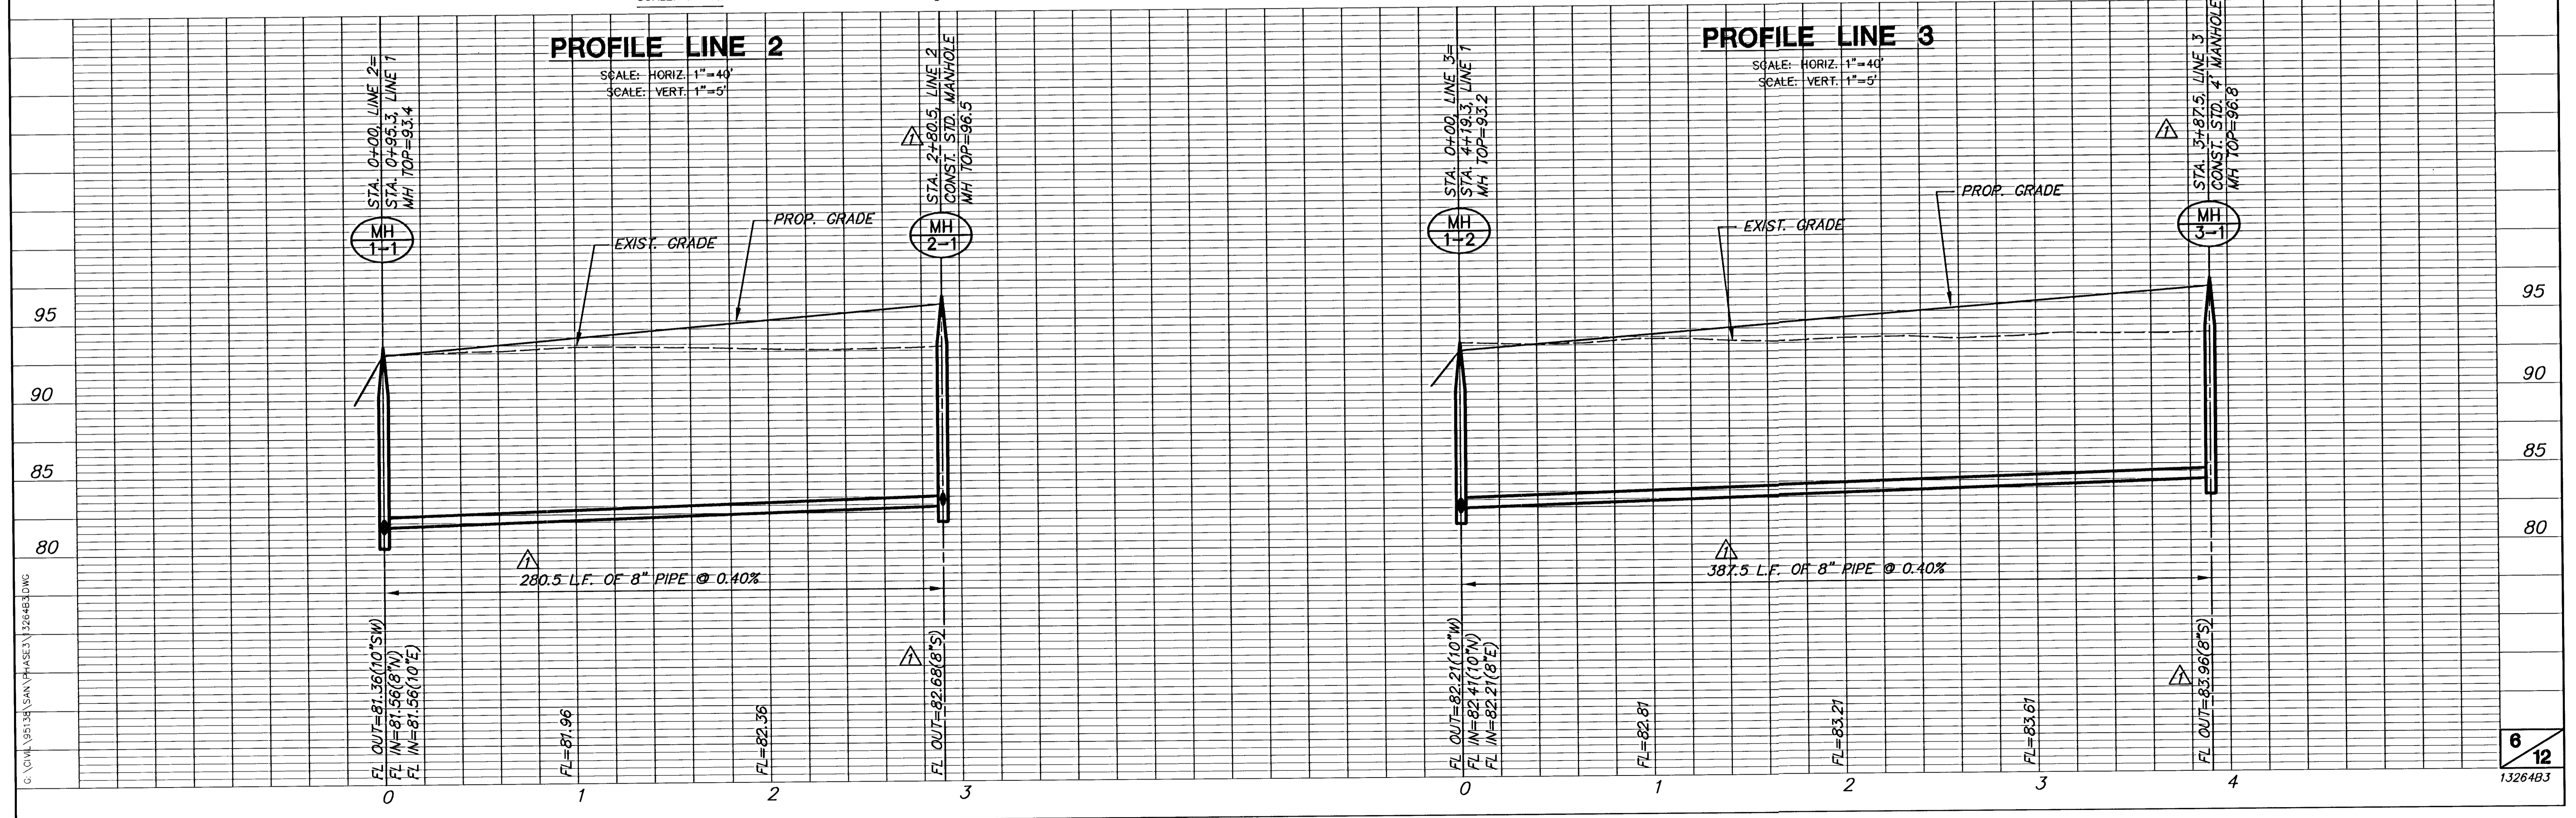

C:\DWG\05138\SAN\PHASE3\126483.DWG