

Mayfield
1st Add.

* Concrete Header

Roll Type Monolithic
Edge Curb

* HANDFORMED Roll Type Curb & Gutter

Roll Type Combine
Curb & Gutter.

Private Drive

Asphalt Pavt.
By Others

8" Conc. Drive
Pavement

Roll Type Monolithic
Edge Curb

* Concrete Header

* Changes approved by Vicki Huang

Lot 1

1

57.00
50' R/W

52.00

40' Bk-Bk

35' R/W

1/2 IP

8" A.C. Water Main

9+00

10+00

May St.

Ex. Asphalt
Pavt.

4' Bk-Bk

69.94' M

1/2 IP

35' R/W

50' R/W

57.00

8" Conc. Drive
Pavement

35' Drng. Esmt.


WL By Others

Drainage Ditch

Benchmark:
BM 1 Temporary bench mark.
SE corner of intersection of West St.
and May St. Box cut in NE corner of
concrete base of sign "May Central Park"
Elev.=111.67

BM 2 COW Bench mark. NW
corner of intersection of West St.
and May St.. 65' W of centerline
of West St. 50' N of centerline of
May. 28.8' N of center of median.
14.4' W of west face of sidewalk.
2.5' N of back of curb. 2.2' W of
west face of SWS inlet.
Elev.=108.63

Baseline:
10+00 at the Property
Corner of Tracy and May.

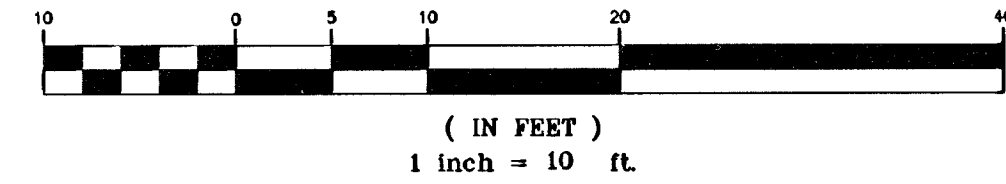

Street Improvements May Street Wichita, KS				
PROJECT NUMBER				
kemiller engineering	KEM NO. 05159	FILE paving	DATE 10/2006	SHEET 2
	DESIGN KM	DRAWN JO	REVISED	OF 5

516 S. Market,
Wichita, KS 67202

316/264-0242