
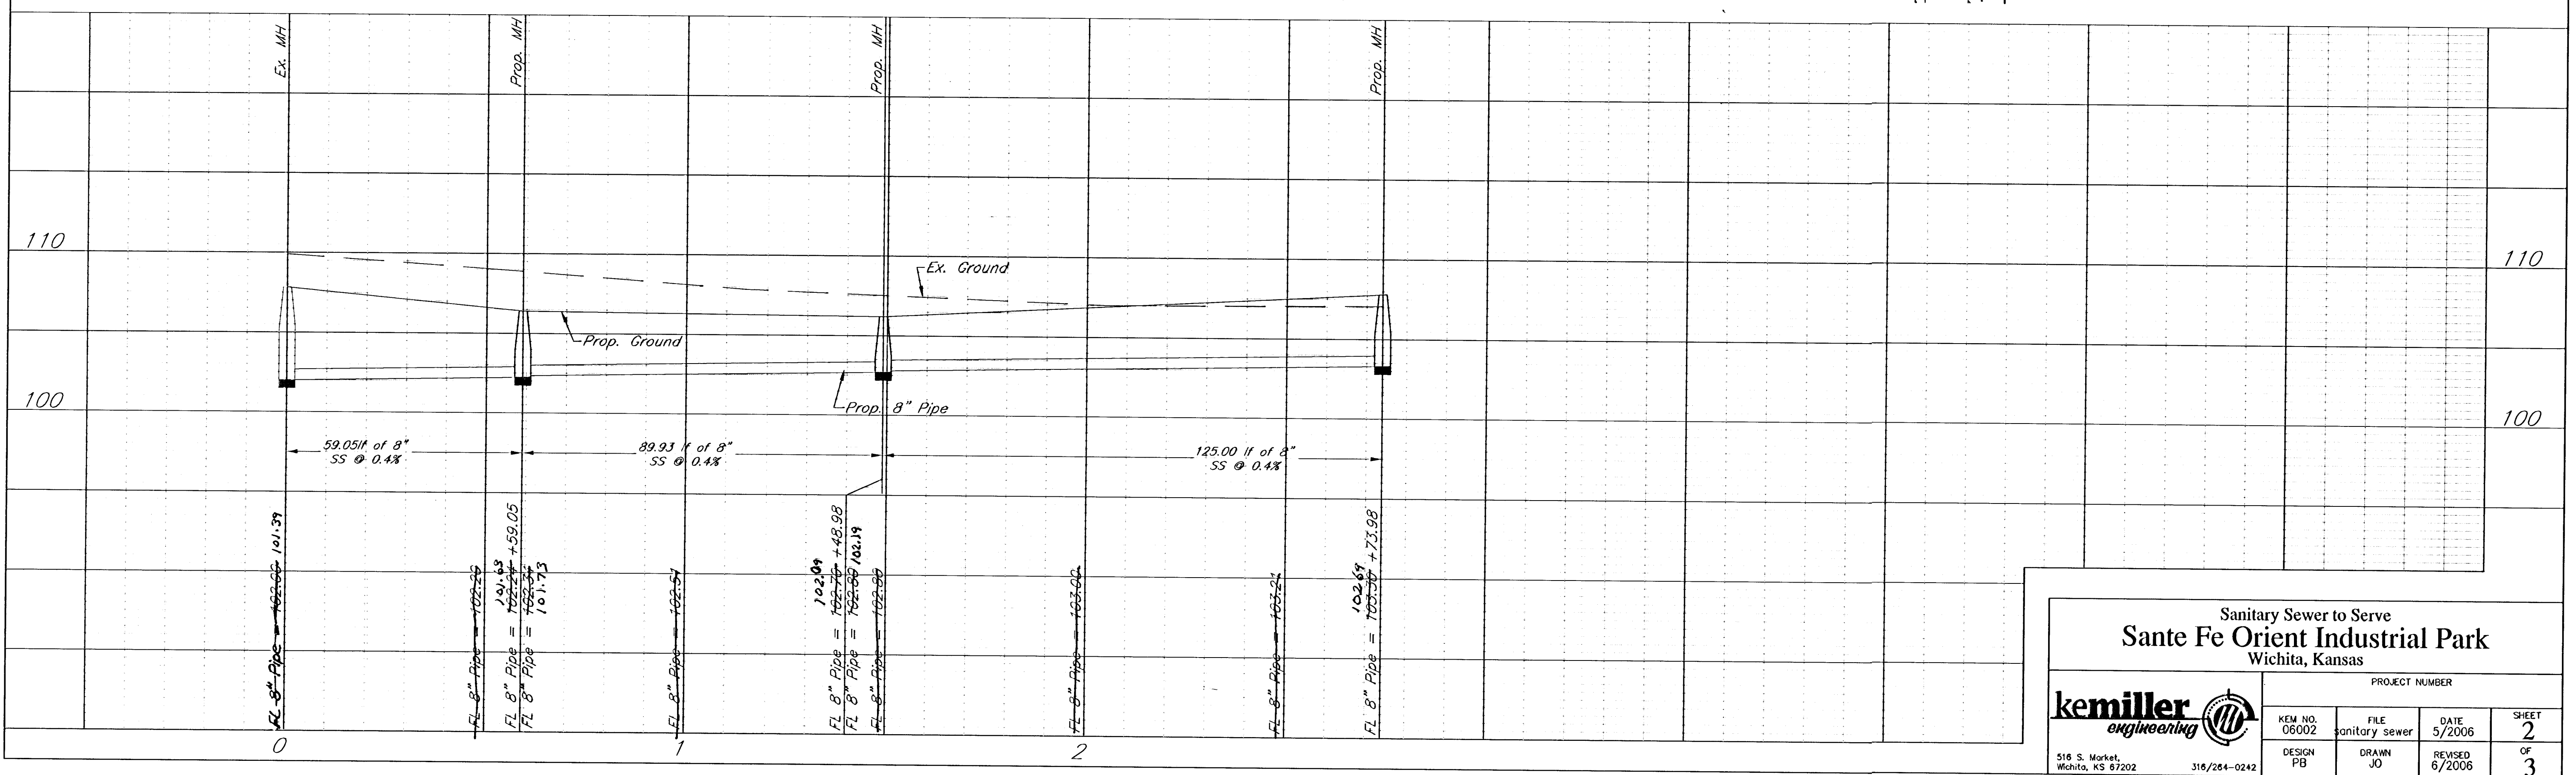
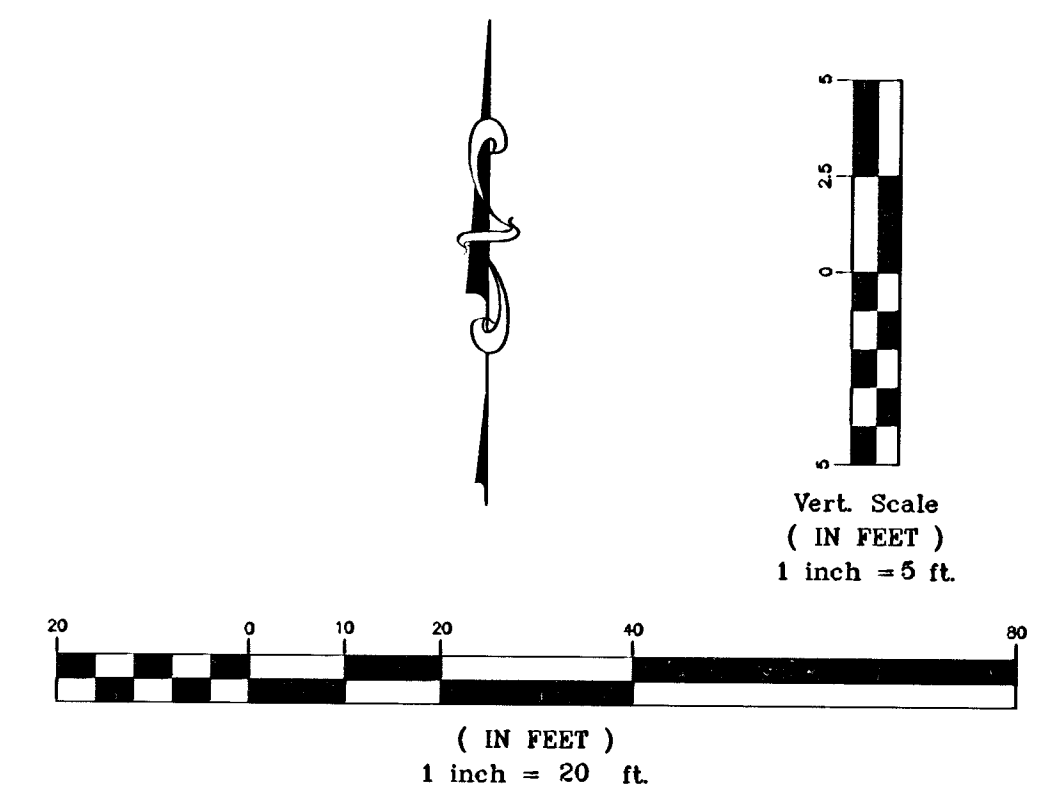


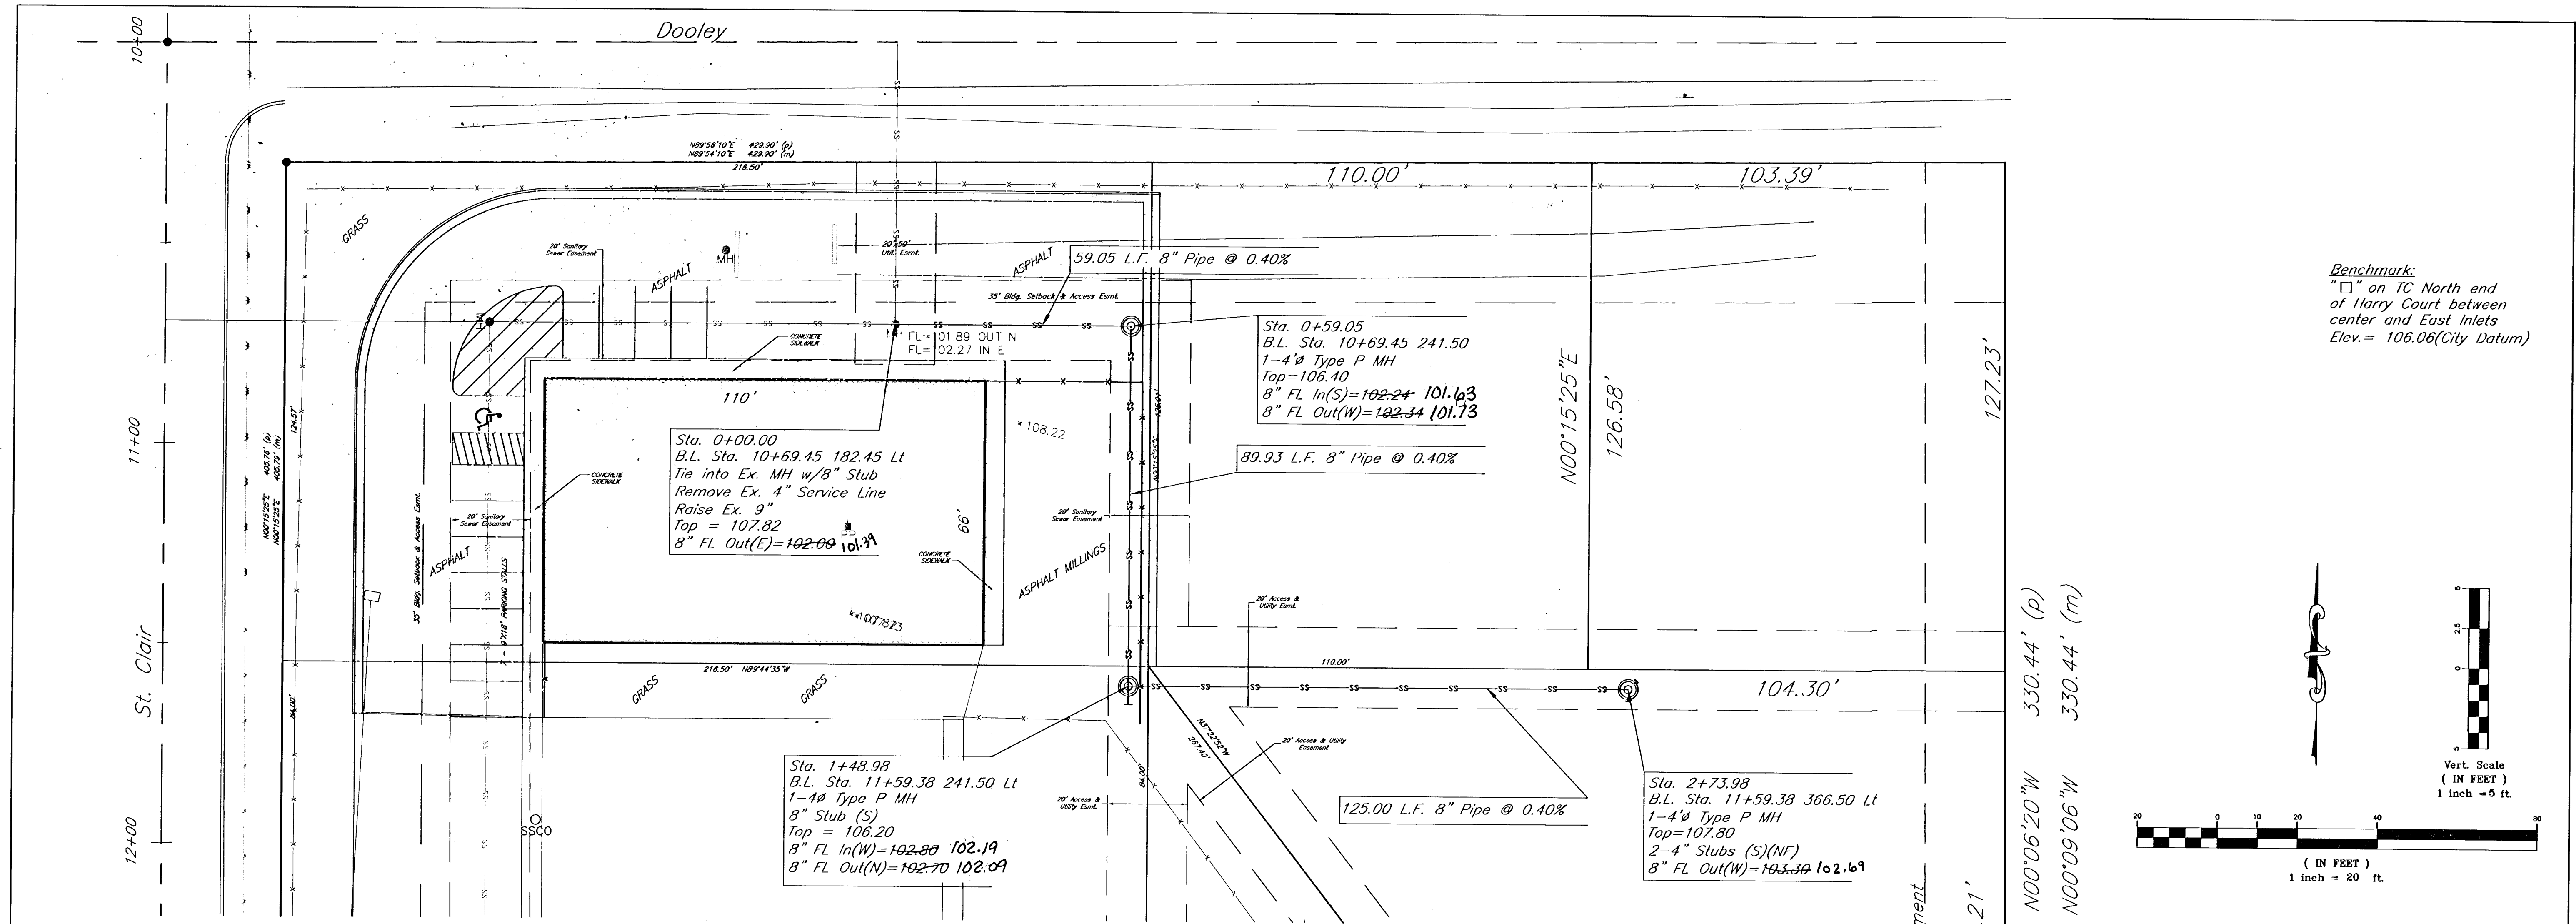

Sanitary Sewer to Serve Sante Fe Orient Industrial Park Wichita, Kansas				
PROJECT NUMBER				
kemiller engineering	KEM NO.	FILE	DATE	SHEET
	06002	Sanitary sewer	5/2006	2
DESIGN	PB	DRAWN	JO	REVISED
				6/2006
				OF
				3

516 S. Market, Wichita, KS 67202 316/264-0242