


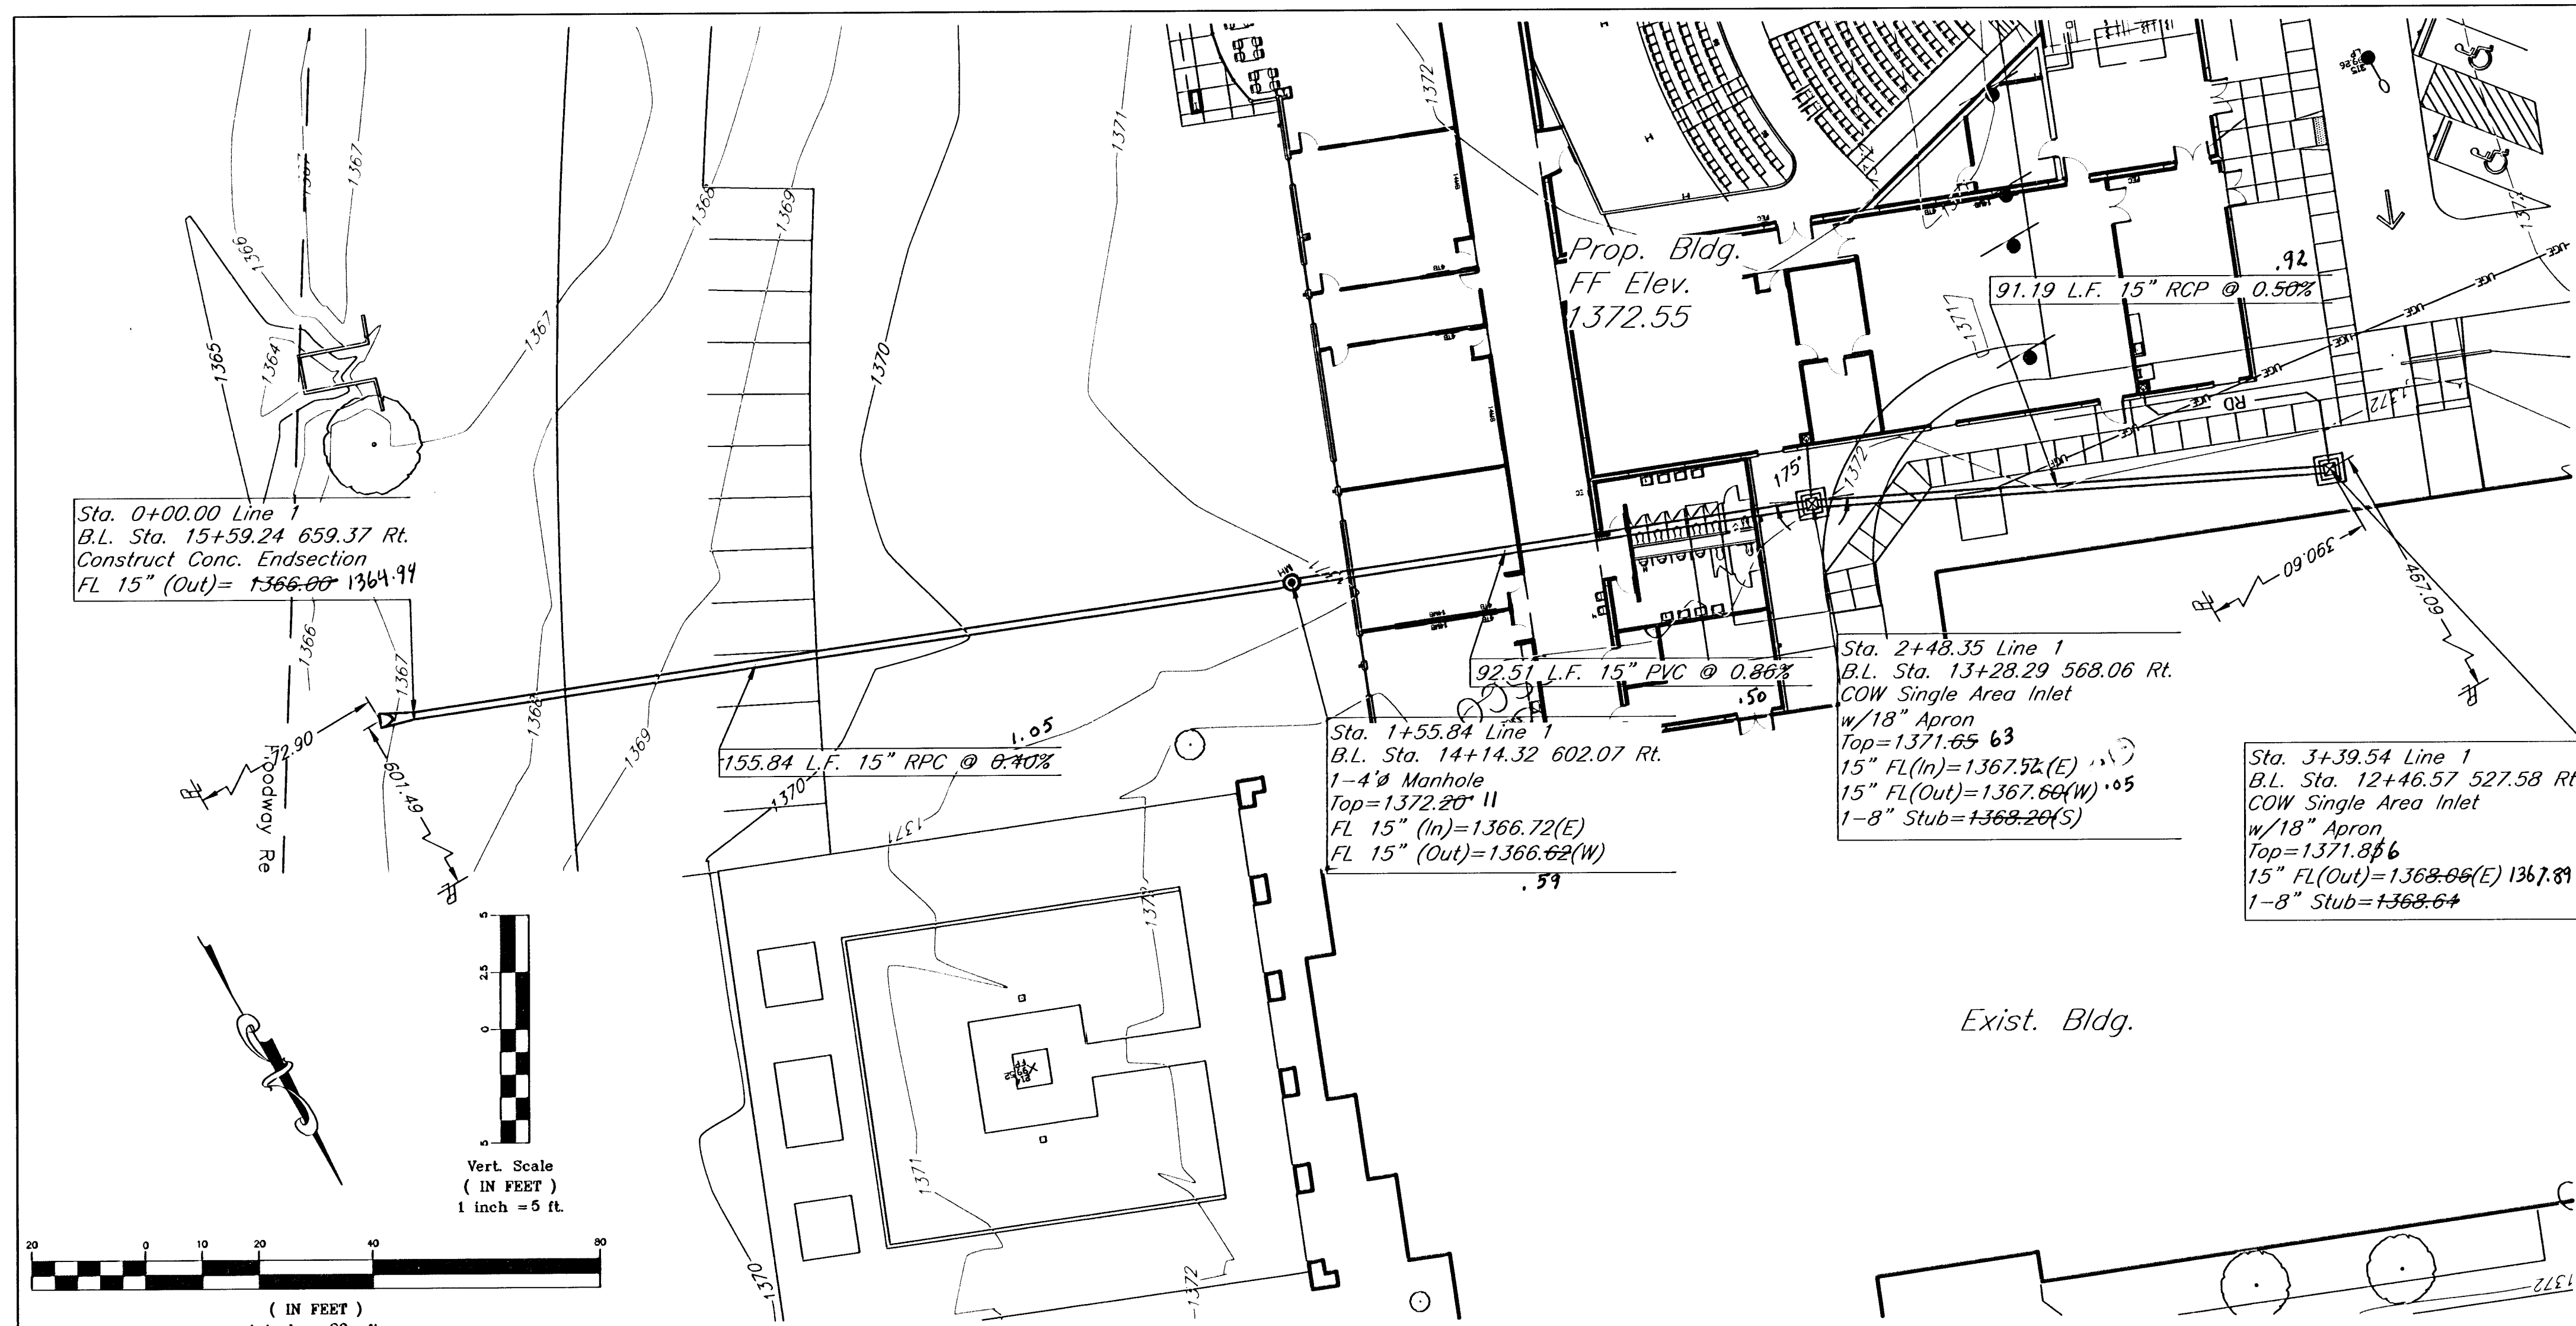

Benchmark:
□ on west edge of median at intersection of Collective and Founders.
Elev. = 188.97 (Cow Datum)
= 1376.37 (MSL)

Baseline
Centerline of 21st. St. N w/10+00 being the Intersection of 21st St. North and Founders Rd.

Sta. 0+00.00 Line 2
B.L. Sta. 13+95.99 830.10 Rt.
Construct Conc. Endsection
FL 18" (Out)=1366.40

44.16 L.F. 18" RCP @ 0.50%

Sta. 0+44.16 Line 2
B.L. Sta. 13+74.74 806.17 Rt.
Construct Conc. Endsection
FL 18" (Out)=1366.60

