


PLAN	CHECKED	DATE

PROFILE	CHECKED	DATE

Saved: 10-03-2006 8:57:00 AM by JAW
 C:\Users\jawa\Documents\Projects\Sanitary Sewer Line No. 4\SSSPP.dwg
 C:\Users\jawa\Documents\Projects\Sanitary Sewer Line No. 4\SSSPP.dwg

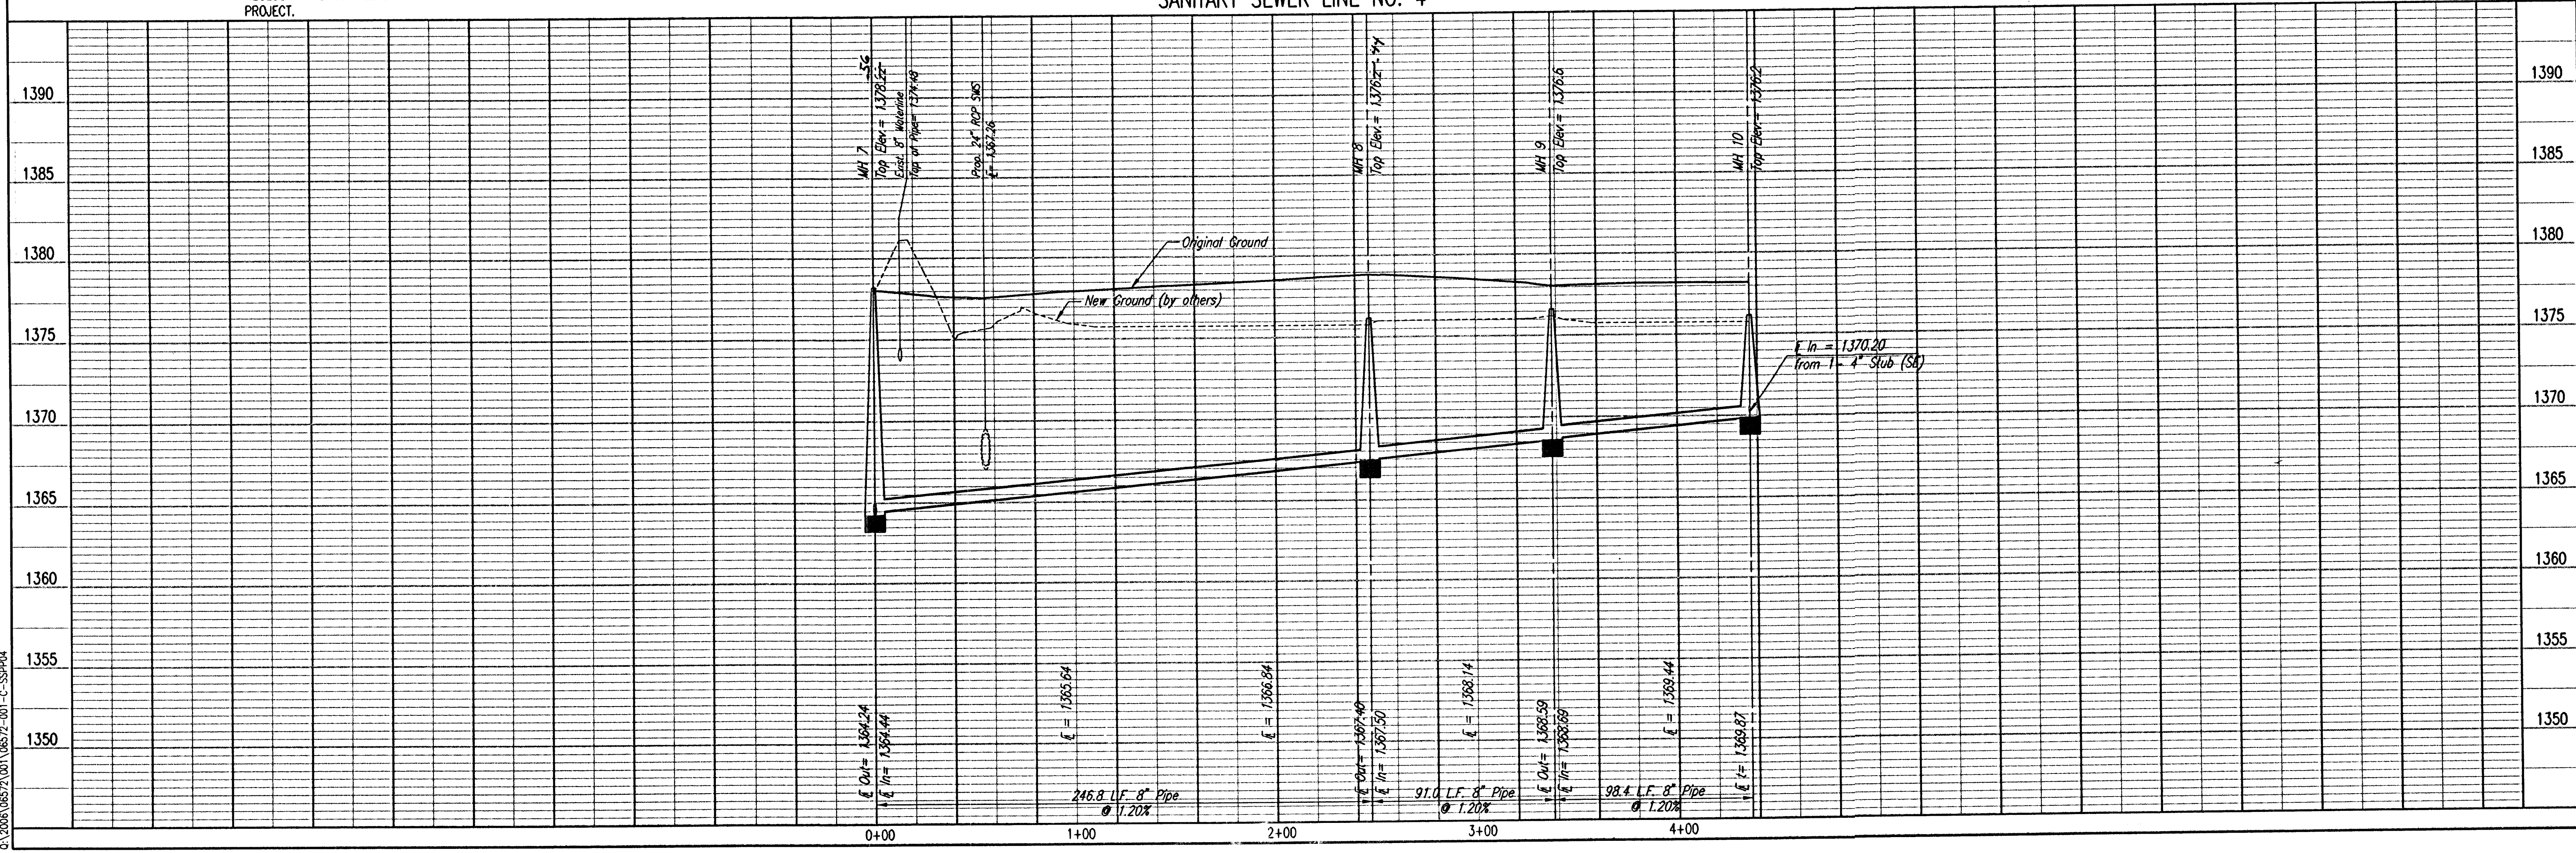

* PRIOR TO BEGINNING CONSTRUCTION, THE CONTRACTOR SHALL EXCAVATE THE EXISTING 8" PVC PIPE AT SANITARY SEWER STATION 0+00.0 TO VERIFY ITS HORIZONTAL AND VERTICAL LOCATION. THE PIPE LOCATION SHALL BE REPORTED TO THE ENGINEER SO THAT ANY NECESSARY PLAN MODIFICATIONS CAN BE MADE. ANY ADDITIONAL LABOR OR MATERIALS NECESSARY TO COMPLETE THE CONNECTION SHALL BE CONSIDERED SUBSIDIARY TO THE PROJECT.

N=386,628.6181, E=2,372,625.4127
 Sta. 0+00.0 *
 Construct MH 7 over existing 8" pipe. Remove top half of 8" pipe thru MH. Standard MH Shape invert to provide smooth flow.

CAUTION !!!
 8" Waterline
 (City of Wichita)


CAUTION !!!
 Proposed 24" RCP
 Storm Water Sewer
 (by others)

N=386,383.1427, E=2,372,600.2216
 Sta. 2+46.8
 Const. MH 8
 Standard MH

N=386,298.5893, E=2,372,633.7986
 Sta. 3+37.8
 Const. MH 9
 Standard MH

N=386,202.1636, E=2,372,614.0368
 Sta. 4+36.2
 Const. MH 10
 Standard MH

SANITARY SEWER LINE NO. 4

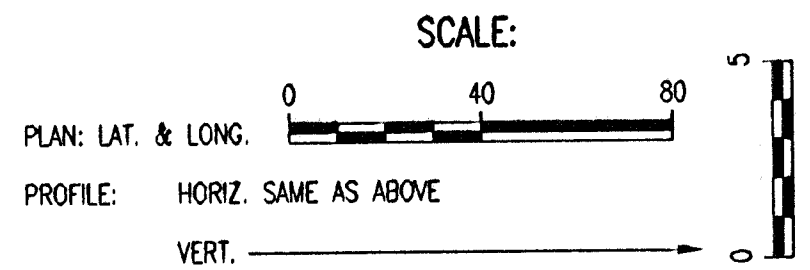

OAK CREEK 3RD - PHASE 1
 PRIVATE SANITARY SEWER EXTENSION
 SANITARY SEWER LINE NO. 4

Professional Engineering Consultants, P.A.
 303 S. TOPEKA • WICHITA, KANSAS 67202
 316-262-2691 • FAX 316-262-3003
 Job No. 35-06572-001-5526
 Date September 2006
 Designed By MDX
 Drawn By JAW