



BENCHMARKS:
Maize Road and 21st Street North, City of
Wichita Benchmark Disc on the Southeast
Corner of Intersection. 64' East and 99'
South of Centerline both.
Elevation = 164.30 (per City record)

"□" Cut in Centerline Headwall of R.C.B.C.,
East side of Maize Road. 600' +/- South
of 21st Street North
Elevation = 164.93 (City Datum)

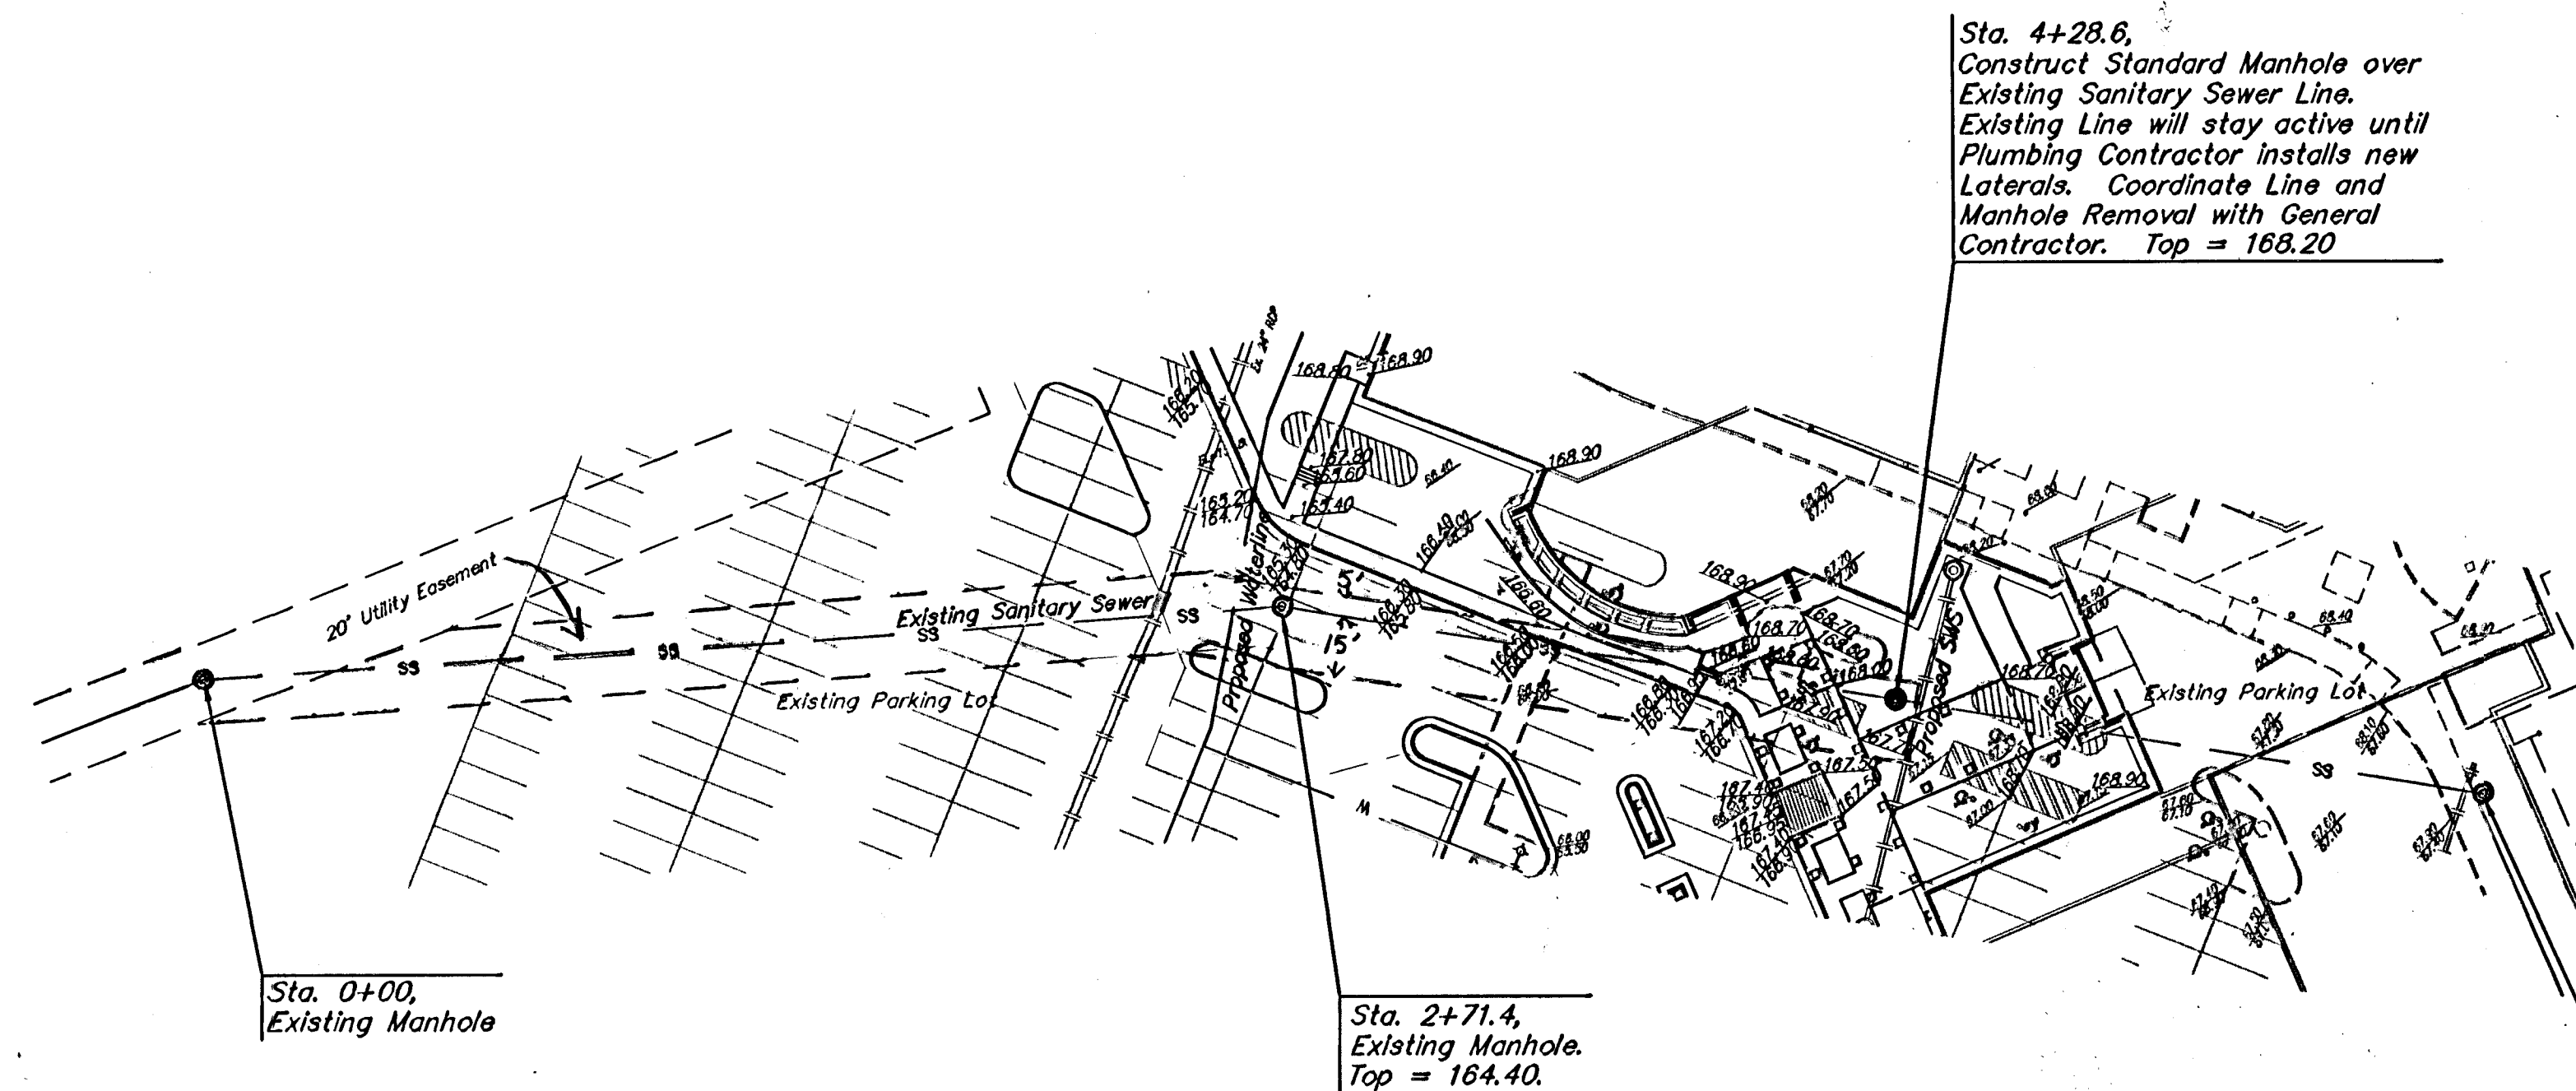

Note: 99' easement from
Sta. 4+32.6 to southeasterly
and to be vacated.
Book P, Page 217 amended.

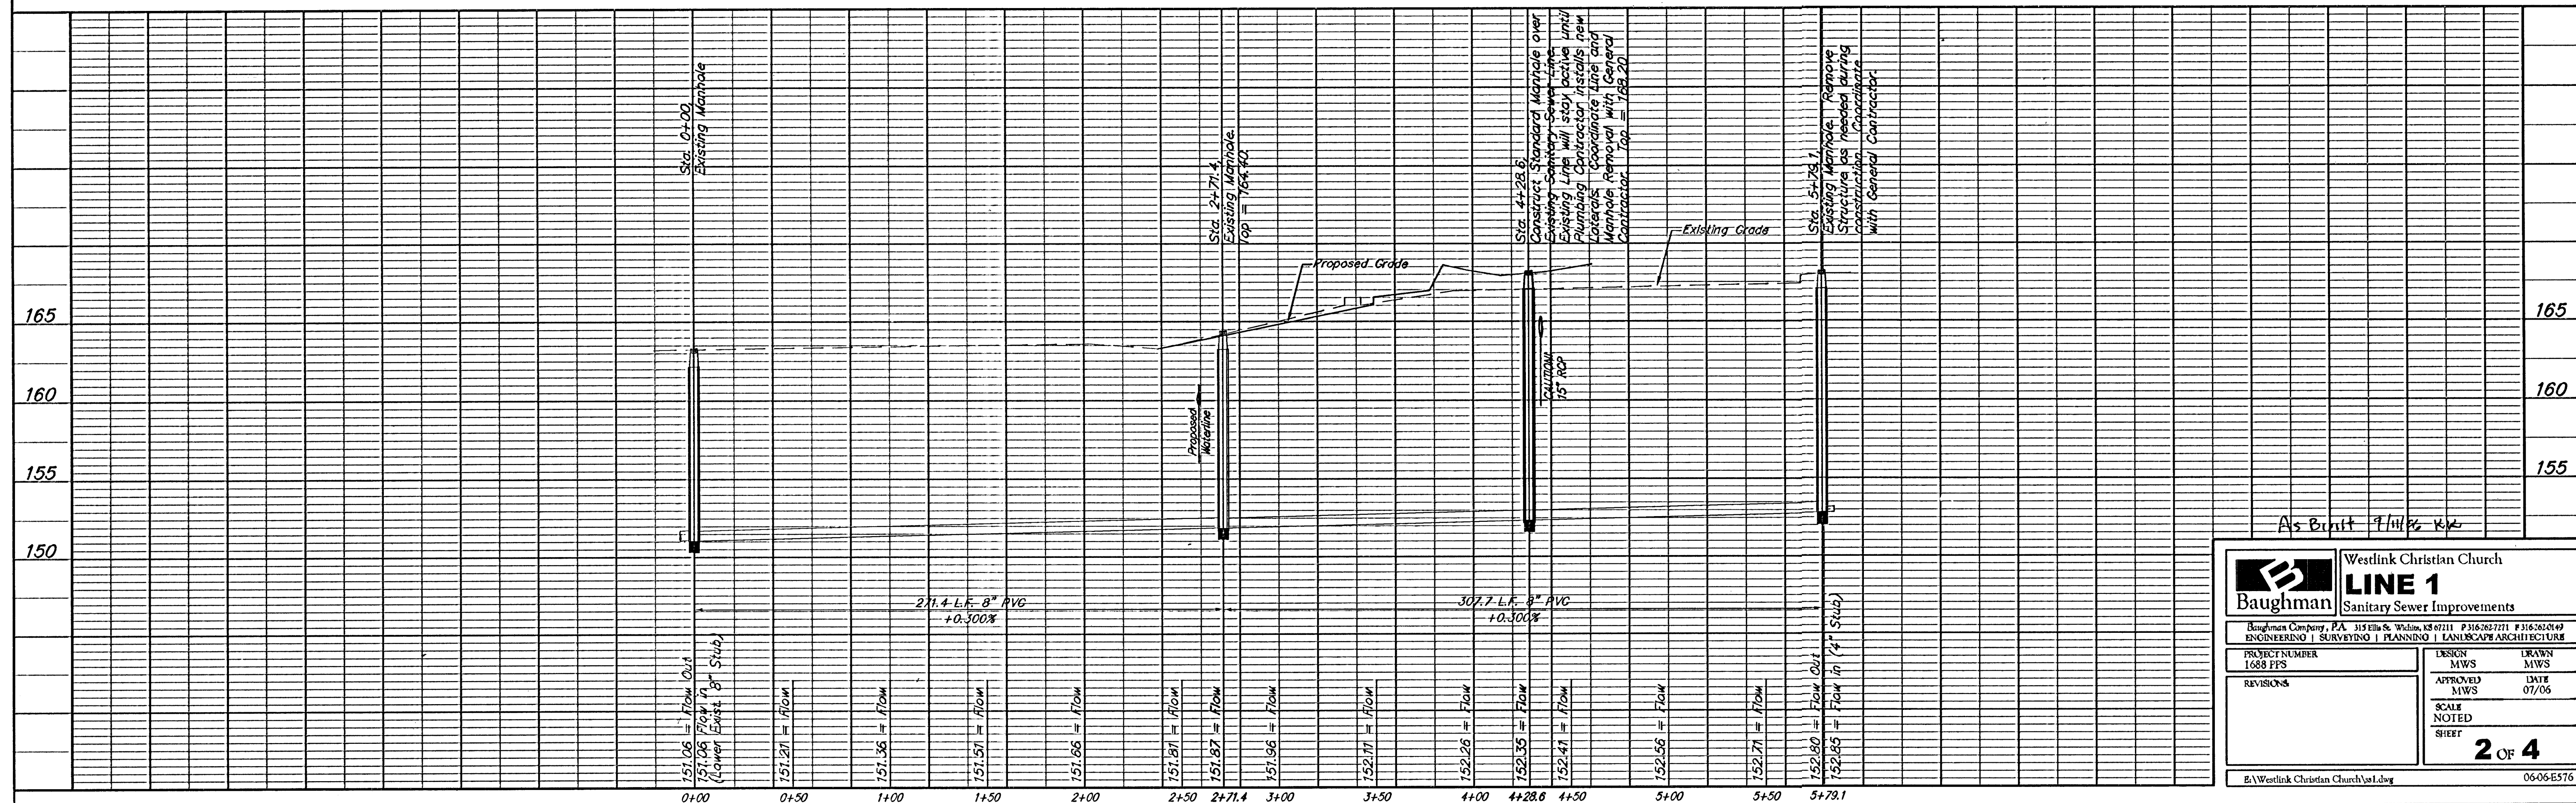

As Buit 9/11/20 KLP

Baughman		Westlink Christian Church	
LINE 1		Sanitary Sewer Improvements	
PROJECT NUMBER 1688 EFS		DESIGN MWS	DRAWN MWS
REVISIONS		APPROVED MWS	DATE 07/06
		SCALE NOTED	SHEET 2 OF 4
E:\Westlink Christian Church\1.dwg		06-06-E576	