
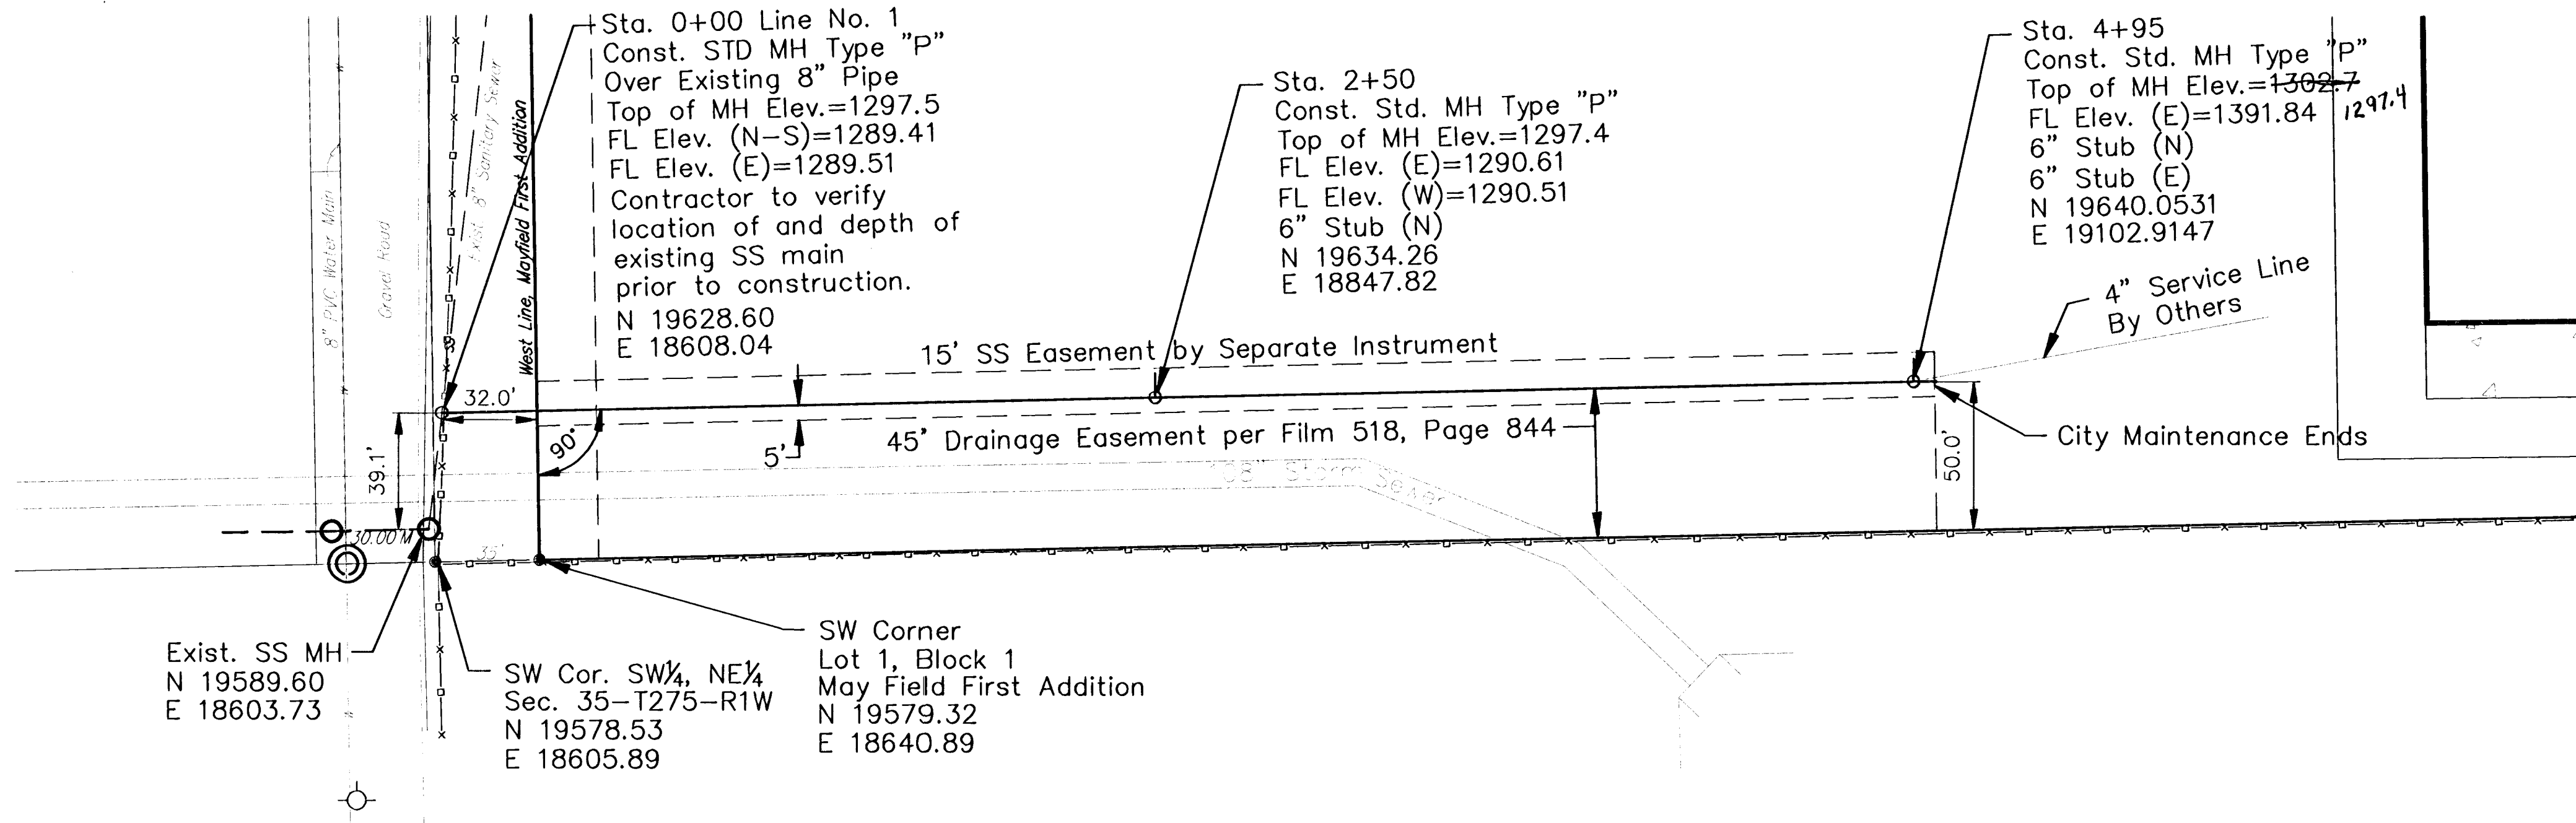


LINE NO. 1

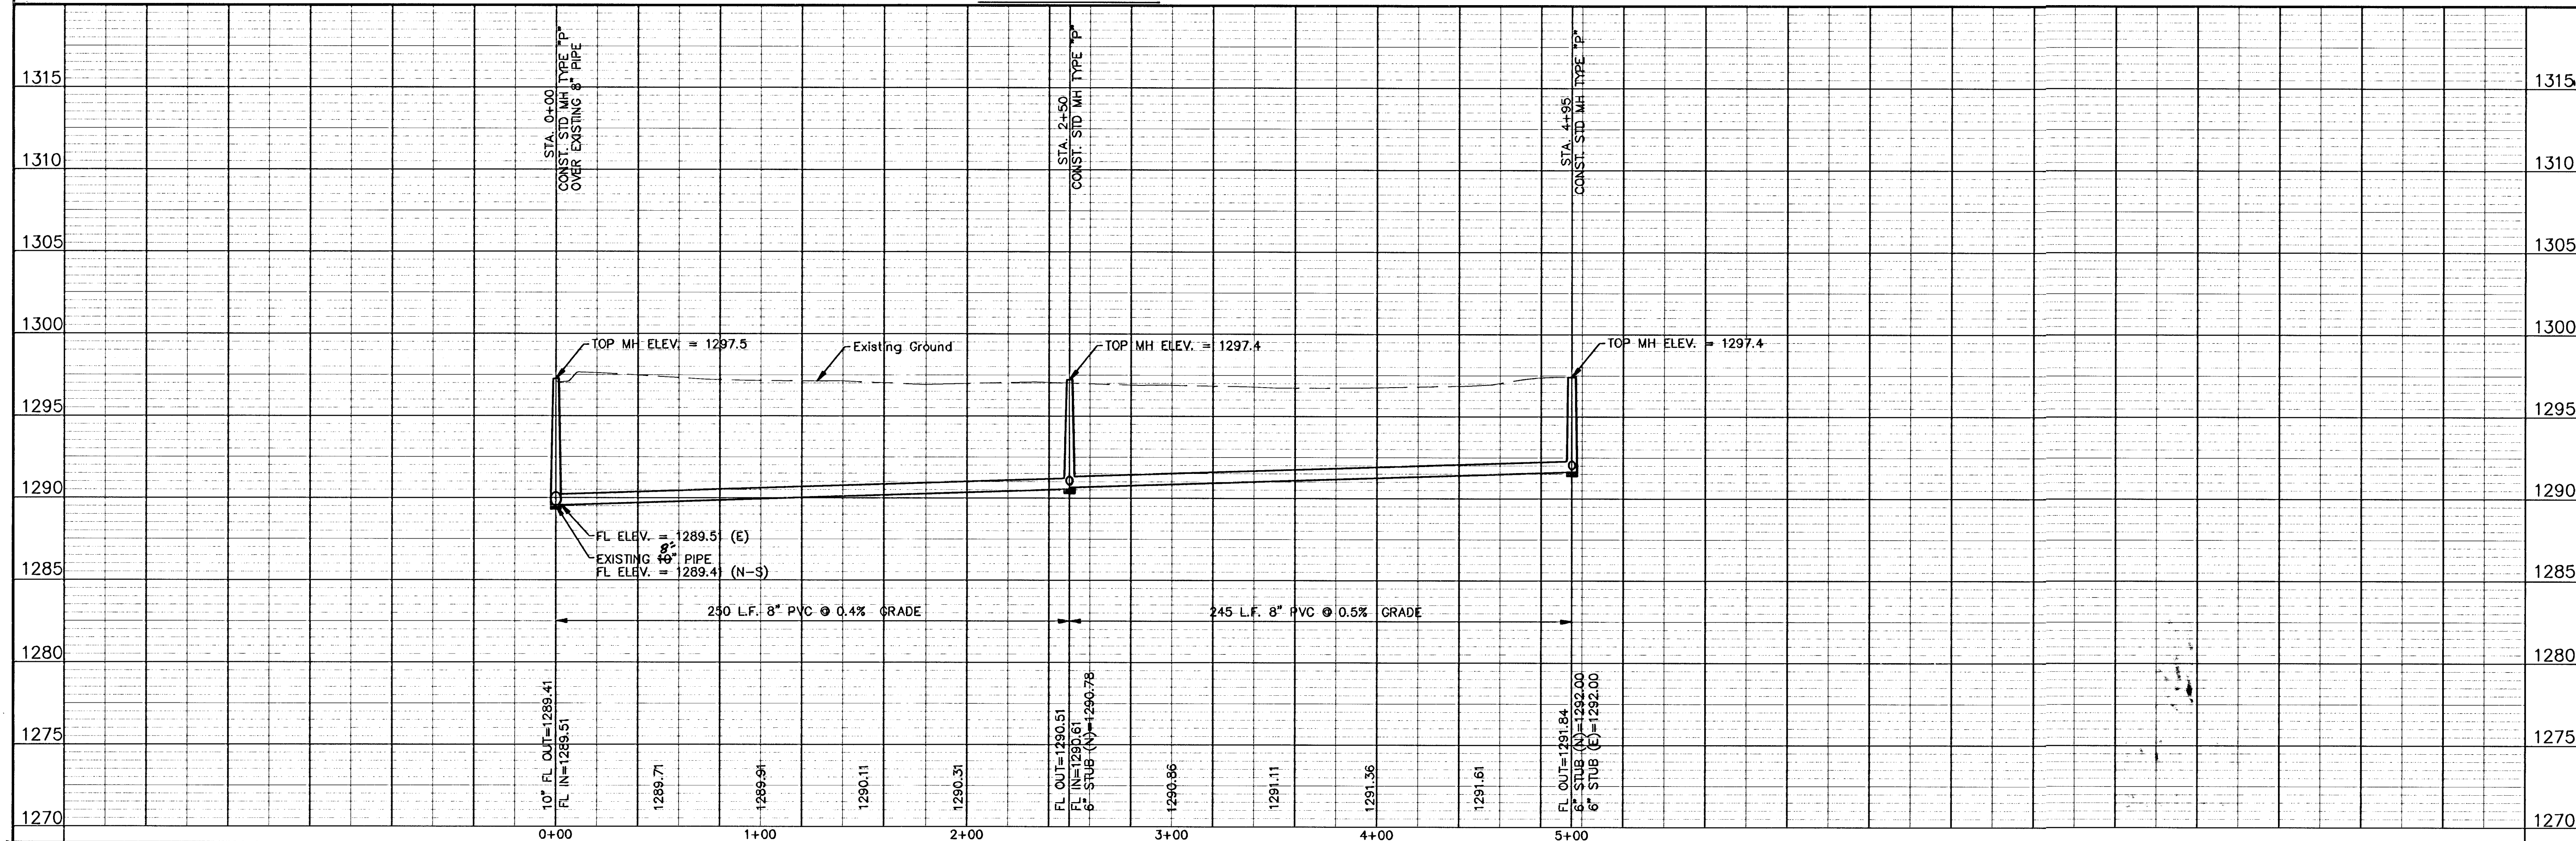

MAY FIELD FIRST ADDITION SANITARY SEWER IMPROVEMENTS SEWERLINE NO. 1 CITY OF WICHITA, KANSAS JAMES ARNDT, P.E. - CITY ENGINEER 1677 PPS (607861)			
POE & ASSOCIATES, INC. CONSULTING ENGINEERS 5940 E. Central, Suite 200 ■ Wichita, KS 67208-4242 Phone 316/685-4114 ■ FAX 316/685-4444			
FINAL			
Designed By: T. Austin/S. Schmidt Drawn By: M. Myers Poe Job No.: 815\pase-ss.dwg Date: June 2006			
2 of 5			