



40' AWAY  
from buildings.

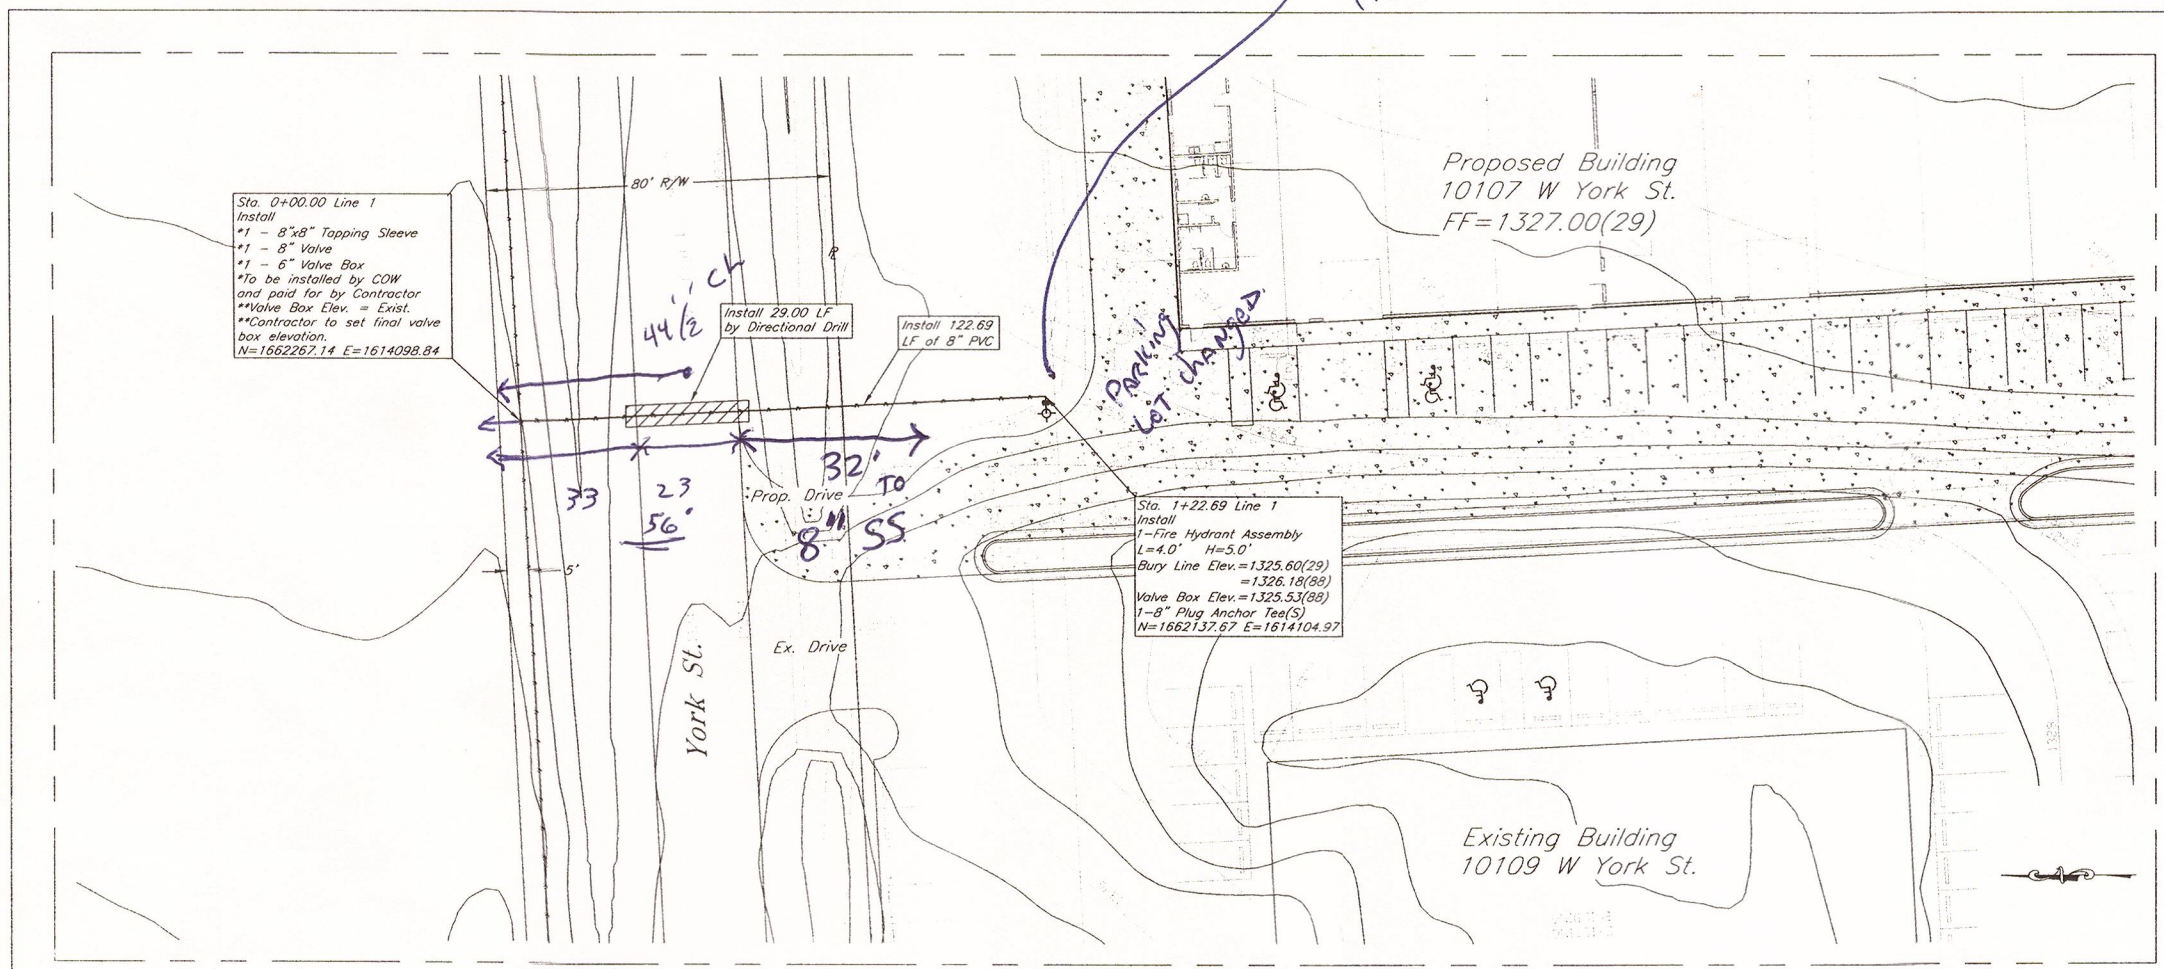


Note:  
Contractor to verify the existing water  
line location.

2 1/2' 5'  
82' from Valve  
87' from Valve TOP

56  
76  
132

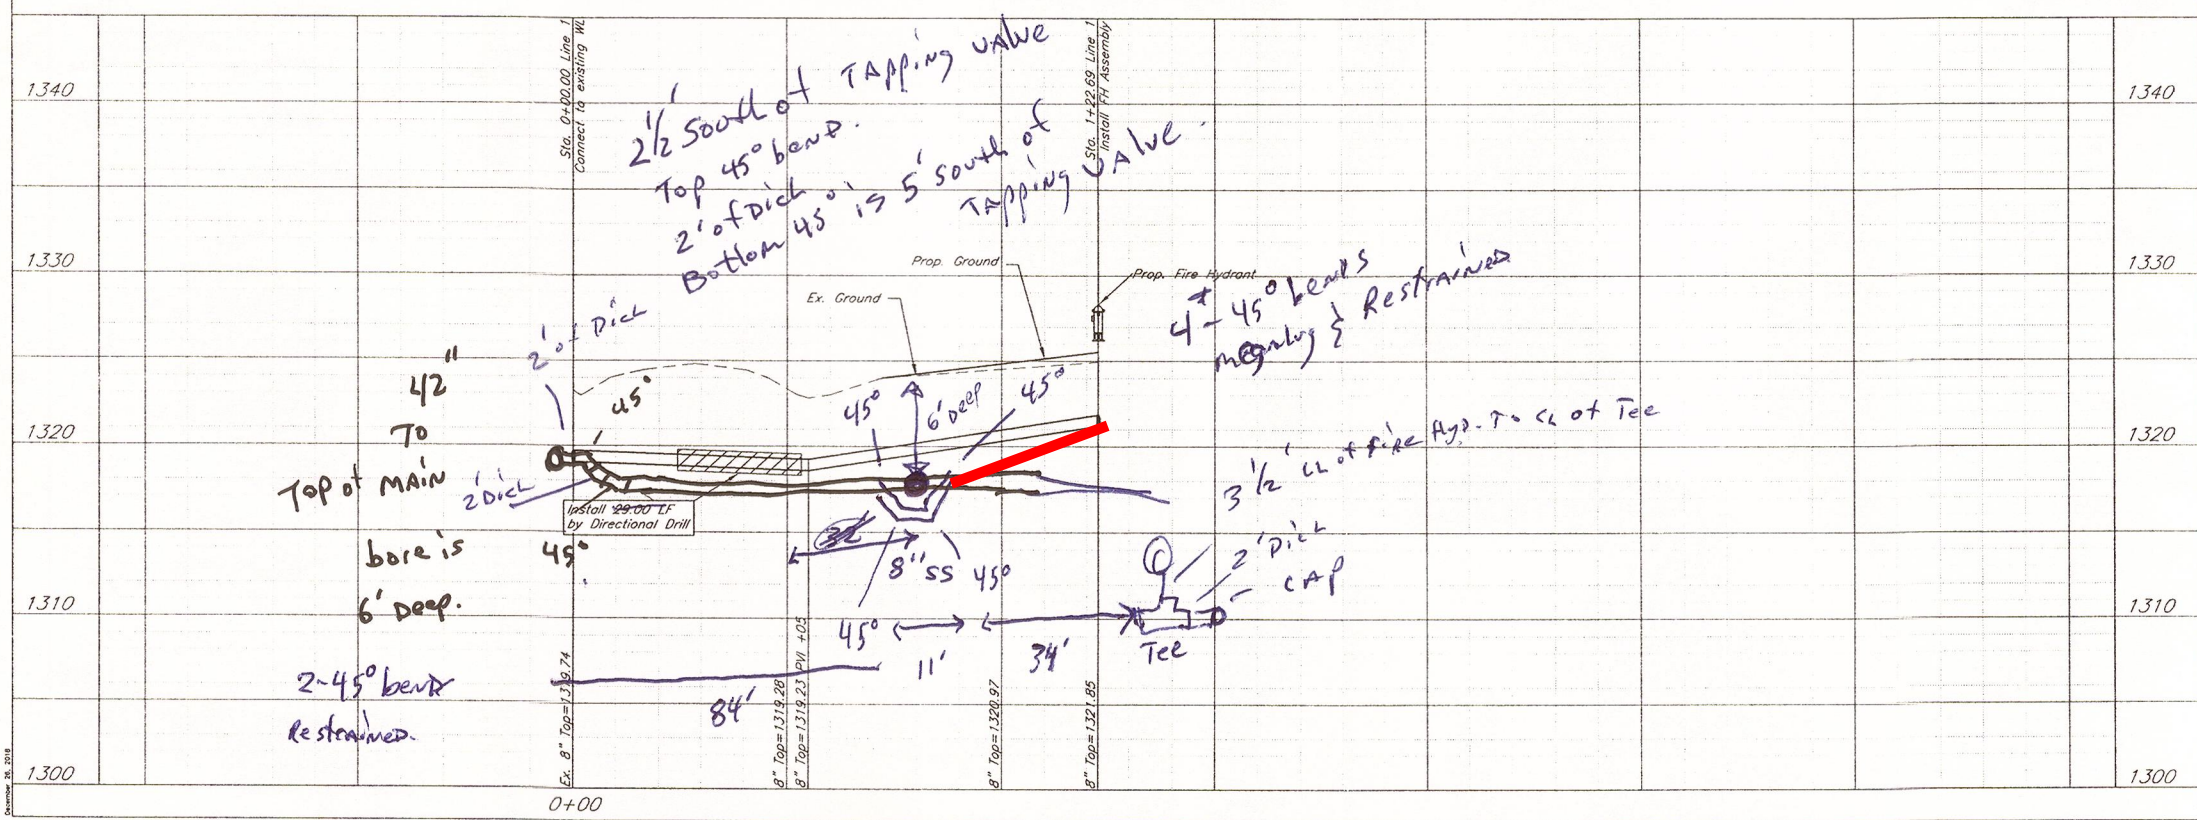

DATE: 12.26.2018  
THIS SHEET HAS BEEN  
SIGNED, SEALED AND  
DATED ELECTRONICALLY

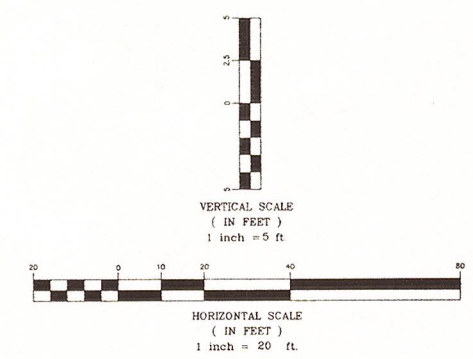

10107 W York St.  
Plan and Profile Line 1  
Wichita, Kansas

<b>KEMILLER</b> ENGINEERING PA 117 E. Lewis, Wichita, KS 67202 (316)264-0242	PROJECT NUMBER 2175 PPW (183021)			SHEET <b>2.0</b>
	KEM NO. 18129 DESIGN KM	FILE DRAWN AHS	DATE 12/2018 REVISED	

56  
32  
88  
82' of C-900R.