

STORM WATER SEWER



Point Table			
Point #	Northing	Easting	Raw Description
7000	1682370.12	1593681.85	0+00
7001	1682347.59	1593635.31	0+51.7
7002	1682337.78	1593461.77	2+25.5
7003	1682340.57	1593285.42	4+01.9
7004	1682335.61	1593120.45	5+66.9
7005	1682333.79	1592955.43	7+32.0
7006	1682608.32	1593281.77	2+67.9
7007	1682727.06	1593281.77	3+86.6
7008	1682768.39	1593279.30	4+27.9
7009	1682804.60	1593256.21	4+70.9
7010	1682457.69	1593883.88	0+00
7011	1682633.47	1593867.60	1+76.5
7012	1682674.66	1593864.10	2+17.9
7013	1682689.63	1593846.57	2+40.9

Point Table			
Point #	Northing	Easting	Raw Description
7014	1682817.45	1593843.98	3+68.8
7015	1682821.70	1593876.19	4+01.3
7016	1682982.31	1593854.05	5+63.4
7017	1682608.75	1594425.21	0+00
7018	1682770.20	1594356.32	1+75.5
7019	1682808.22	1594340.09	2+16.9
7020	1682812.95	1594309.55	2+47.8
7021	1682932.51	1594258.52	3+77.8
7022	1682959.85	1594322.58	4+47.4
7023	1683098.11	1594258.47	5+99.8
7024	1682488.02	1594937.17	0+00
7025	1682527.09	1594954.50	0+42.7
7026	1682562.79	1594958.62	0+78.7
7027	1682606.82	1595135.07	2+60.5
7028	1682609.21	1595362.65	4+88.1
7029	1682612.88	1595397.90	5+23.6
7030	1682609.36	1595540.15	6+65.9

Point Table			
Point #	Northing	Easting	Raw Description
7031	1682764.79	1595130.30	1+58.0
7032	1682799.73	1595124.97	1+93.4
7033	1682946.60	1595119.76	3+40.4
7034	1683165.01	1594801.61	0+00
7035	1683170.70	1595123.31	3+21.7
7036	1683174.92	1595355.23	5+53.7
7037	1683132.20	1595396.78	6+13.3
7038	1683134.30	1595531.96	7+48.5
7039	1683351.46	1594711.48	0+00
7040	1683517.57	1594943.44	2+32.0
7041	1683521.20	1595148.41	4+37.0
7042	1683524.47	1595333.38	6+22.0
7043	1683511.50	1595349.92	6+43.0
7044	1683512.15	1595391.25	6+84.4
7045	1683514.25	1595526.04	8+19.2
7046	1683286.18	1594788.66	0+00
7047	1683345.92	1594851.79	0+86.9

Point Table			
Point #	Northing	Easting	Raw Description
7048	1683311.31	1594736.35	0+00
7050	1683399.27	1594719.00	0+89.7
7052	1682884.49	1594728.17	0+00
7053	1682962.54	1594732.44	0+78.2
7054	1682999.01	1594710.88	1+20.5
7055	1683069.28	1594752.84	2+02.4
7056	1682885.01	1594739.01	0+00
7057	1683034.46	1594752.62	1+50.1
7058	1683058.65	1594764.01	1+76.8
7059	1682340.77	1593461.99	cen inside fc
7061	1682728.56	1593280.11	cen inside fc
7062	1682766.89	1593279.33	cen inside fc
7063	1682634.96	1593867.47	cen inside fc
7064	1682673.17	1593864.22	cen inside fc
7065	1682983.79	1593853.84	cen inside fc
7066	1682771.58	1594355.73	cen inside fc
7067	1682806.84	1594340.68	cen inside fc

Point Table			
Point #	Northing	Easting	Raw Description
7068	1683099.49	1594257.88	cen inside fc
7069	1682528.58	1594954.67	cen inside fc
7070	1682560.80	1594958.39	cen inside fc
7071	1682609.47	1595364.13	cen inside fc
7072	1682612.61	1595396.43	cen inside fc
7073	1682766.28	1595130.08	cen inside fc
7074	1682798.25	1595125.20	cen inside fc
7075	1683174.94	1595356.73	cen inside fc
7076	1683132.24	1595395.28	cen inside fc
7077	1683511.53	1595351.41	cen inside fc
7078	1683512.12	1595389.75	cen inside fc
7079	1683345.95	1594853.29	cen inside fc
7080	1682963.83	1594731.68	cen inside fc
7081	1682996.86	1594712.15	cen inside fc

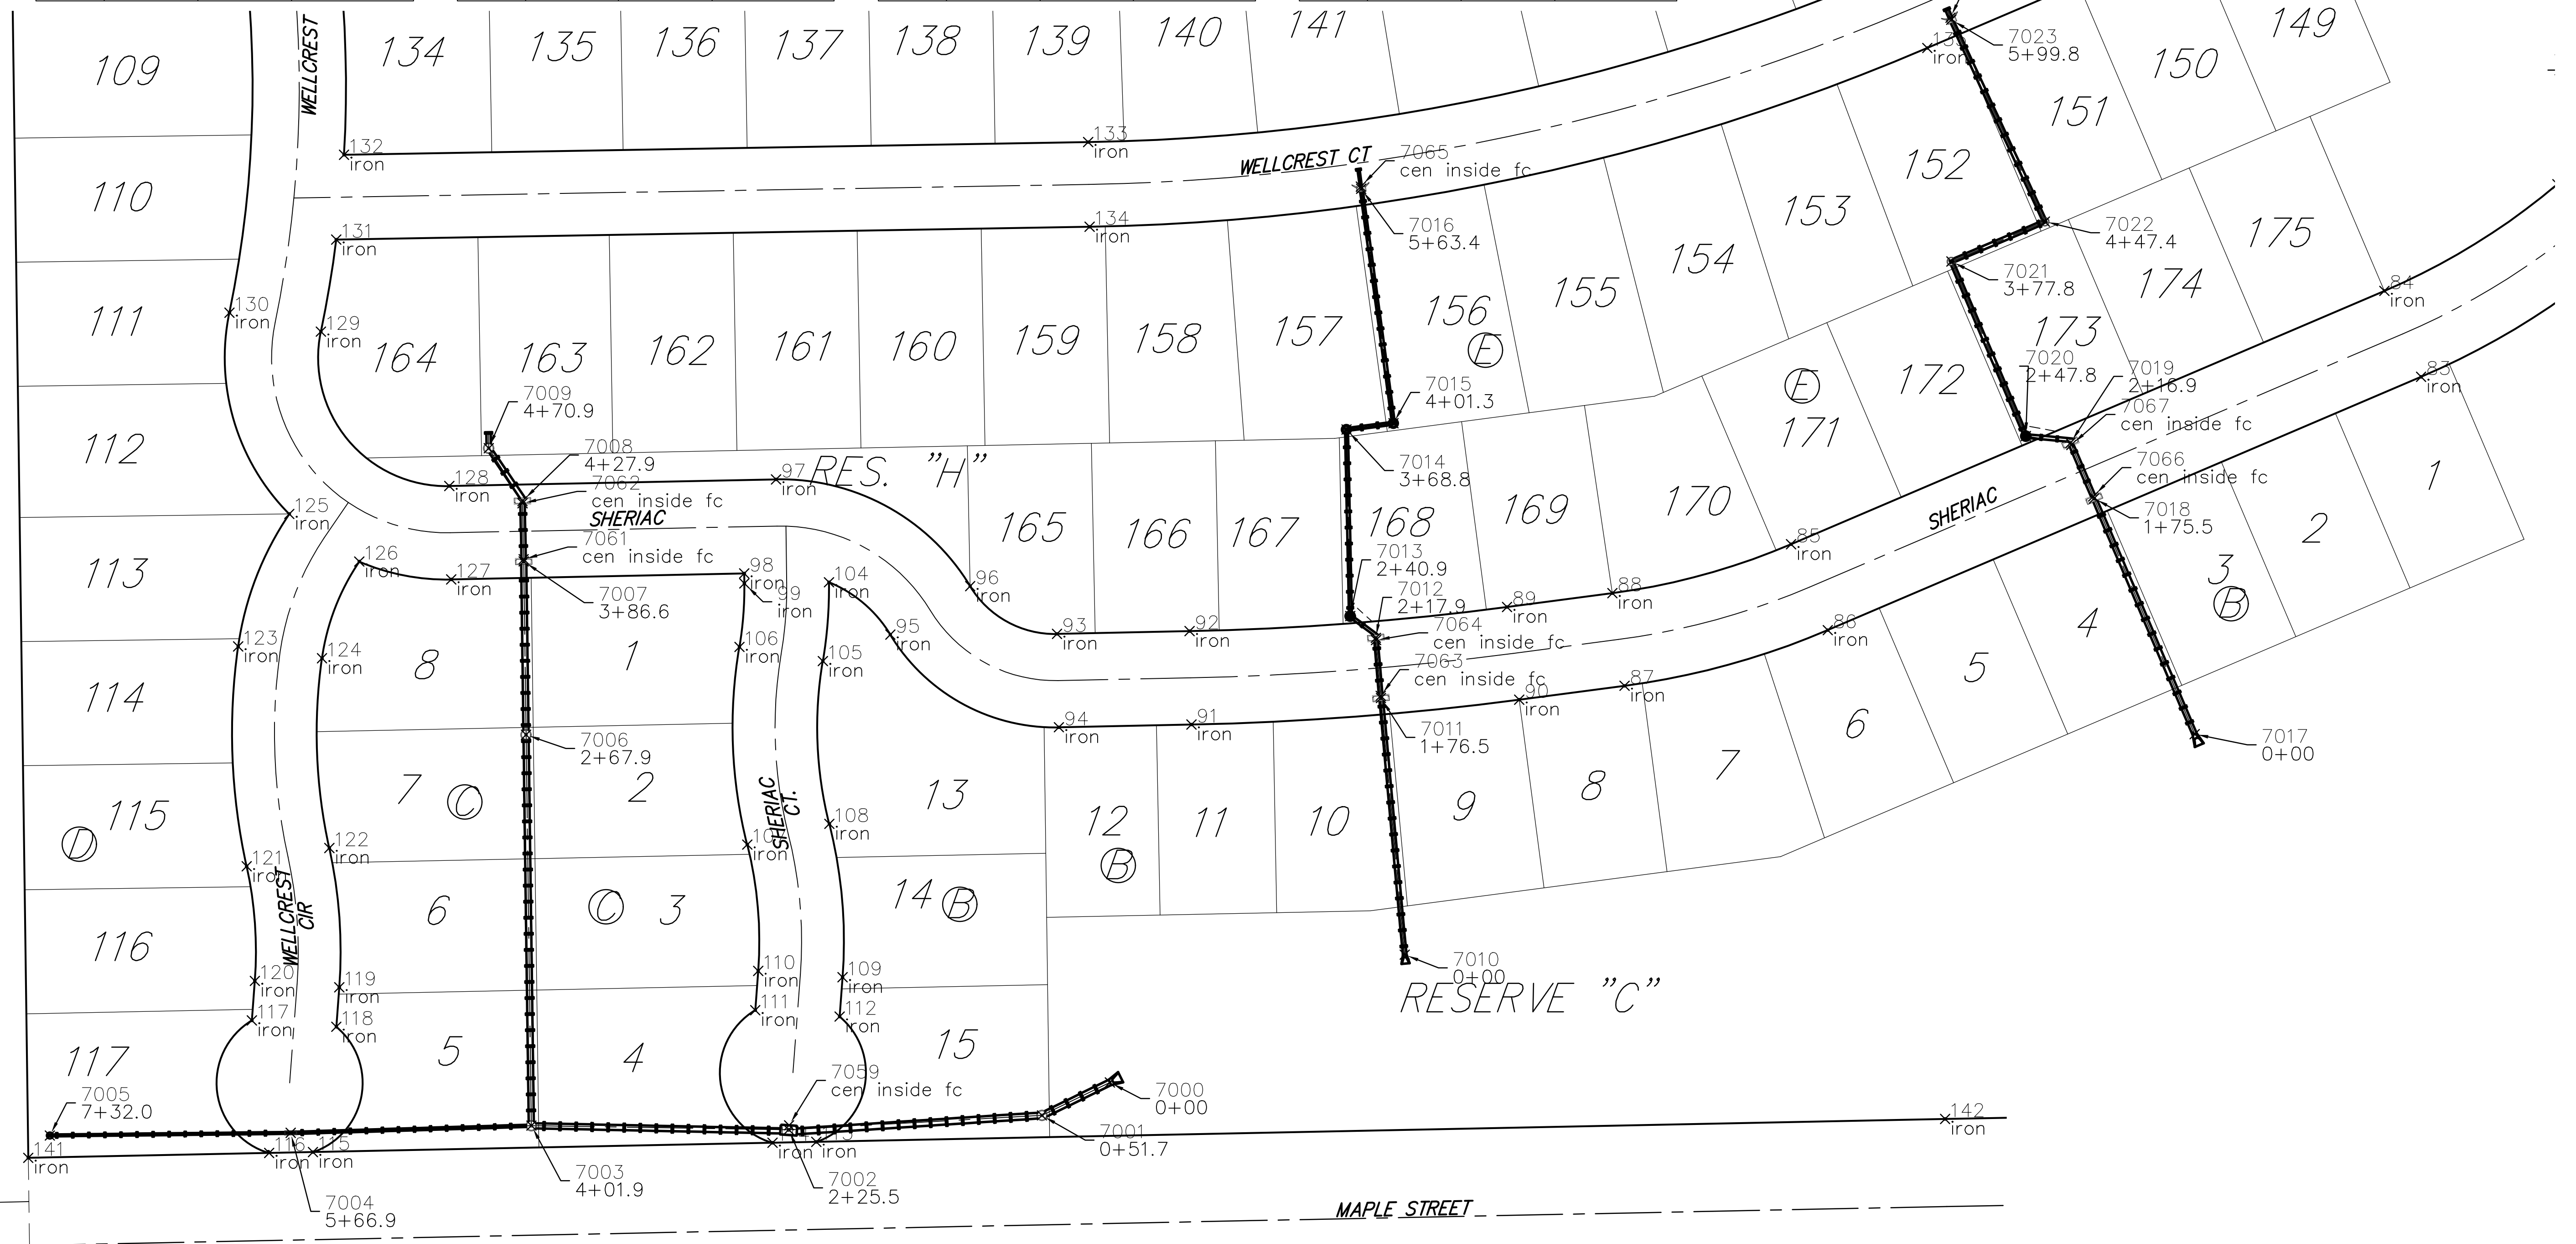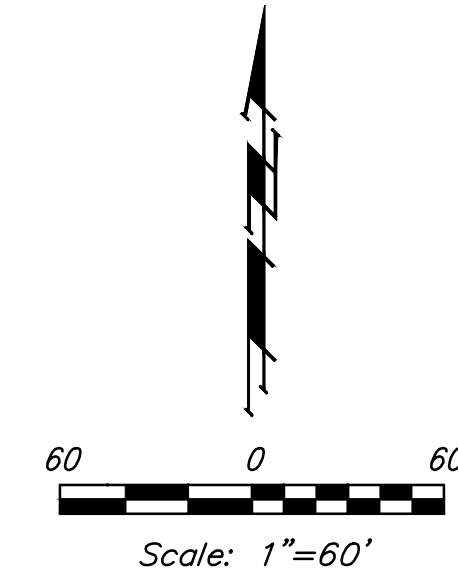

**Baughman Company, P.A.**  
 ENGINEERING | SURVEYING | PLANNING | LANDSCAPE ARCHITECTURE  
 Baughman

PIKE ADDITION  
**STAKING PLAN**  
 STORM WATER DRAIN IMPROVEMENTS